


PLAT OF SURVEY

OF LOT 96 OF LAKE GENEVA BEACH SUBDIVISION, A SUBDIVISION
LOCATED IN GOVERNMENT LOT 4 IN THE S.W. FRACTIONAL 1/4 OF SECTION
11, T1N, R17E, TOWN OF LINN, WALWORTH COUNTY, WISCONSIN.


JENSEN SURVEYING & MAPPING S.C.
P.O. Box 322
Elkhorn, Wisconsin - 53121

SURVEYED FOR: Mary Martino
372 Geneva St. Williams Bay WI.
53191
MAPPING DATE: April 24, 1985

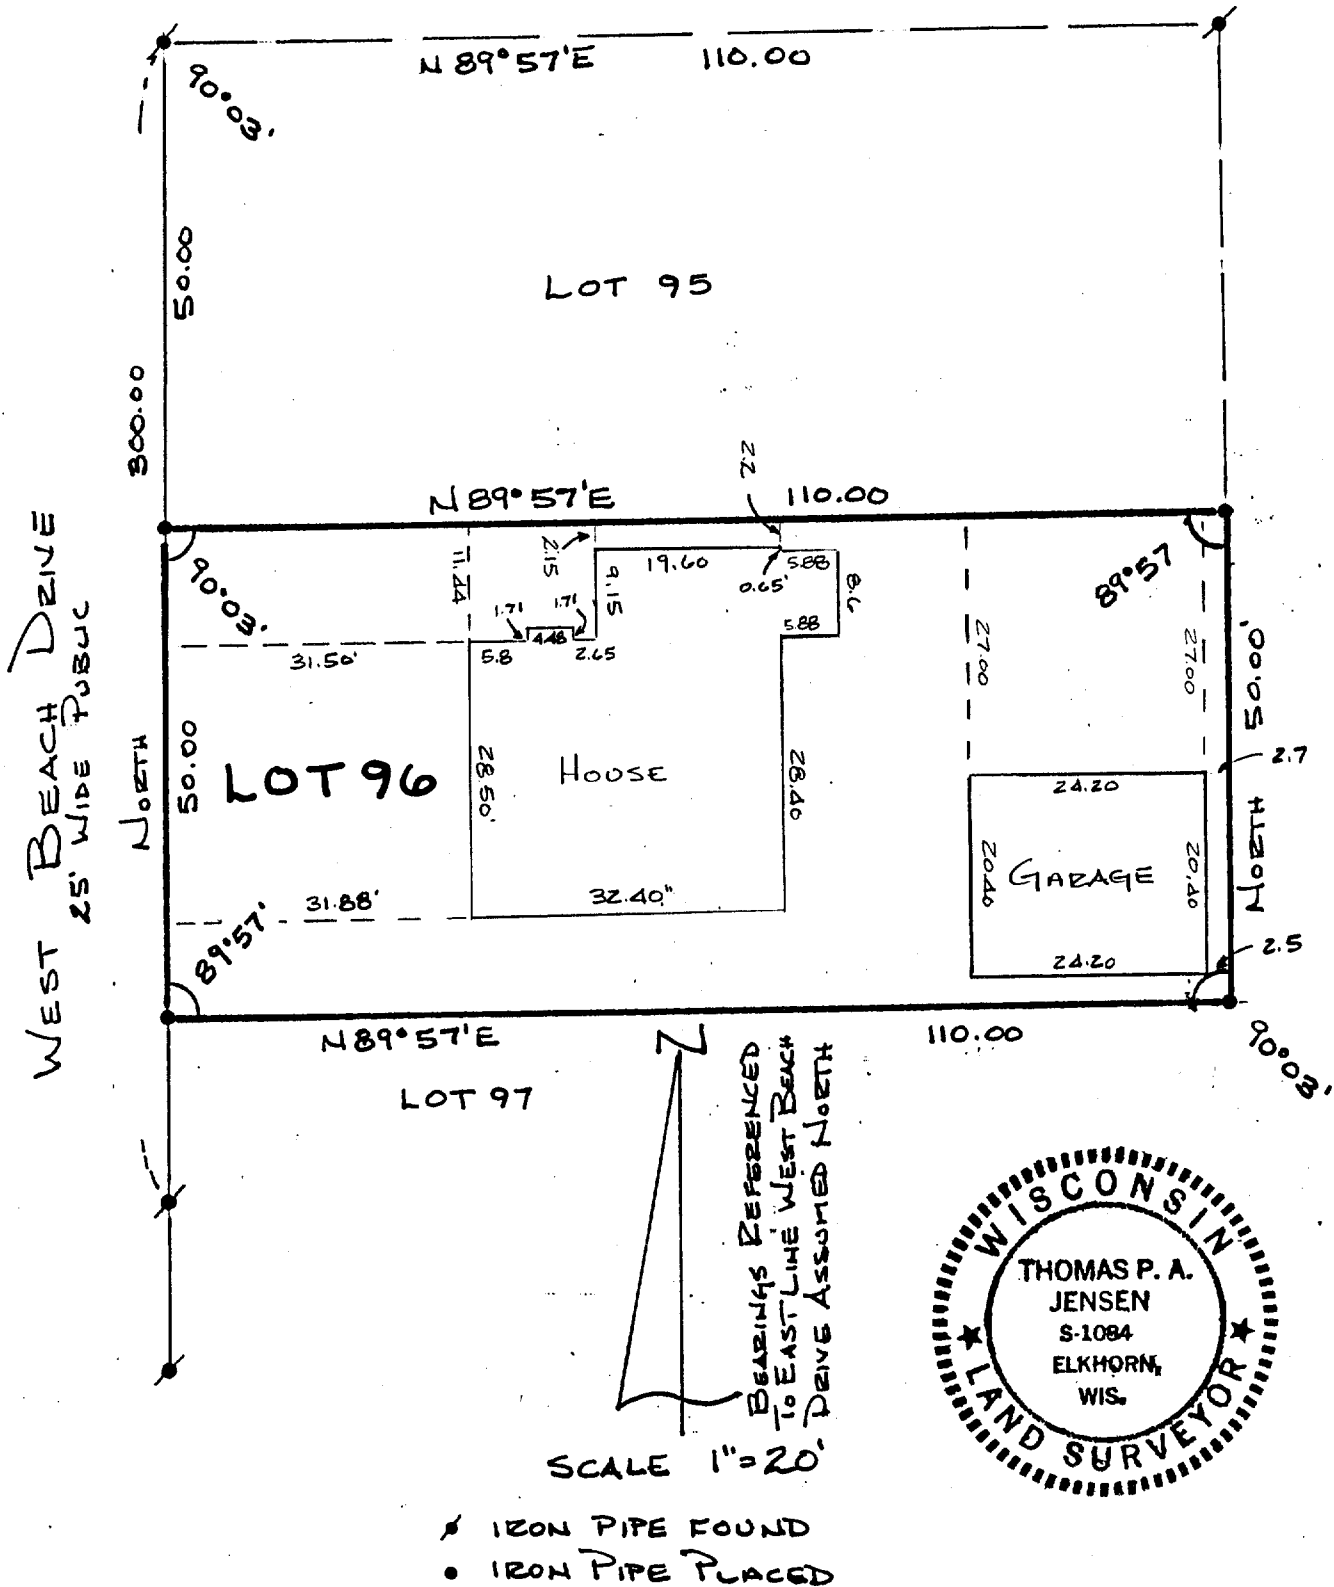

I, Thomas P.A. Jensen, Wisconsin Registered Land Surveyor,
do hereby certify that this survey was performed by me, or under
my direction, in full compliance with the owner's/ agent's
instructions and chapter A-E 5 of the Wisconsin Administrative
Code " Minimum Standards for Property Surveys"; and that this
map is an accurate representation thereof to the best of my
knowledge and belief.

Thomas P.A. Jensen
Thomas P.A. Jensen R.L.S. # 1084

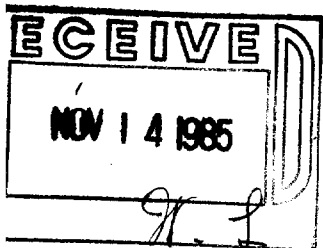

117-702-J
1985.023