
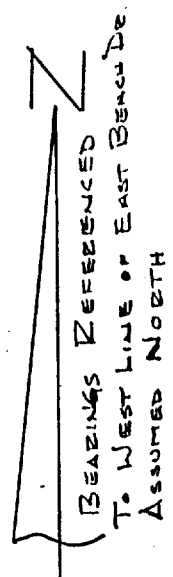


PLAT OF SURVEY OF LOT 84 OF ROBINSON'S SECOND SUBDIVISION LOCATED IN SECTIONS 11 and 14, T1N, R17E, WALWORTH COUNTY, WISCONSIN.

SURVEYED FOR: Robert Silverstein
3837 Chester Dr.
Glenview, Ill. 60025

JENSEN SURVEYING & MAPPING S.C.
P.O. Box 322
Elkhorn, Wis. 53121



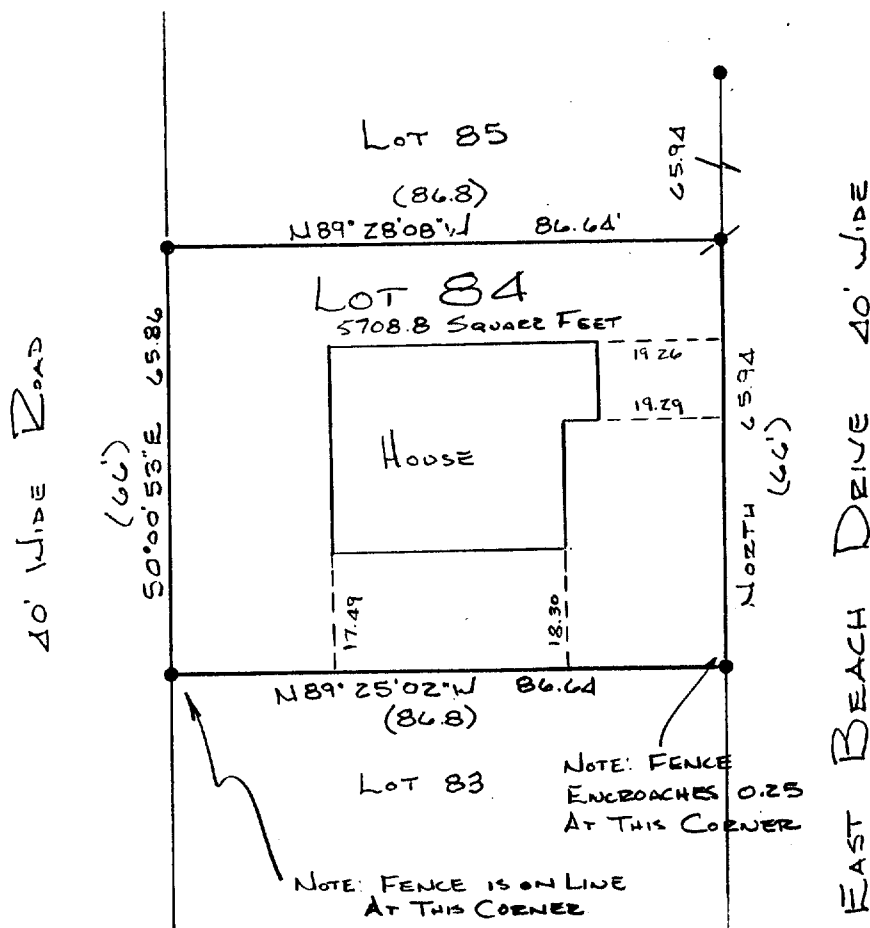


SCALE 1"=40'

- IRON PIPE SET
- IRON PIPE FOUND

I, Thomas P.A. Jensen, Wisconsin Registered Land Surveyor, do hereby certify that this survey was performed by me, or under my direction in full compliance with the owner's/ agent's instructions and Chapter AE-5 of the Wisconsin Administrative Code " Minimum Standards for Property Surveys"; and that this map is an accurate representation thereof to the best of my knowledge and belief.

Thomas P.A. Jensen
Thomas P.A. Jensen R.L.S.1084
Mapping Date: 1/24/85

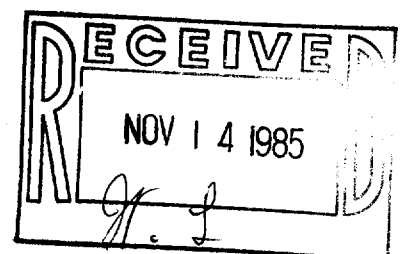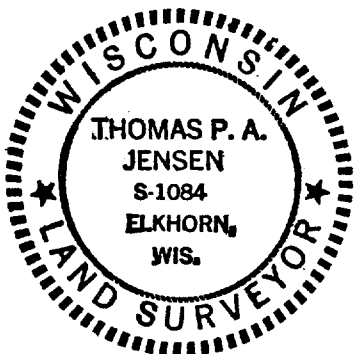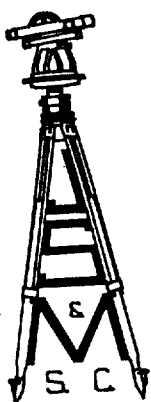

117-703-J
1985 085