


RECEIVED
AUG 19 1986
JH. S



George F. Dunham, Surveyor

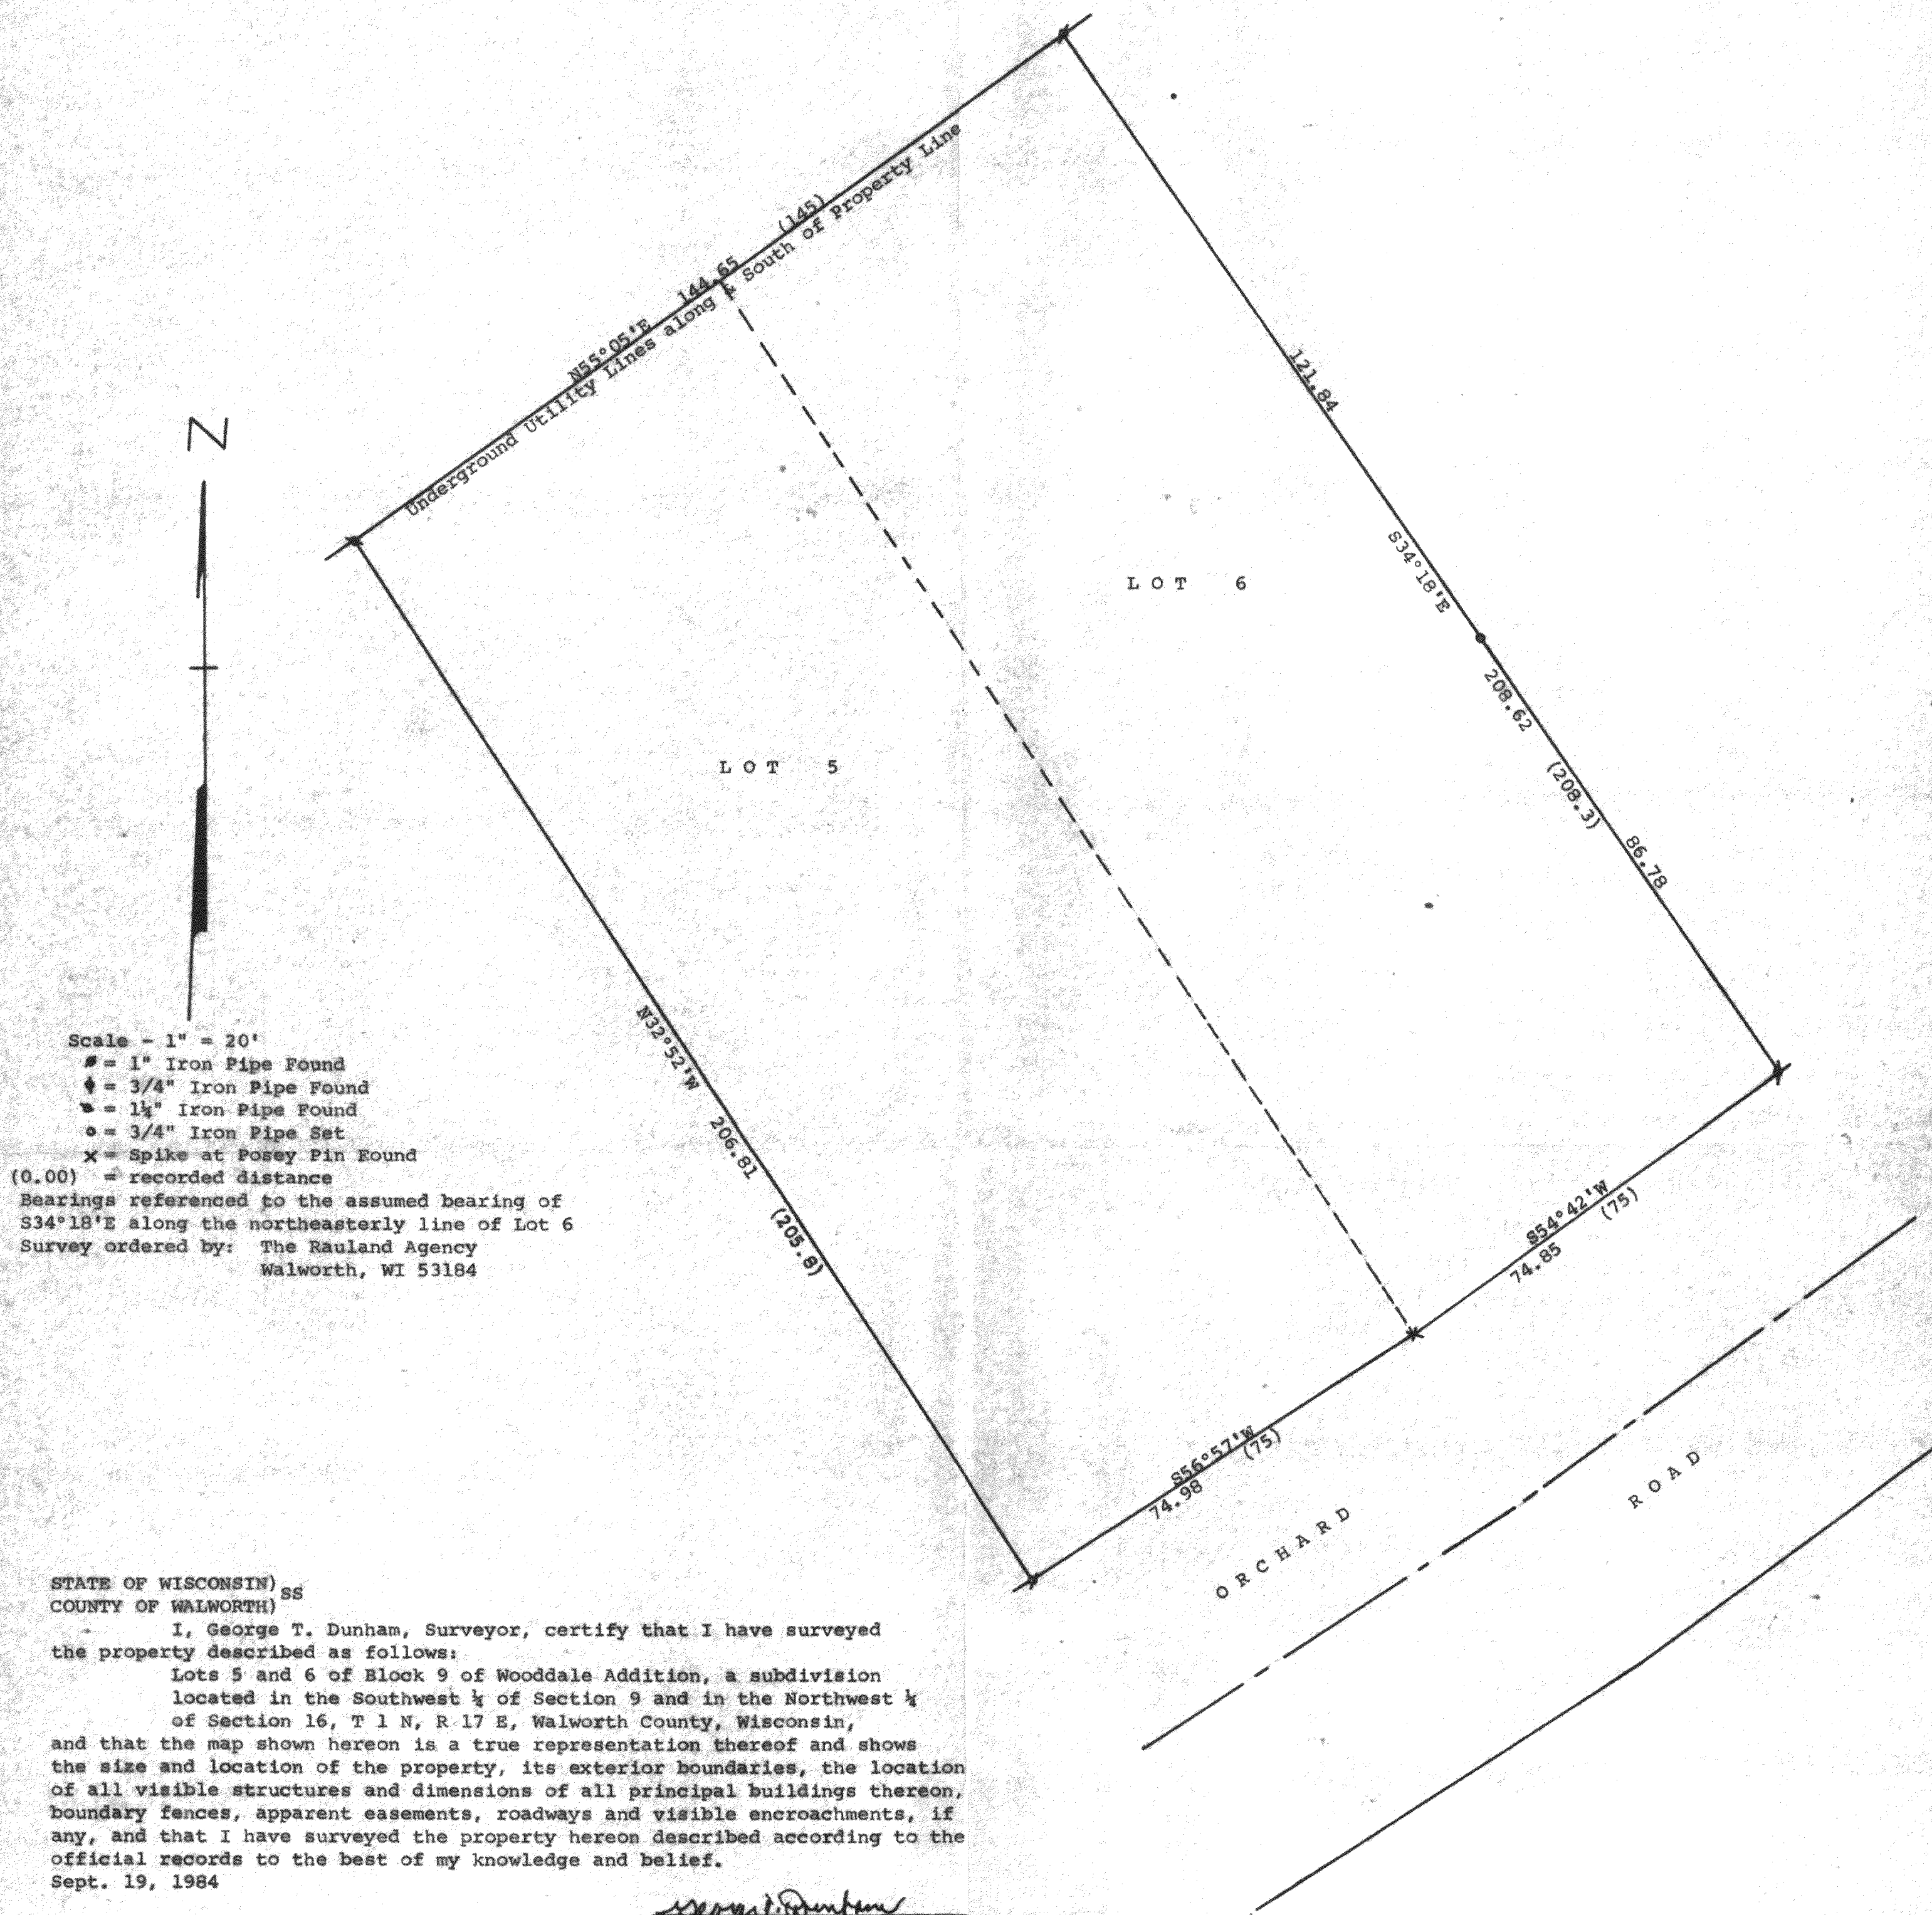