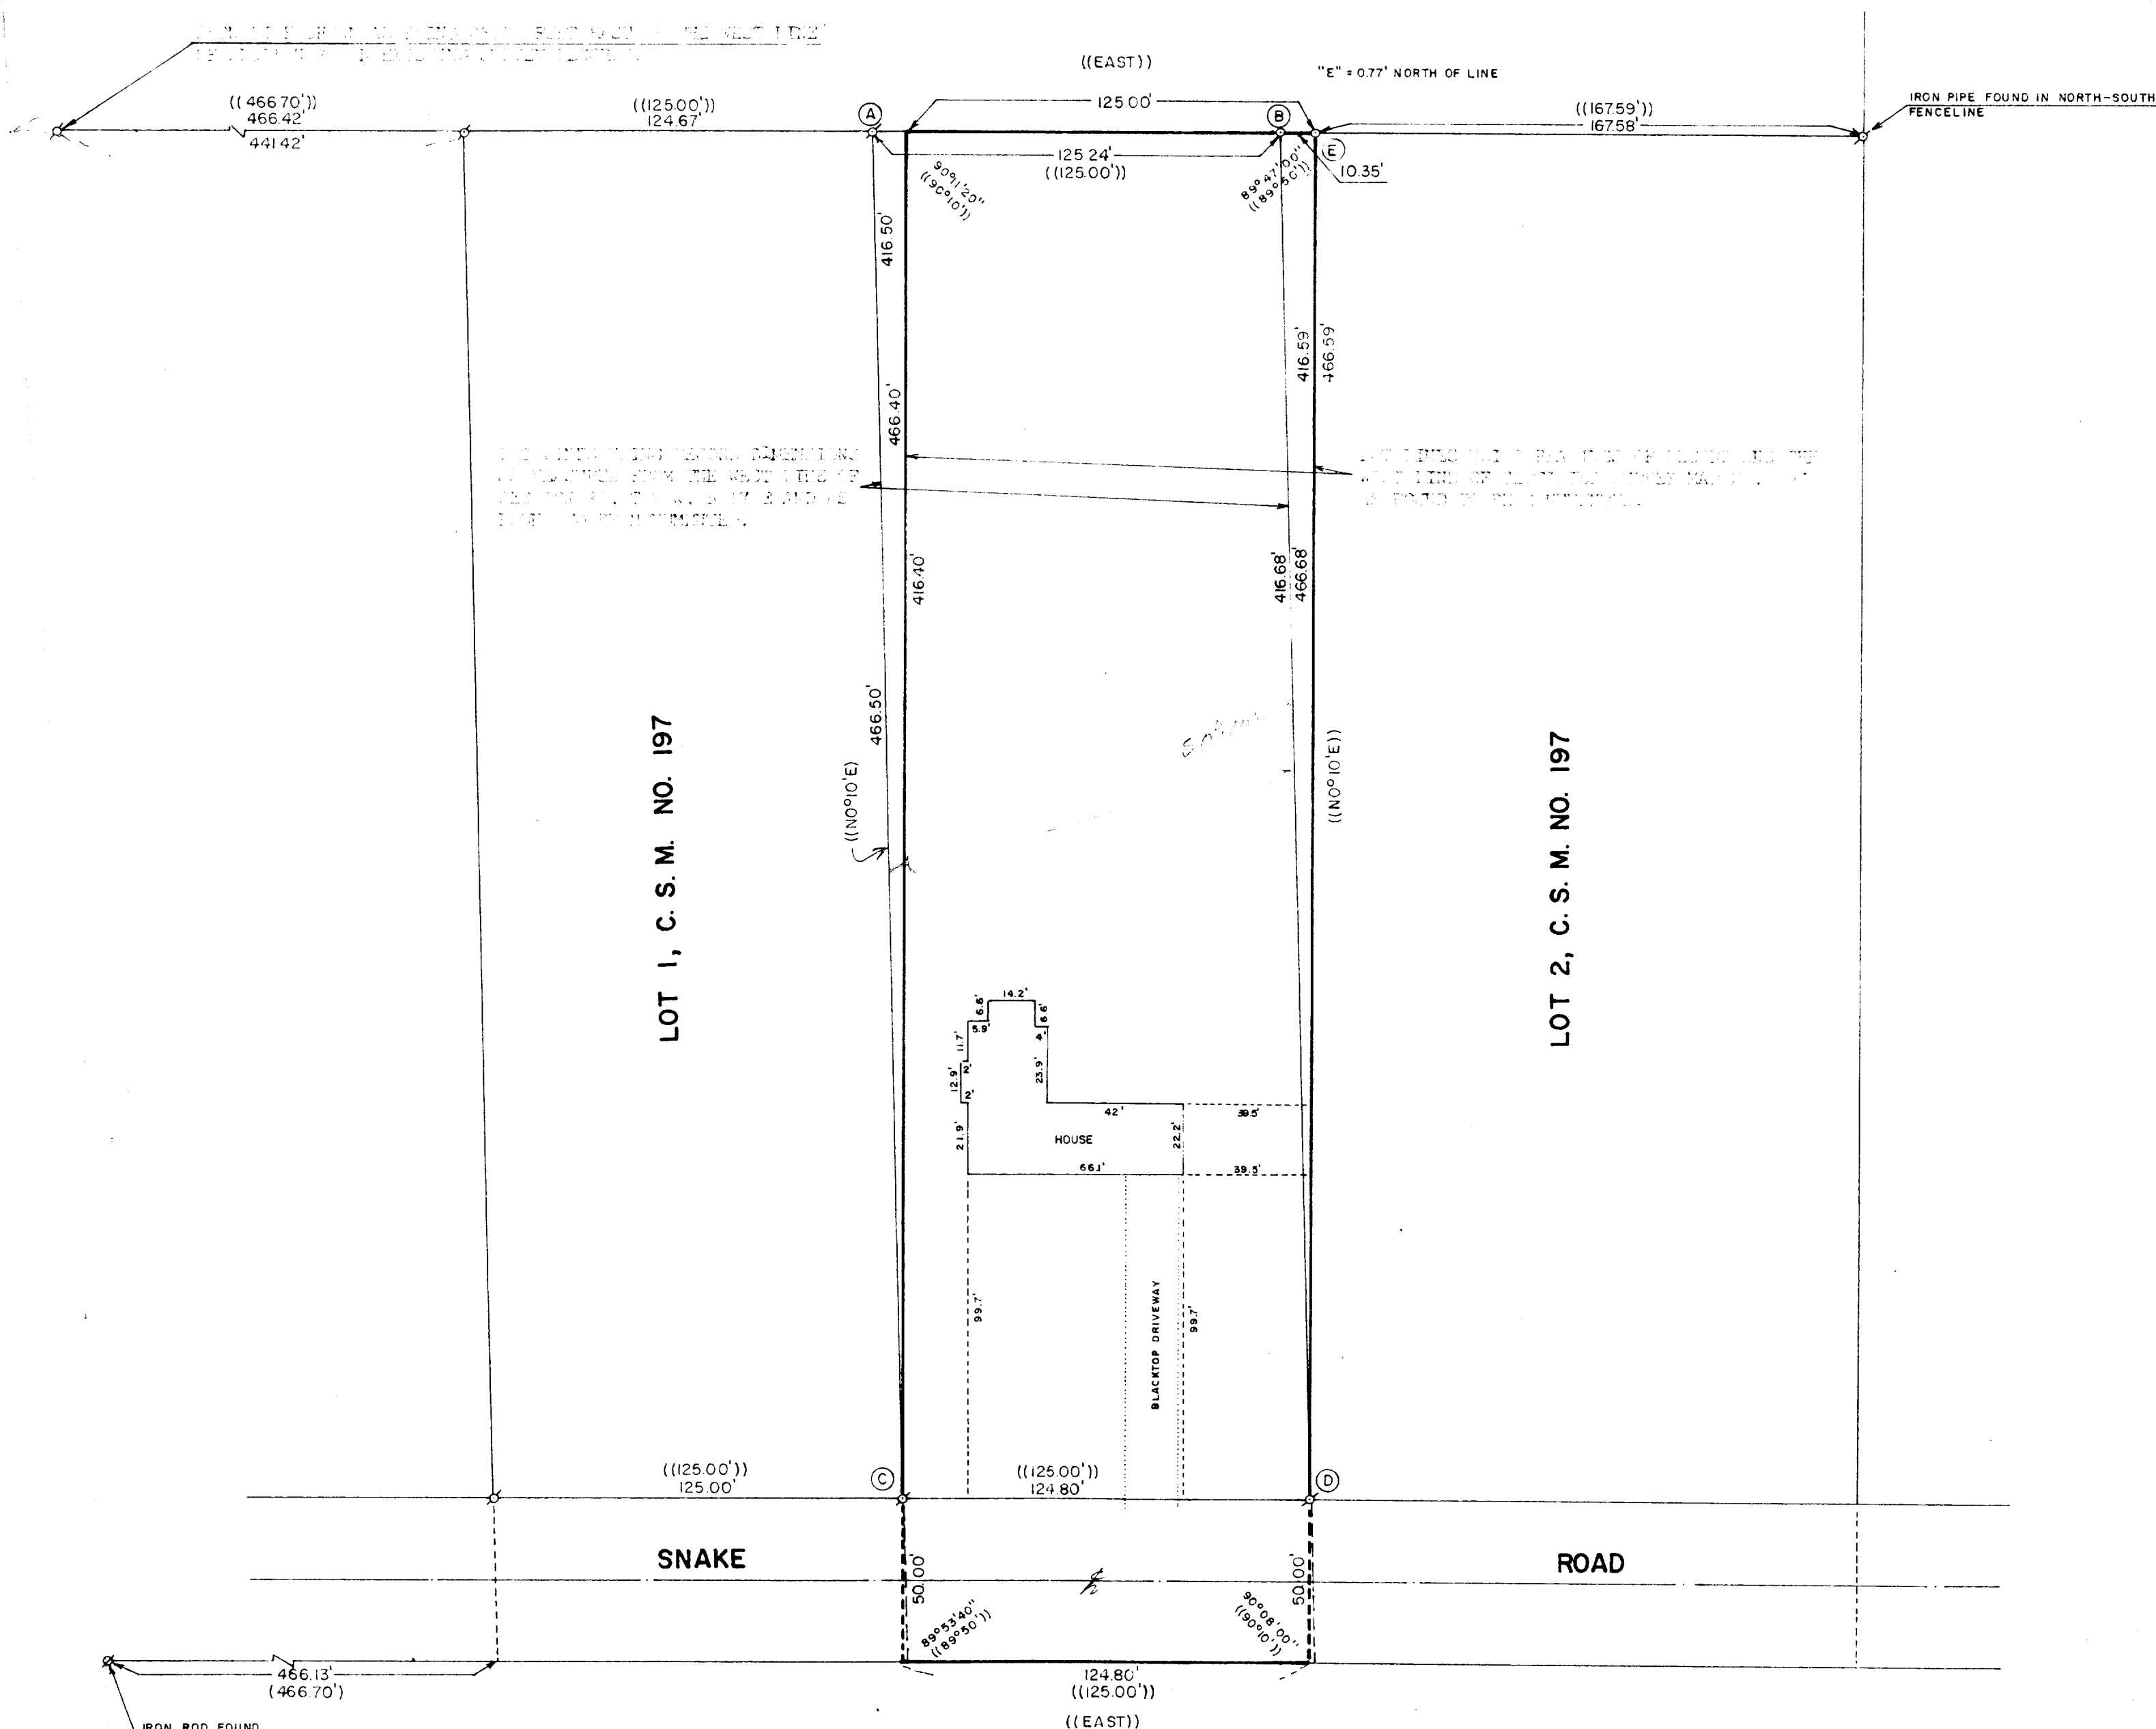


[illegible]

IRON AND PORTLAND CEMENT WEST HILLS CO. GEORGETOWN, N.C.

PLAT OF SURVEY OF

2. PARCEL OF LAND LOCATED IN THE NORTHWEST 1/4 OF THE NORTHWEST 1/4 OF SECTION 3, T. 1 N., R. 7 E., WAPOKA COUNTY, WISCONSIN, DESCRIBED AS FOLLOWS: BEGINNING AT THE NORTHWEST CORNER OF SAID SEC. 3, THENCE S64°00'00"E 88.00 FEET; THENCE EAST 50.00 FEET TO THE POINT OF BEGINNING; THENCE S64°00'00"E 1/4 MILE; THENCE EAST 125.00 FEET; THENCE N64°00'00"E 1/4 MILE; THENCE WEST 125.00 FEET TO THE POINT OF BEGINNING.

ORDERED BY: GOLDWELL, WYNNE-CLIFF, JAMES AREA HAWTONE
803 MAIN STREET
LAKE CHARLE, VIRGINIA 22083



ϕ - 100% (100% P-100)
 ϕ - 100% (100% P-100)
 ϕ - 100% (100% P-100)
 (100% P-100) (100% P-100)

I, ROBERT M. WICKSTADT, of the County of Jersey, State of New Jersey, do hereby certify that I have reviewed the previously stated charges against the principal subjects and that the filed herein is a correct representation of the previous lines to the best of my knowledge and belief.

Robert M. Braunwald
Robert M. Braunwald
FIVE FOUR FIFTEEN LIND AVENUE, S-1005

Aug. 28, 1986