

PLAT OF SURVEY

OF

LOT 8-9 EDGEWATER
TERRACE SUB.
SW 1/4 SEC. 9, T.1N,
R.17E, WALWORTH
COUNTY, WISC.

GENEVA

LAKE

LANDING


CONCRETE
LANDING

LOT 8

LOT 9

HOUSE

GARAGE

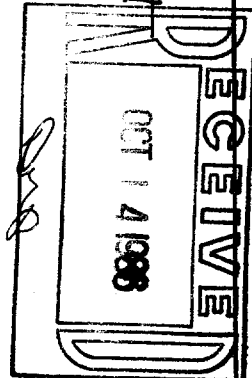

CORNER UNDER LAKE VIEW DRIVE

12"-16" BLK

25' WIDE

CORNER
UNDER 12'-16"
BLK TOP

SURVEY AND PLAT BY

JENSEN & JOHNSON

CIVIL ENGINEERS AND SURVEYORS

Elkhorn, Wisconsin

SURVEYED FOR:
KENDRA SAVINGS
AND LOAN
LAKE GENEVA
WIS.



LEGEND

- Iron Pipe
- Concrete Monument

Scale 1" = 20'

FD - FOUND

FENCE - x - x - x

THOMAS P. A.
JENSEN
S-1084
ELKHORN
WIS.

WE CERTIFY: That we have surveyed the above described property and that the plat shown hereon is an accurate survey and a true representation thereof and correctly shows the exterior boundary lines and all divisions of said property. AND ALL BUILDINGS THEREON.

Date Nov. 12, 1964

REVISED JULY 2, 1983

REVISED December 5, 1985

LLOYD L. JENSEN, Partner
Wisconsin Registered Land Surveyor, No. S-211