



PLAT OF SURVEY

of
Lots 21, 22, 23, and 24 of Edgewater Terrace Subdivision
located in Section 9, T1N, R17E, Walworth Co., Wisconsin.

Surveyed for: Norman Pazdersti
P.O. Box 581
Lake Geneva, WI. 53147

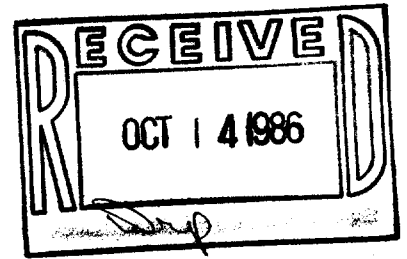

Jensen Surveying & Mapping S.C.
45 S. Wisconsin St. P.O. Box 322
Elkhorn, Wisconsin. 53121
(414) 723-3434

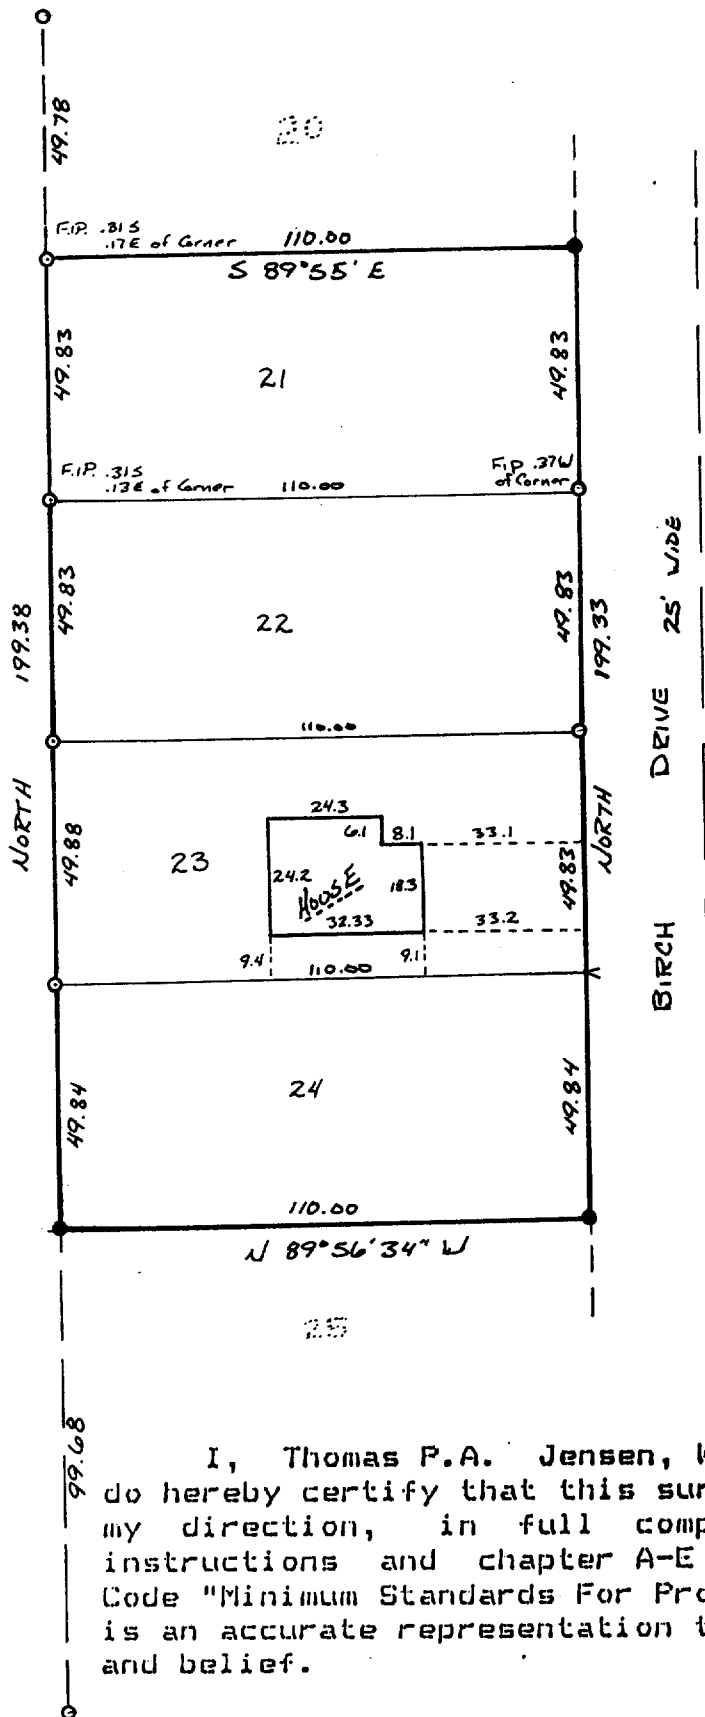

BEARINGS REFERENCED TO THE
WEST LINE OF BIRCH DRIVE
ASSUMED NORTH.

1"=40'

LEGEND

- - FOUND IRON PIPE
- - SET IRON ROD 3/4"
- < - SET Chiseled "V"

JULY 2, 1986.

I, Thomas P.A. Jensen, Wisconsin Registered Land Surveyor, do hereby certify that this survey was performed by me, or under my direction, in full compliance with the owner's/agent's instructions and chapter A-E 5 of the Wisconsin Administrative Code "Minimum Standards For Property Surveys"; and that this map is an accurate representation thereof to the best of my knowledge and belief.

Note: This survey plat is not certified unless signed and sealed in red ink.

Thomas P.A. Jensen S-1084
Jensen Surveying & Mapping S.C.

X 1986.054
117-748