
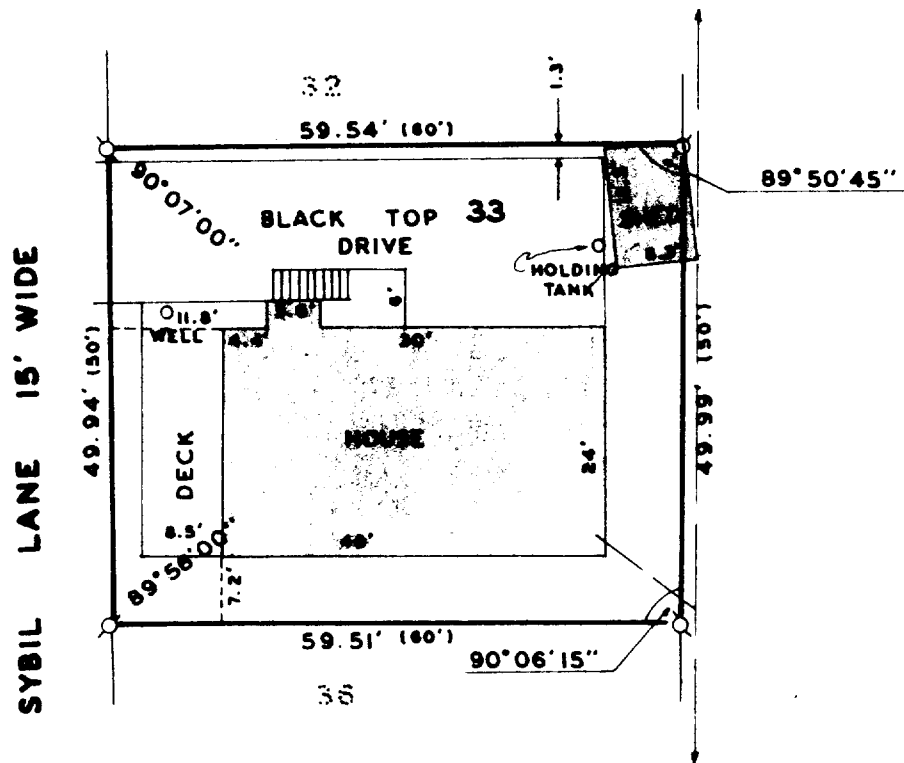


414-248-3697

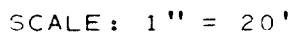

Ø - IRON PIPE FOUND
 — - OVERHEAD UTILITY LINE
 () - AS RECORDED

ORDERED BY: THE RAULAND AGENCY
P.O. BOX 159
WALWORTH, WI. 53184

OWNER: CHARLES HIRT

LOT 33, OF CAMP SYBIL SUBDIVISION, LOCATED IN
SECTION 18, T1N, R17E, TOWN OF LINN, WALWORTH
COUNTY, WISCONSIN.

THIS SURVEY IS MADE FOR THE USE OF THE PRESENT OWNERS OF THE PROPERTY, AND ALSO THOSE WHO PURCHASE, MORTGAGE, OR GUARANTEE THE TITLE THERETO WITHIN ONE (1) YEAR FROM DATE HEREOF.

HAROLD H. KOLB

WISCONSIN REGISTERED LAND SURVEYOR, S-187

DATE MAY 19, 1986

REVISÉD

REVISÉD

