


WALWORTH COUNTY  
SURVEYING & MAPPING  
LAKE GENEVA, WISCONSIN

NOTE: IRON PIPE 0.43 FEET WEST OF  
LOT CORNER AS SHOWN ON EXISTING  
SURVEY RECORDS.

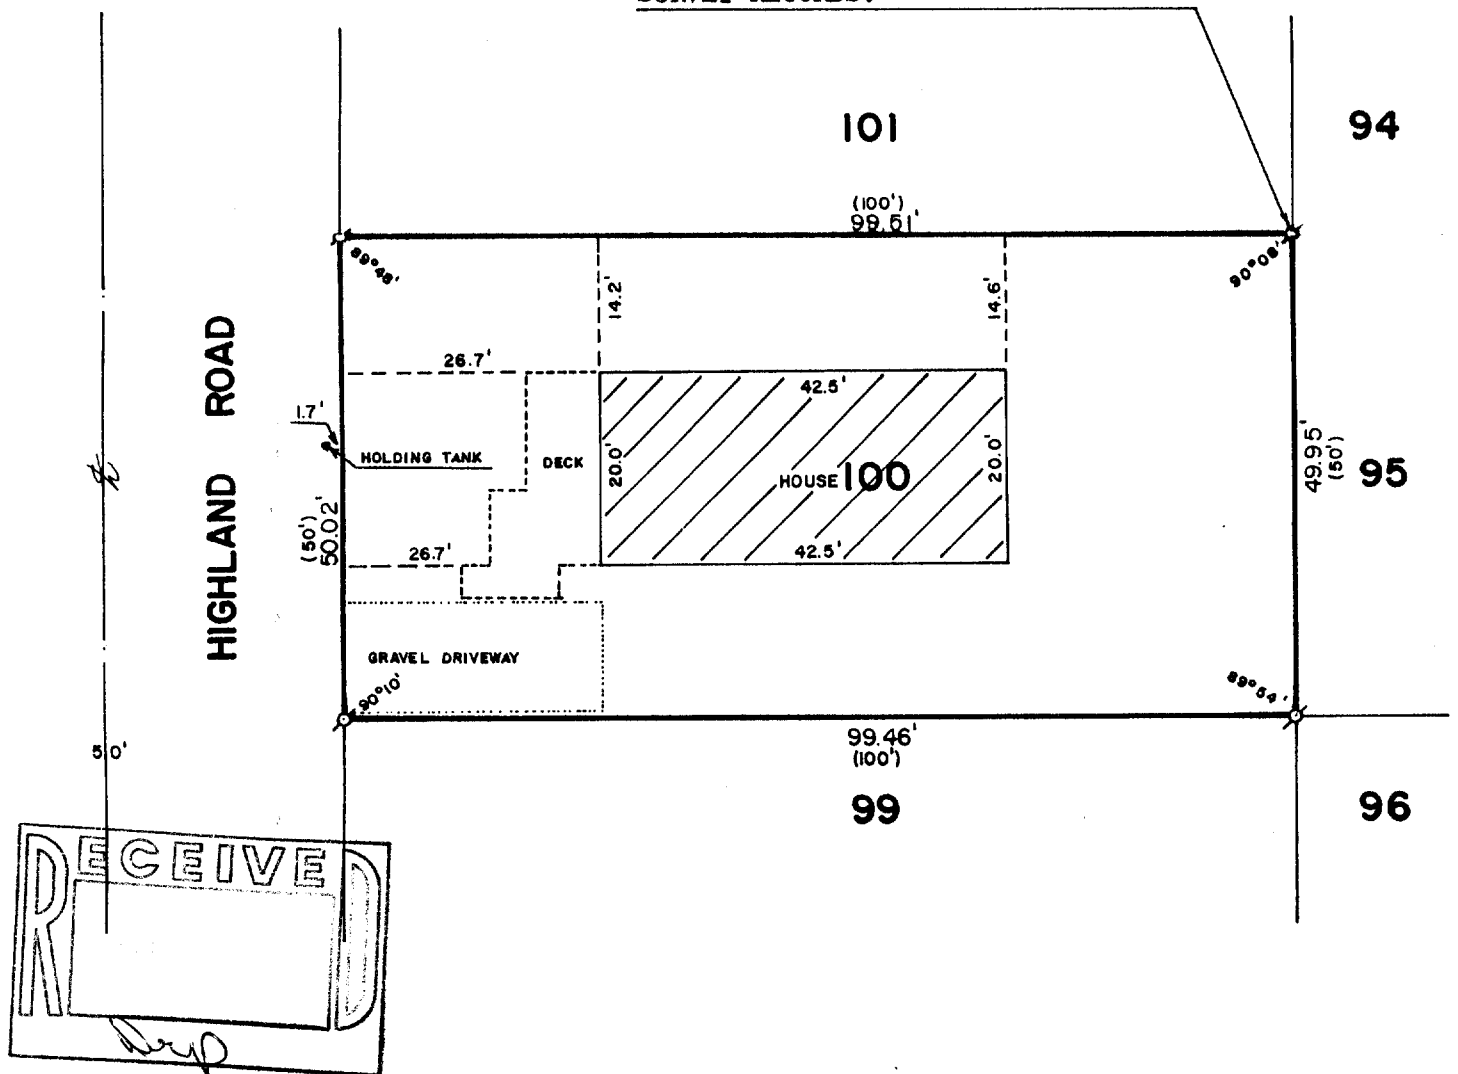

PLAT OF SURVEY OF

LOT 100 OF LAKE GENEVA HIGHLANDS, A  
SUBDIVISION LOCATED IN SECTION 8,  
T 1 N, R 17 E, WALWORTH COUNTY,  
WISCONSIN.

ORDERED BY: GENEVA LAKEFRONT REALTY  
50 WEST GENEVA STREET  
WILLIAMS BAY, WISCONSIN



SCALE: 1"=20'

Ø - IRON PIPE FOUND  
( ) - RECORDED AS

I, ROBERT M. BAERENWALD, DO HEREBY CERTIFY THAT I  
HAVE SURVEYED THE PROPERTY HEREON DESCRIBED ACCORDING  
TO THE OFFICIAL RECORDS AND THAT THE PLAT HEREON IS A  
CORRECT REPRESENTATION OF THE PROPERTY LINES TO THE  
BEST OF MY KNOWLEDGE AND BELIEF.

*Robert M. Baerenwald*  
ROBERT M. BAERENWALD  
WISCONSIN REGISTERED LAND SURVEYOR, S-1508

*Oct. 8, 1986*  
DATE JOB NO. 0739

NOTE: THIS IS NOT A CERTIFIED COPY UNLESS SEALED.

1L64-97

117-762B