



WALWORTH COUNTY
SURVEYING & MAPPING
LAKE GENEVA, WISCONSIN

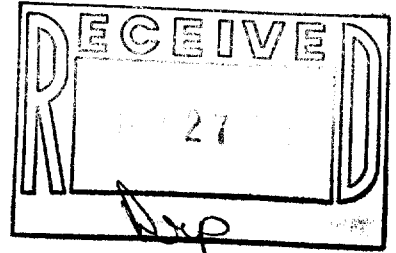

EAST BEACH DRIVE

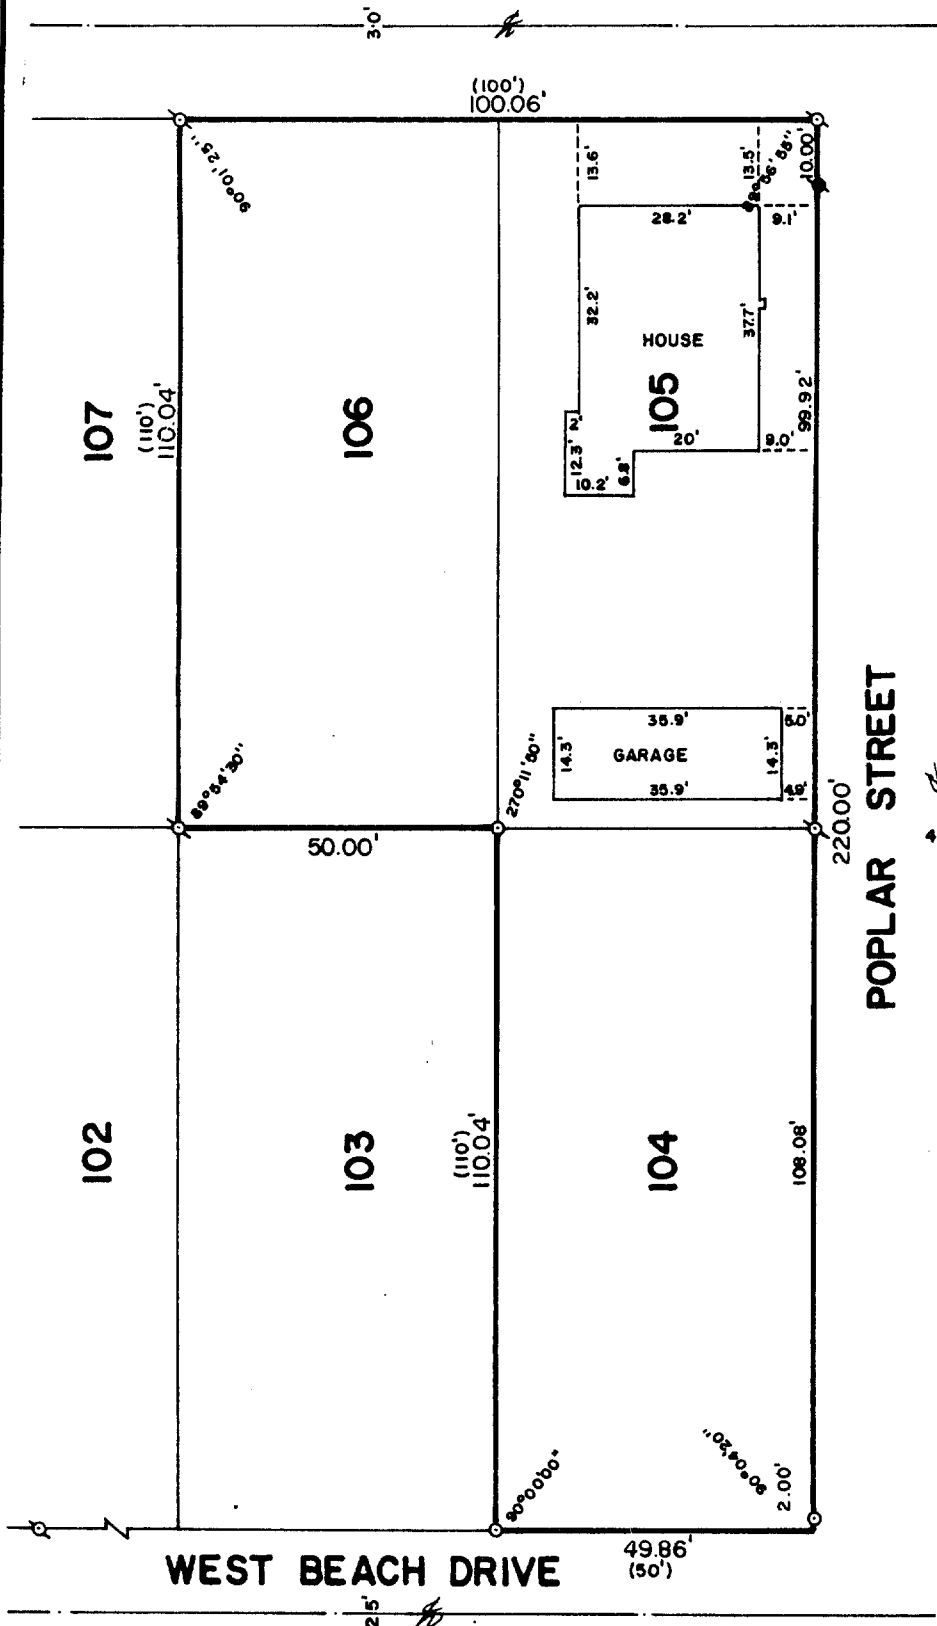

PLAT OF SURVEY OF

LOTS 104-106 OF LAKE GENEVA BEACH, LOCATED
IN T 1 N, R 17 E, WALWORTH COUNTY, WISCONSIN.

ORDERED BY: JIM SALTERY
7518 W. ARDMORE
CHICAGO, ILLINOIS
60631



SCALE: 1"=30'

- - IRON PIPE FOUND
- - CONCRETE MONUMENT FOUND
- - IRON ROD PLACED
- () - RECORDED AS

I, ROBERT M. BAERENWALD, DO HEREBY CERTIFY THAT I
HAVE SURVEYED THE PROPERTY HEREON DESCRIBED ACCORDING
TO THE OFFICIAL RECORDS AND THAT THE PLAT HEREON IS A
CORRECT REPRESENTATION OF THE PROPERTY LINES TO THE
BEST OF MY KNOWLEDGE AND BELIEF.

Robert M. Baerenwald
ROBERT M. BAERENWALD
WISCONSIN REGISTERED LAND SURVEYOR, S-1508

Oct. 21, 1986
DATE JOB NO. 0732

NOTE: THIS IS NOT A CERTIFIED COPY UNLESS SEALED.

116B-94, 95, 96

117-767B