


PLAT OF SURVEY

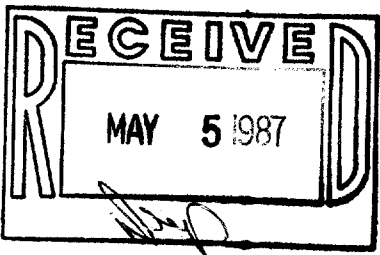


LOCATION: Route 2, Box 106, Lake Geneva, Wisconsin

LEGAL DESCRIPTION: Lot 3 of CERTIFIED SURVEY MAP NO. 675, being a part of the NE 1/4 of Section 5, Town 1 North, Range 17 East, in the Town of Linn, Walworth County, Wisconsin, and recorded in the office of the Register of Deeds for said county on June 20, 1977, in Volume 3 of Certified Surveys, pages 164, 165 and 166 as Document No. 18528, as amended by instrument dated July 28, 1977, and recorded in said Register's office on July 29, 1977, in Volume 192 of Records, page 685, as Document No. 20530. Subject to an easement to construct and maintain a septic field upon the following described portion of said Lot 3, to-wit: Commencing at the Northwest corner of the Northeast 1/4 of Section 5, Town 1 North, Range 17 East; thence S 22 36' 25" East 2,018.83 feet to a point; thence S 00 12' 10" West 75.95 feet to the place of beginning; thence S 89 47' 50" East 120 feet; thence S 00 12' 10" West 60 feet; thence N 89 47' 50" West 12 feet; thence N 00 12' 10" East 60 feet to the place of beginning.

April 2, 1987

Survey No. 70567

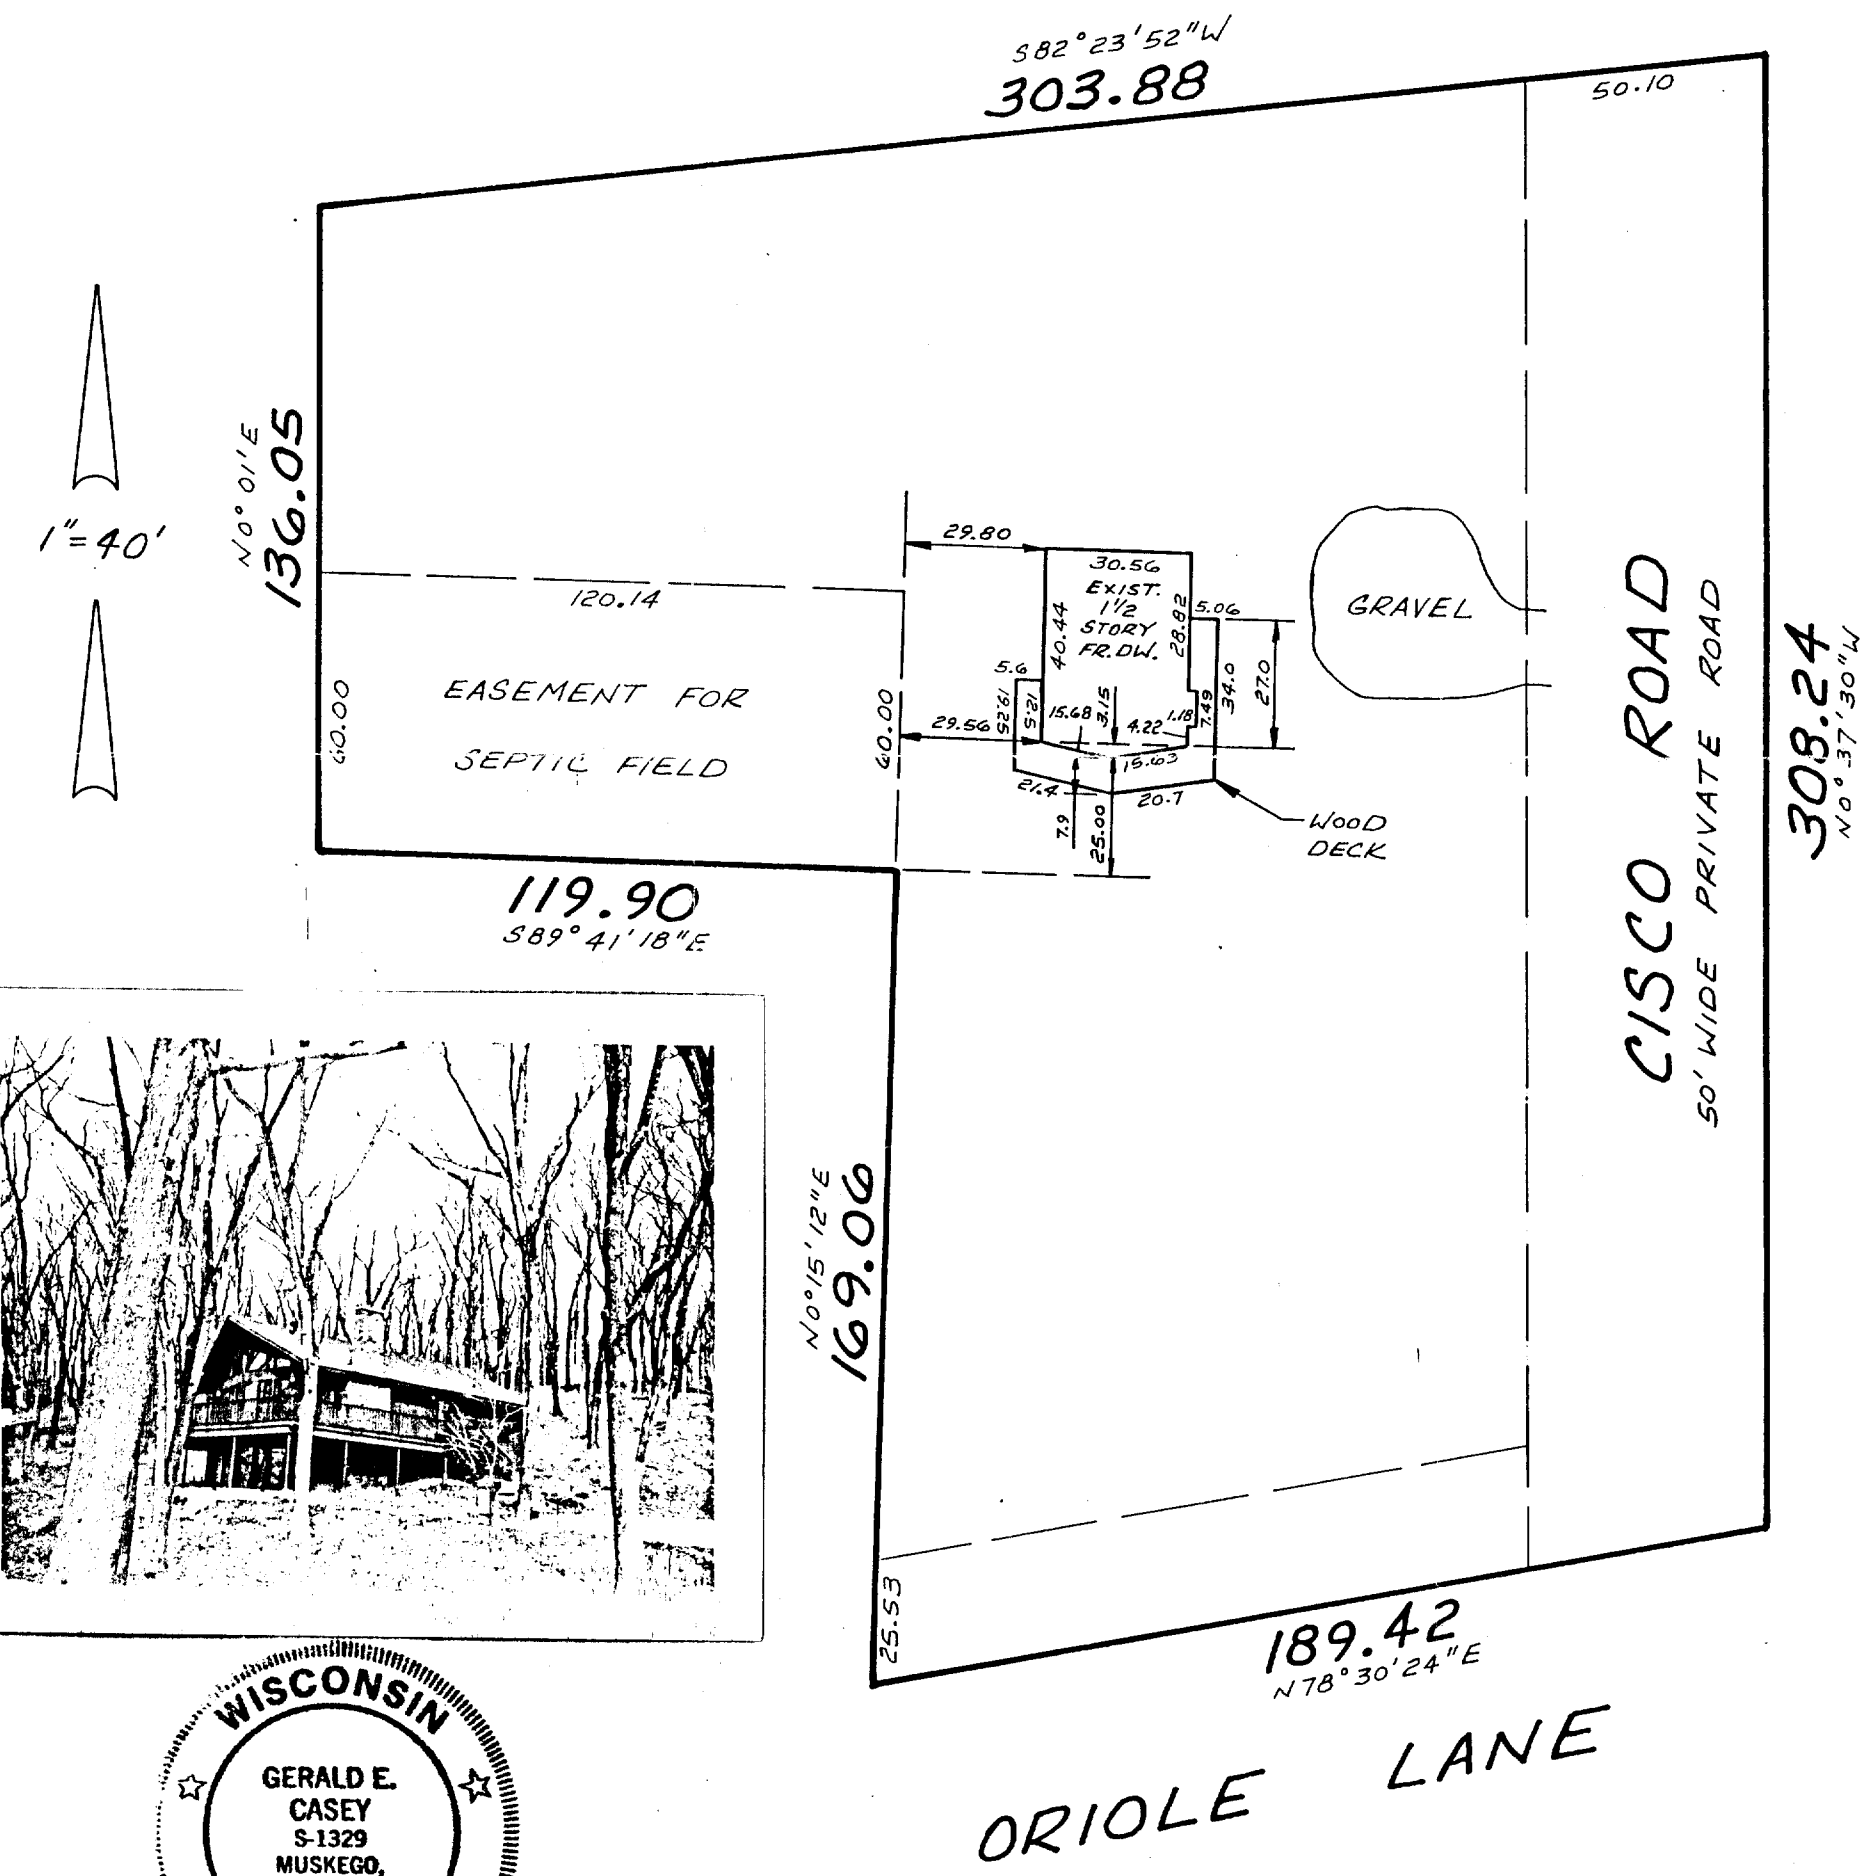

METROPOLITAN SURVEY SERVICE, INC.
REGISTERED LAND SURVEYORS
9415 W. FOREST HOME AVE., SUITE 107 HALES CORNERS, WI 53130
529-5380

Mortgage Inspection
Monumentation has been waived in accordance with A-5 5.01 (b) of the Wisconsin Administrative Code

I HEREBY CERTIFY THAT I HAVE SURVEYED THE ABOVE DESCRIBED PROPERTY AND THAT THE ABOVE MAP IS A TRUE REPRESENTATION THEREOF AND SHOWS THE SIZE AND LOCATION OF THE PROPERTY, ITS EXTERIOR BOUNDARIES, THE LOCATION OF ALL VISIBLE STRUCTURES AND DIMENSIONS OF ALL PRINCIPAL BUILDINGS THEREON, BOUNDARY FENCES, APPARENT EASEMENTS AND ROADWAYS AND VISIBLE ENCROACHMENTS, IF ANY.

THIS SURVEY IS MADE FOR THE EXCLUSIVE USE OF THE PRESENT OWNERS OF THE PROPERTY, AND ALSO THOSE WHO PURCHASE, MORTGAGE, OR GUARANTEE THE TITLE THERETO WITHIN ONE (1) YEAR FROM DATE HEREOF.

SIGNED