


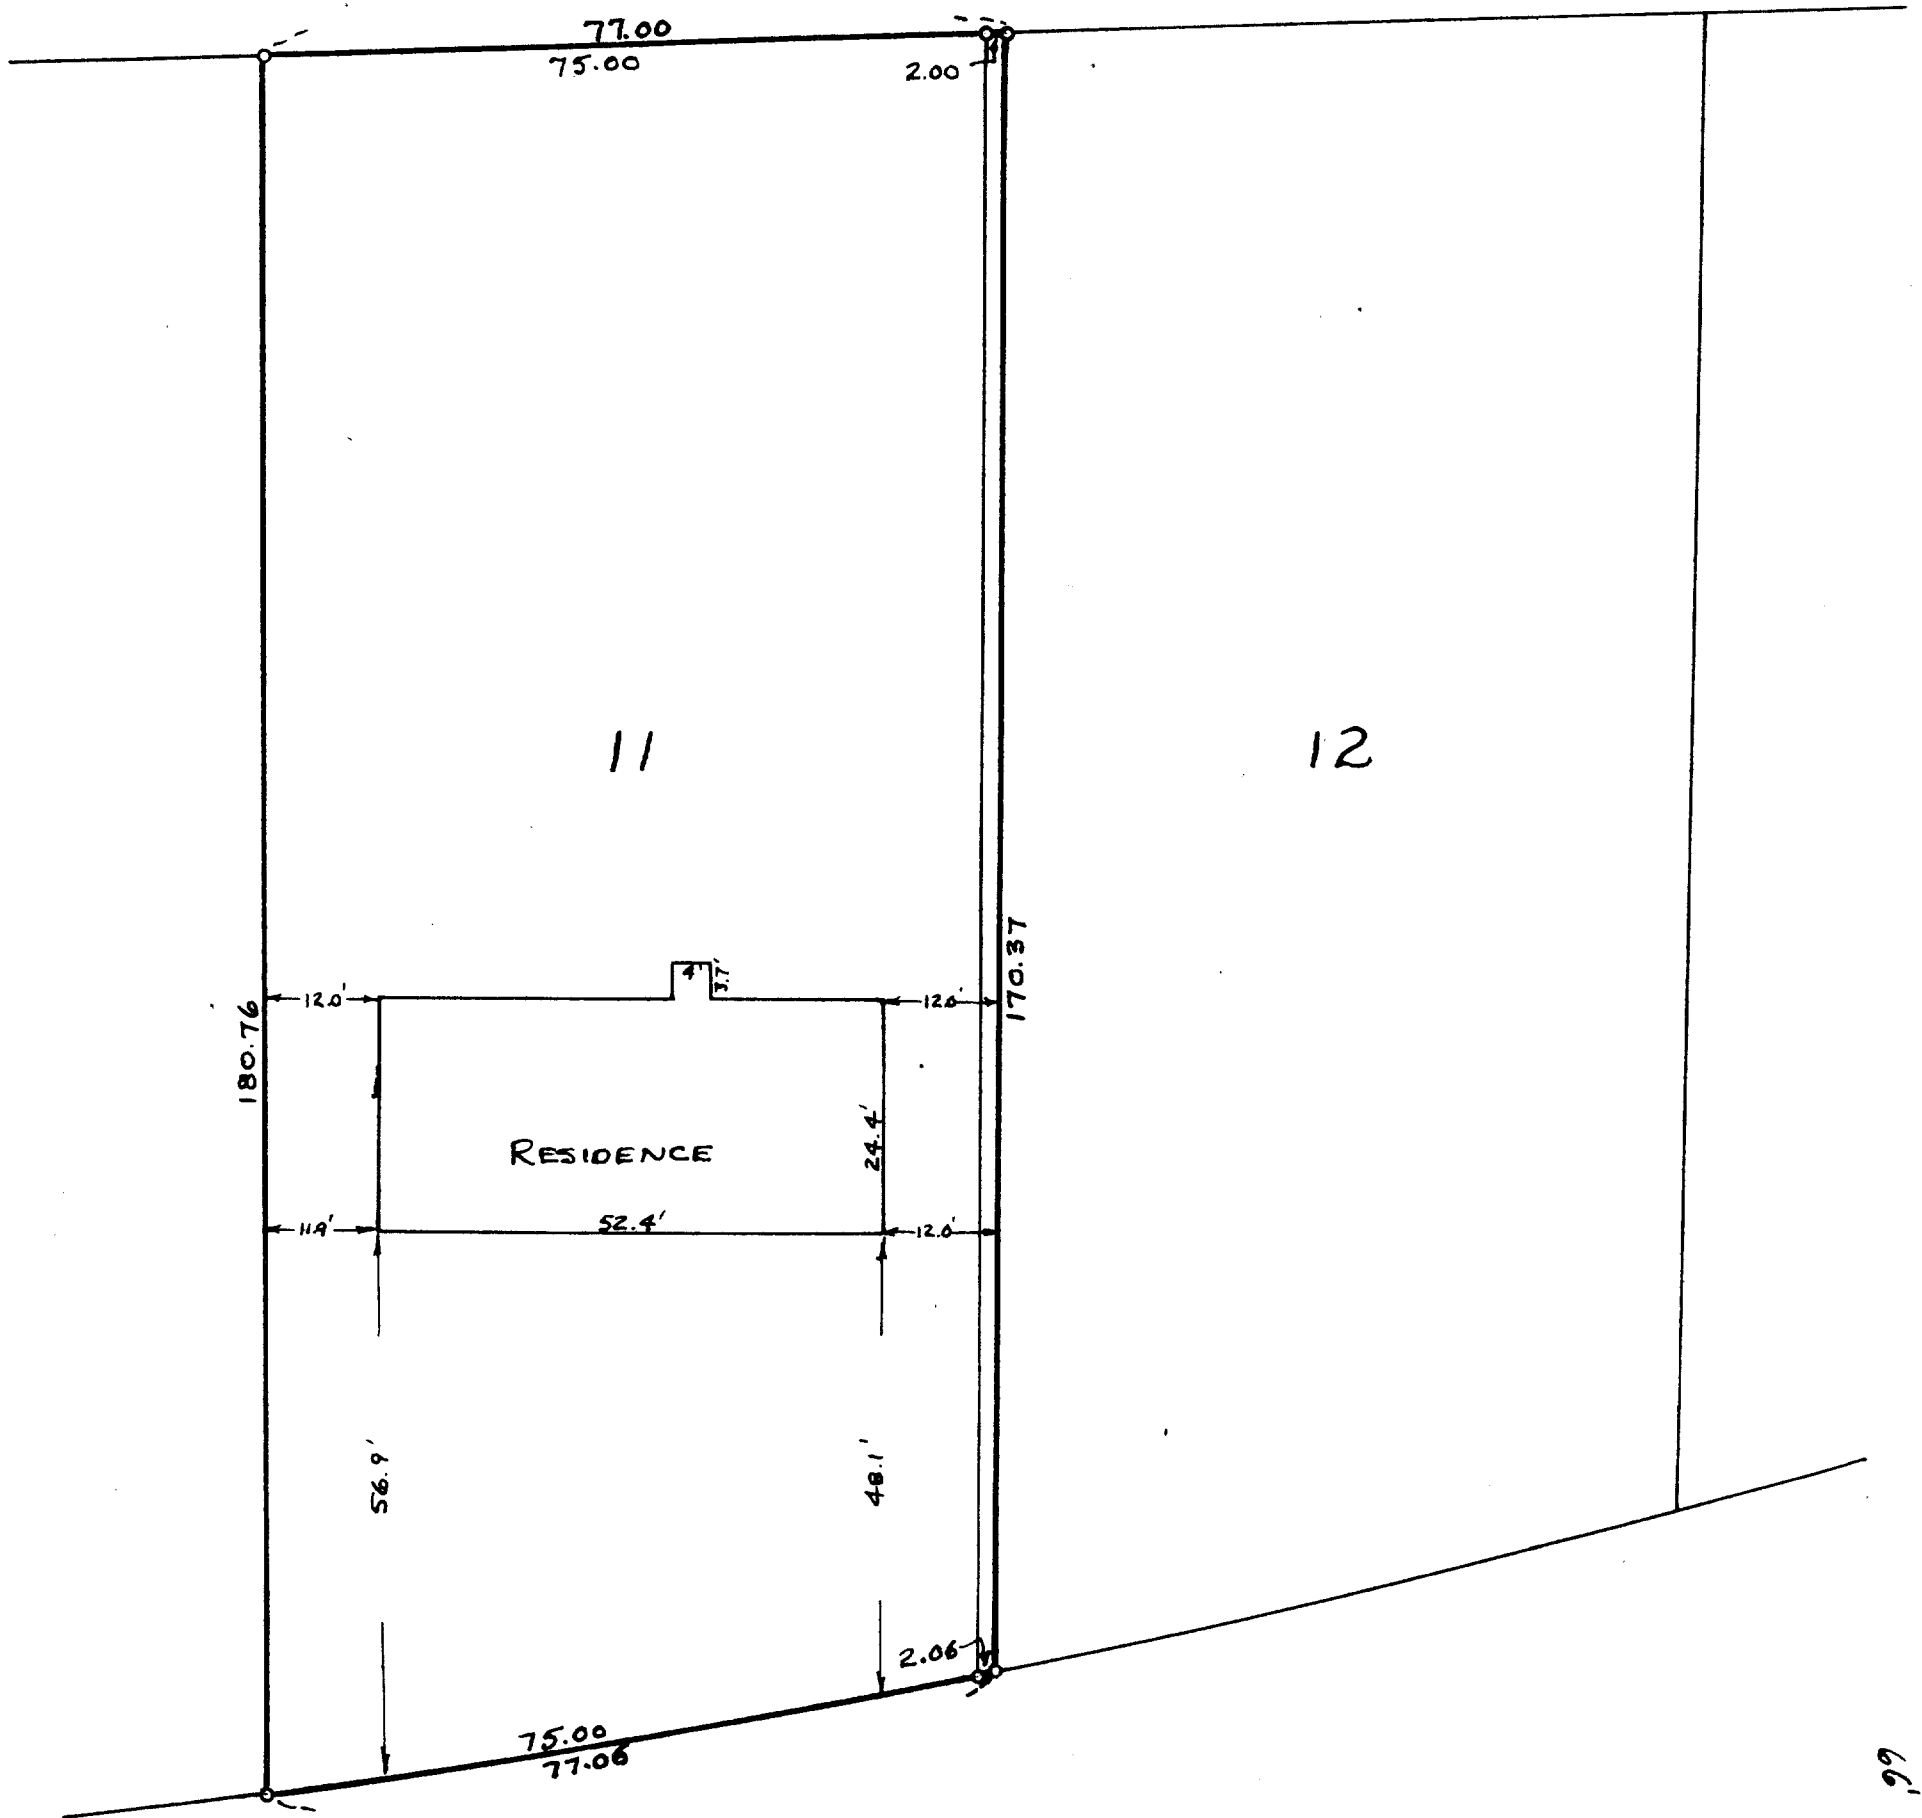

PLAT OF SURVEY OF LOT 11 AND THE SOUTH  
2' OF LOT 12 OF BLOCK 6 OF WOODDALE ADDITION  
LOCATED IN T1N17E OF WALWORTH CO., WIS.

SEPT. 1949

*Floyd D. Jensen*  
COUNTY SURVEYOR

IW-55A  
" 55B

117-78.1