


GEORGE T. DUNHAM
SURVEYING & SUBDIVIDING
DELAVER, WISCONSIN

N

Scale - 1" = 20'
O = Iron Pipe

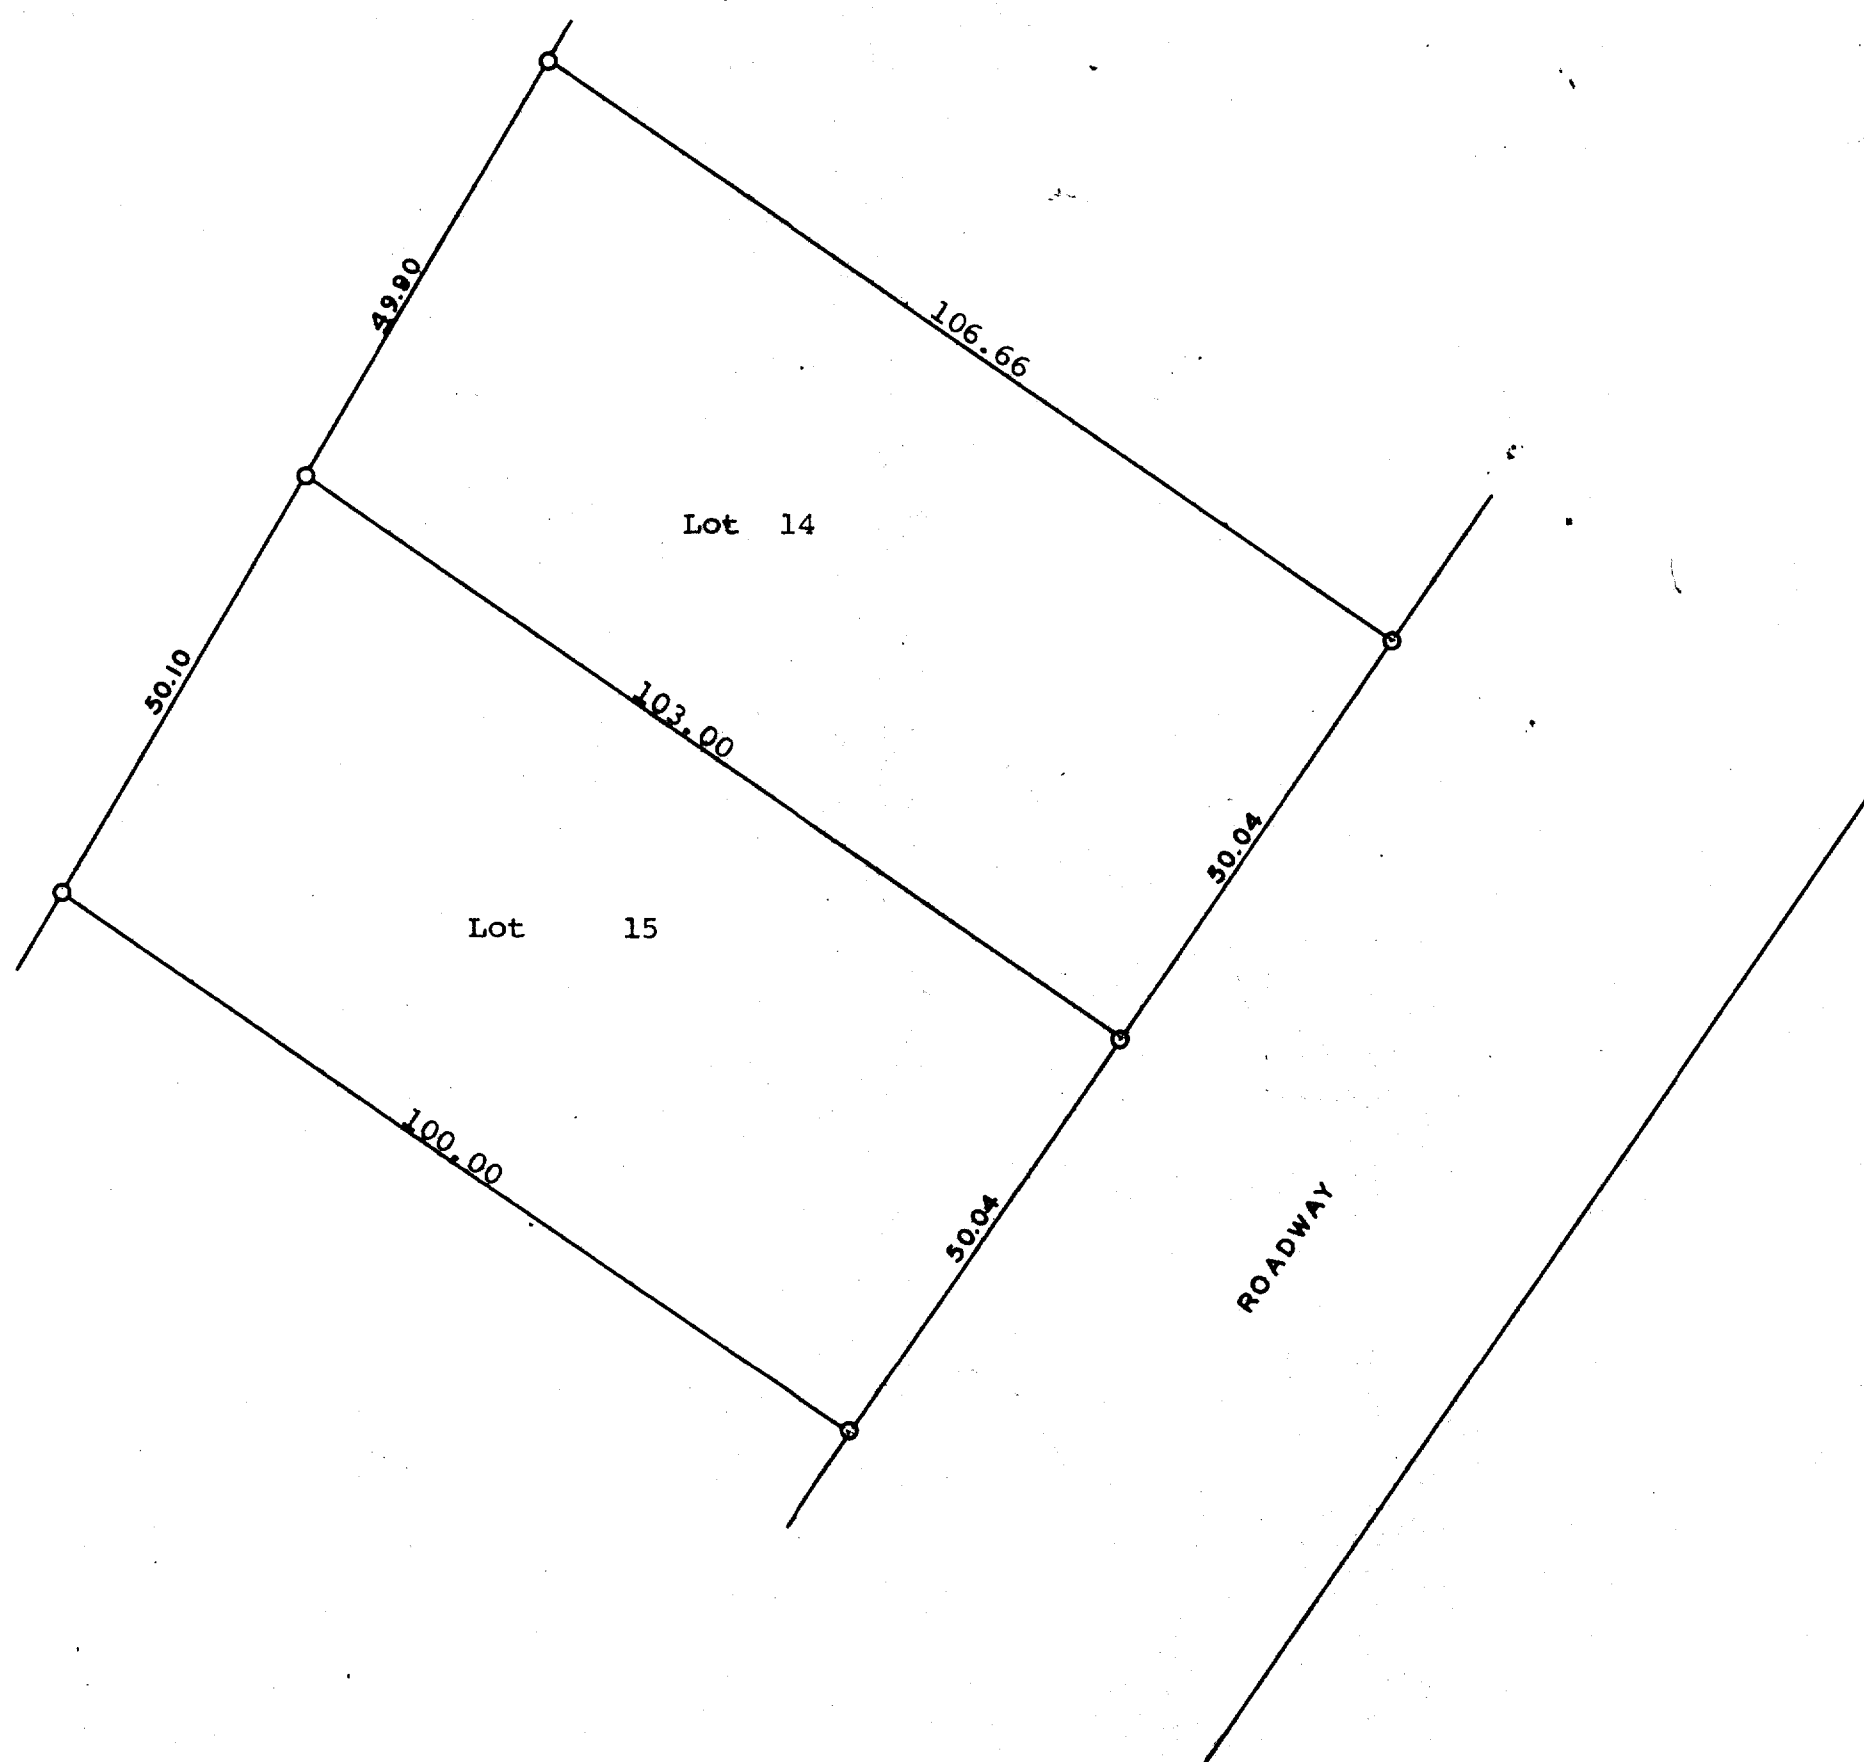

Plat of survey of Lots 14 and 15, Block 9, Sunset Hills,
a subdivision located in Section 4, T 1 N, R 17 E, Walworth
County, Wisconsin, as surveyed November 24, 1969.
February 3, 1970

George T. Dunham
George T. Dunham, Surveyor