


WALWORTH COUNTY
SURVEYING & MAPPING
727 HENRY STREET
LAKE GENEVA, WISCONSIN
414-248-0505

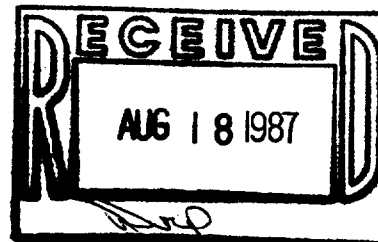


PLAT OF SURVEY OF

PART OF LOT 1 OF "THE FOLLY", BEING A SUBDIVISION
OF PART OF SECTION 3, T 1 N, R 17 E, WALWORTH
COUNTY, WISCONSIN.

ORDERED BY: LLOYD NELSON
111 SOUTH FLEMING
WOODSTOCK, ILLINOIS 60098

NOTE: THIS SURVEY IS A RETRACEMENT OF A SURVEY BY
LLOYD L. JENSEN DATED DECEMBER, 1960.

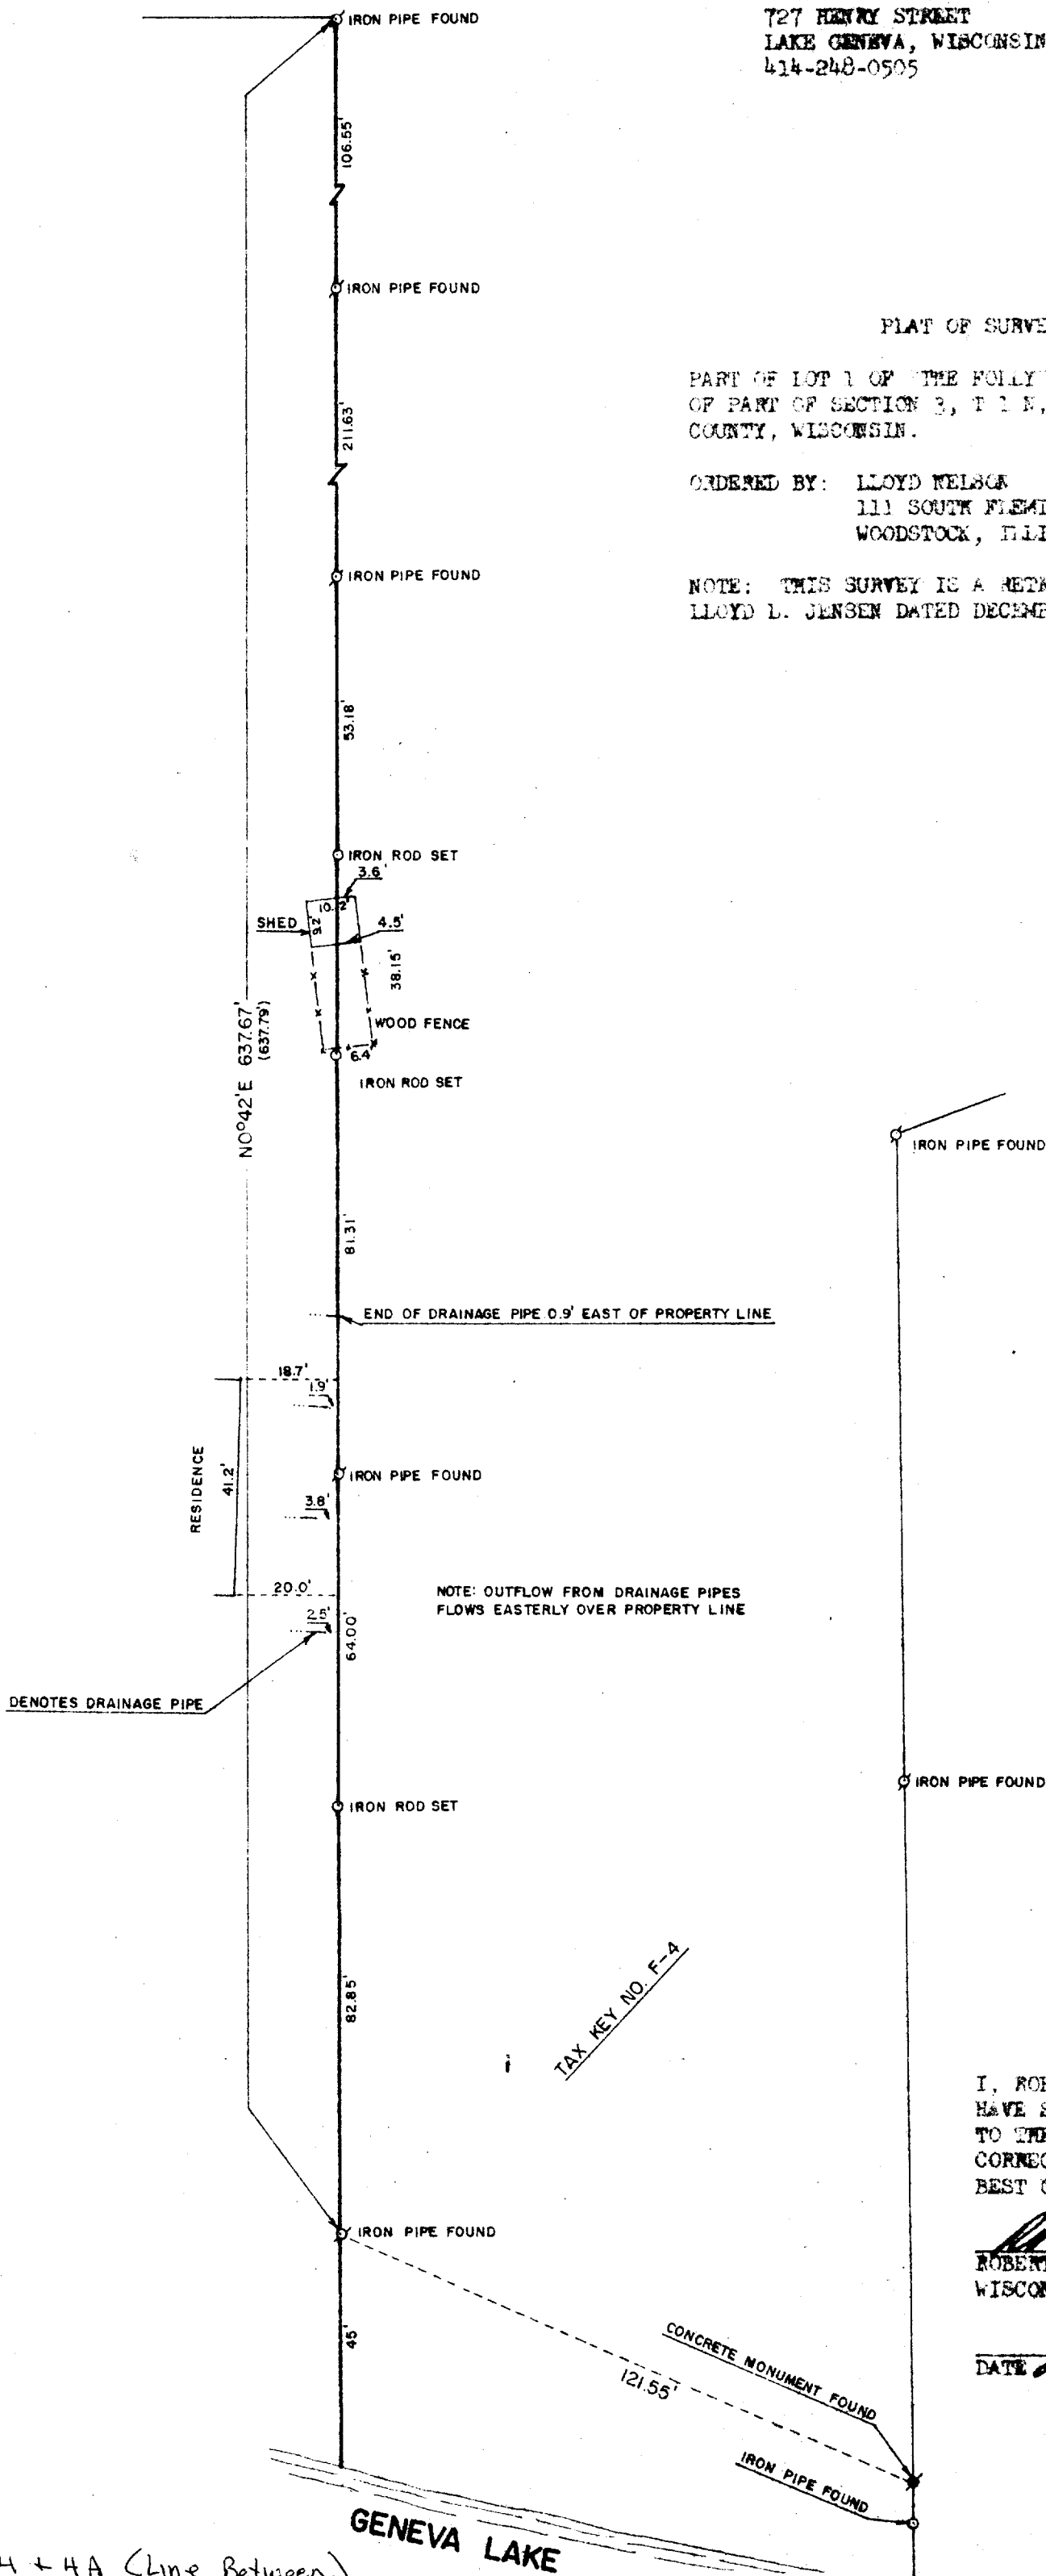

SCALE: 1"=30'

() - RECORDED AS

I, ROBERT M. BAERENWALD, DO HEREBY CERTIFY THAT I
HAVE SURVEYED THE PROPERTY HEREON DESCRIBED ACCORDING
TO THE OFFICIAL RECORDS AND THAT THE PLAT HEREON IS A
CORRECT REPRESENTATION OF THE PROPERTY LINES TO THE
BEST OF MY KNOWLEDGE AND BELIEF.

Robert M. Baerenwald
ROBERT M. BAERENWALD
WISCONSIN REGISTERED LAND SURVEYOR, S-1508

DATE *July 24, 1987* JOB NO. 1145

IF-4 + 4A (Line Between Both parcels)

117-799