


GEORGE T. DUNHAM
SURVEYING & SUBDIVIDING
DELAVER, WISCONSIN

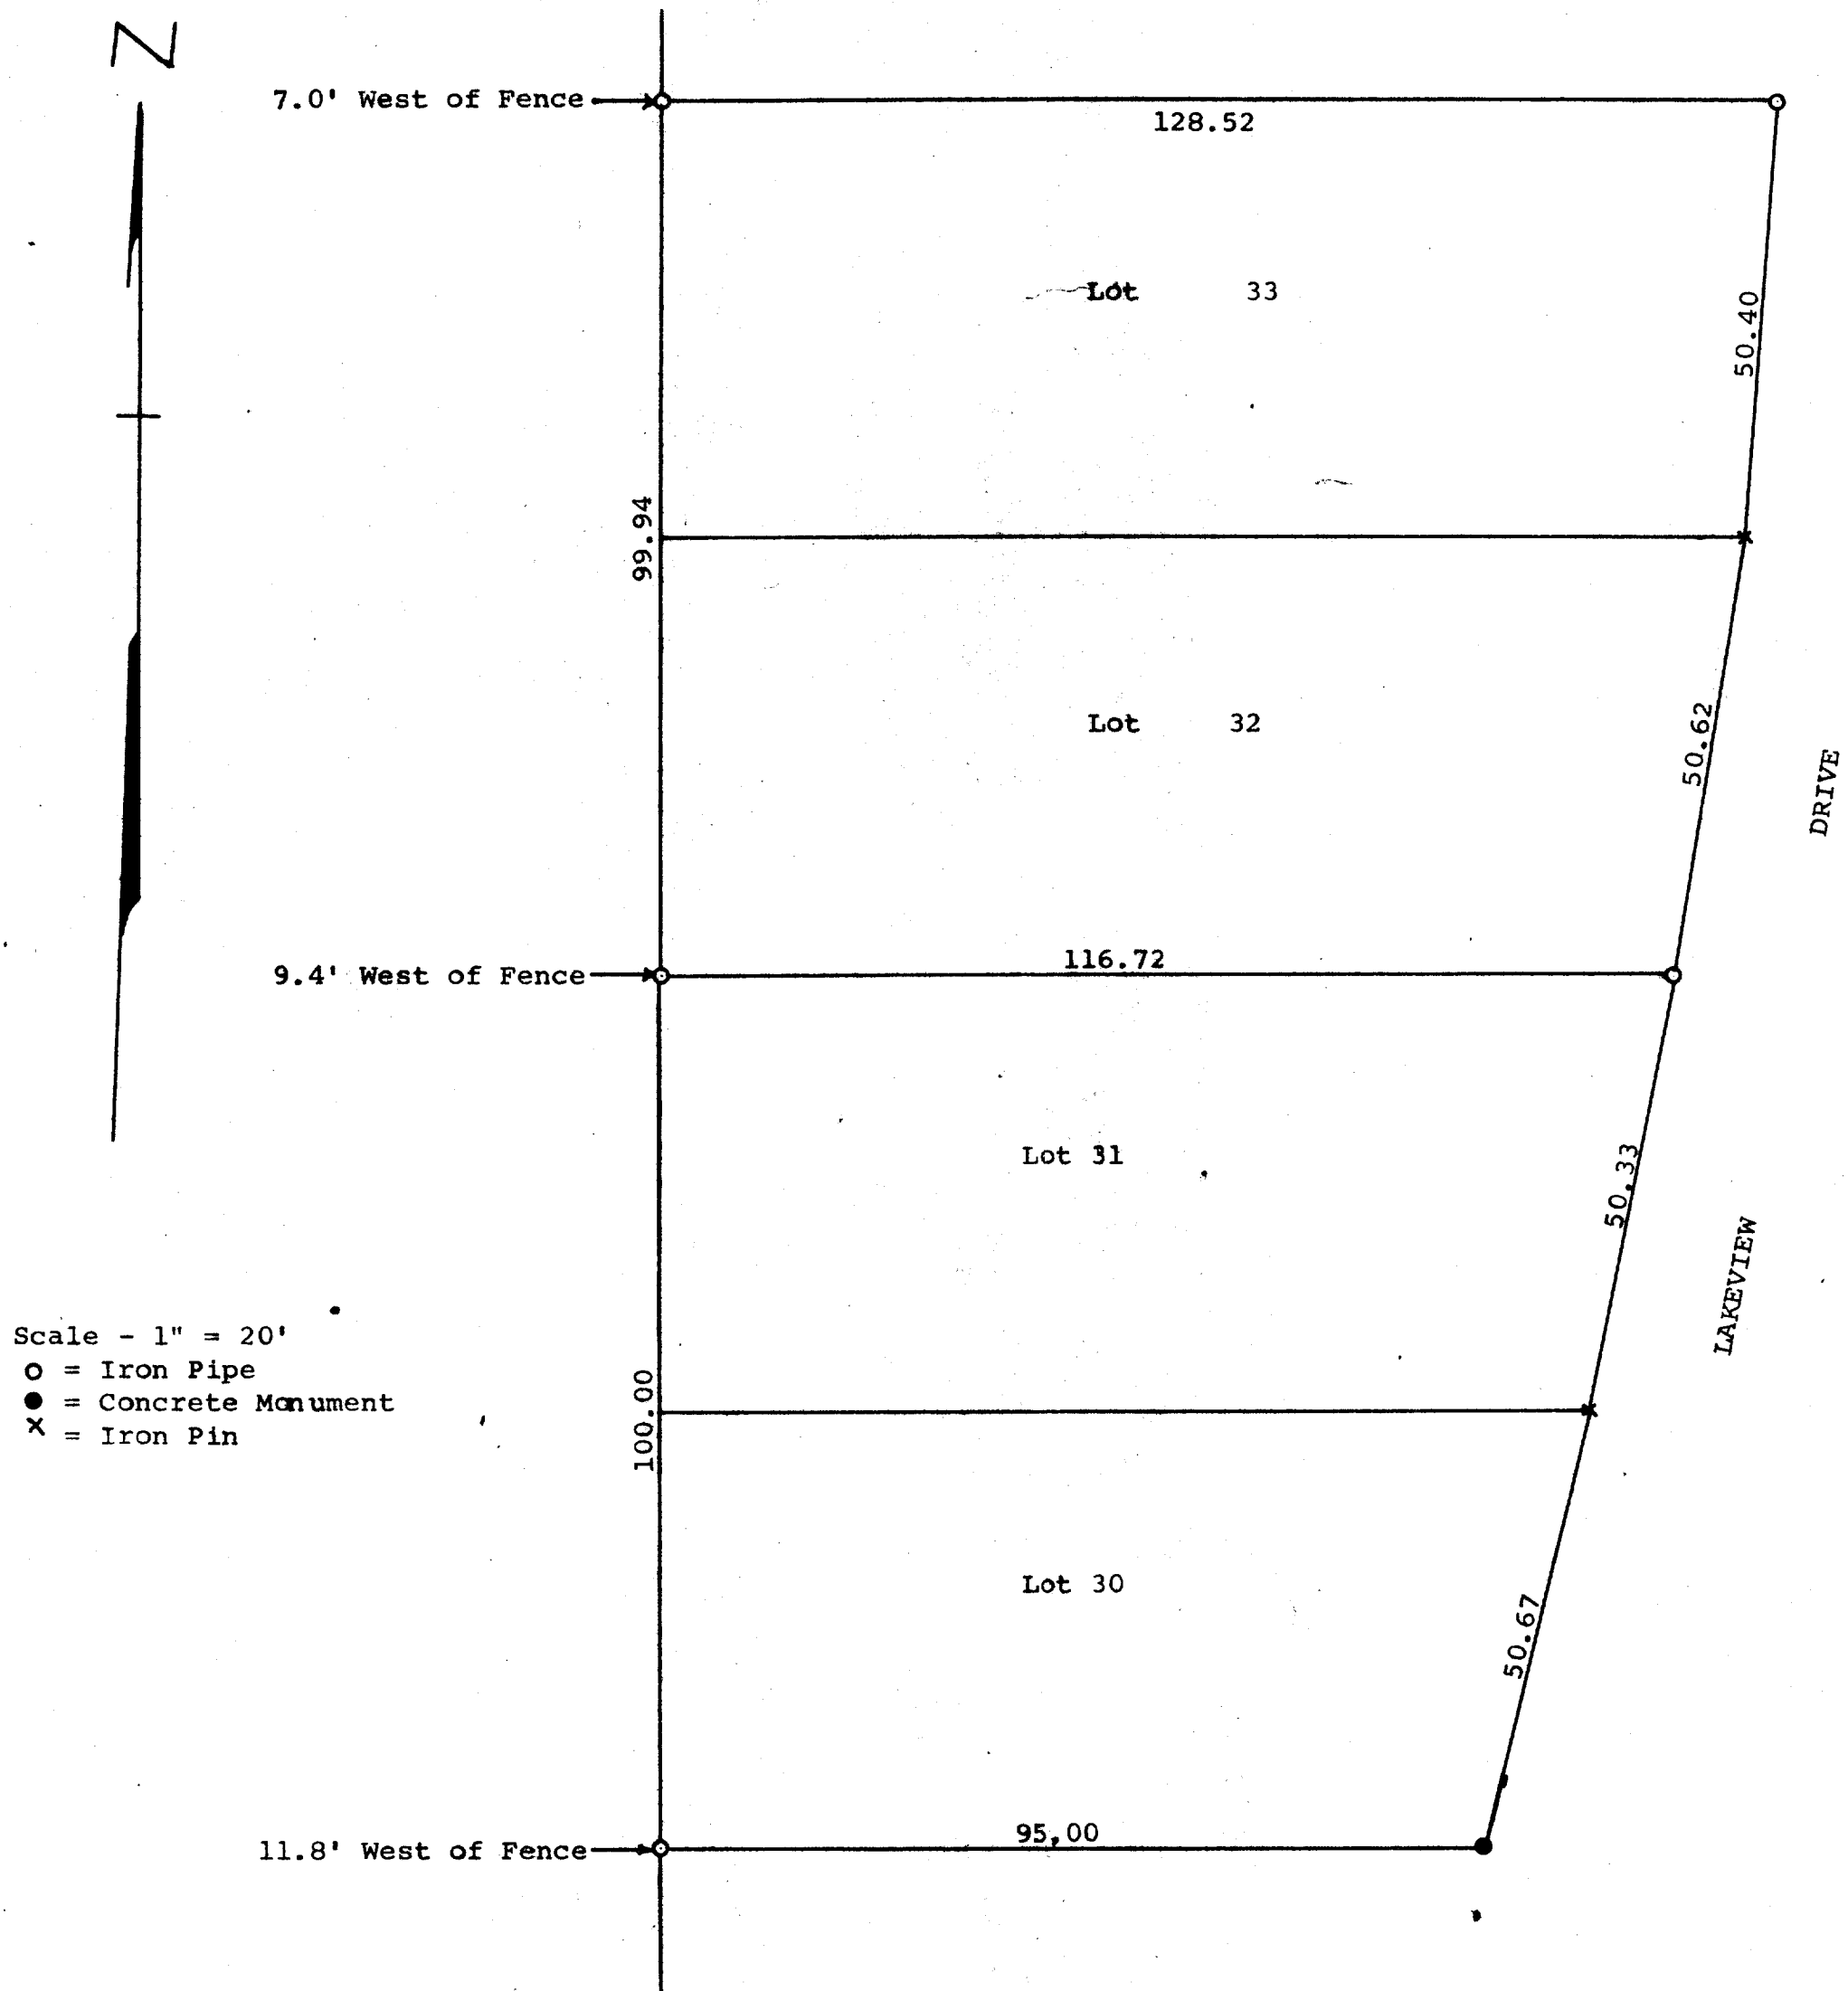

Plat of survey of Lots 30-33 Inclusive, Block 2 of Lake View Park
located in Section 16, T 1 N, R 17 E, Walworth County,
Wisconsin
November 26, 1969

George T. Dunham
George T. Dunham, Surveyor