
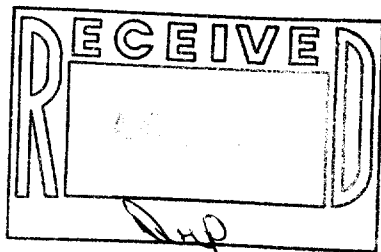


WALWORTH COUNTY
SURVEYING & MAPPING
LAKE GENEVA, WISCONSIN

HATCH-COPPS ROAD

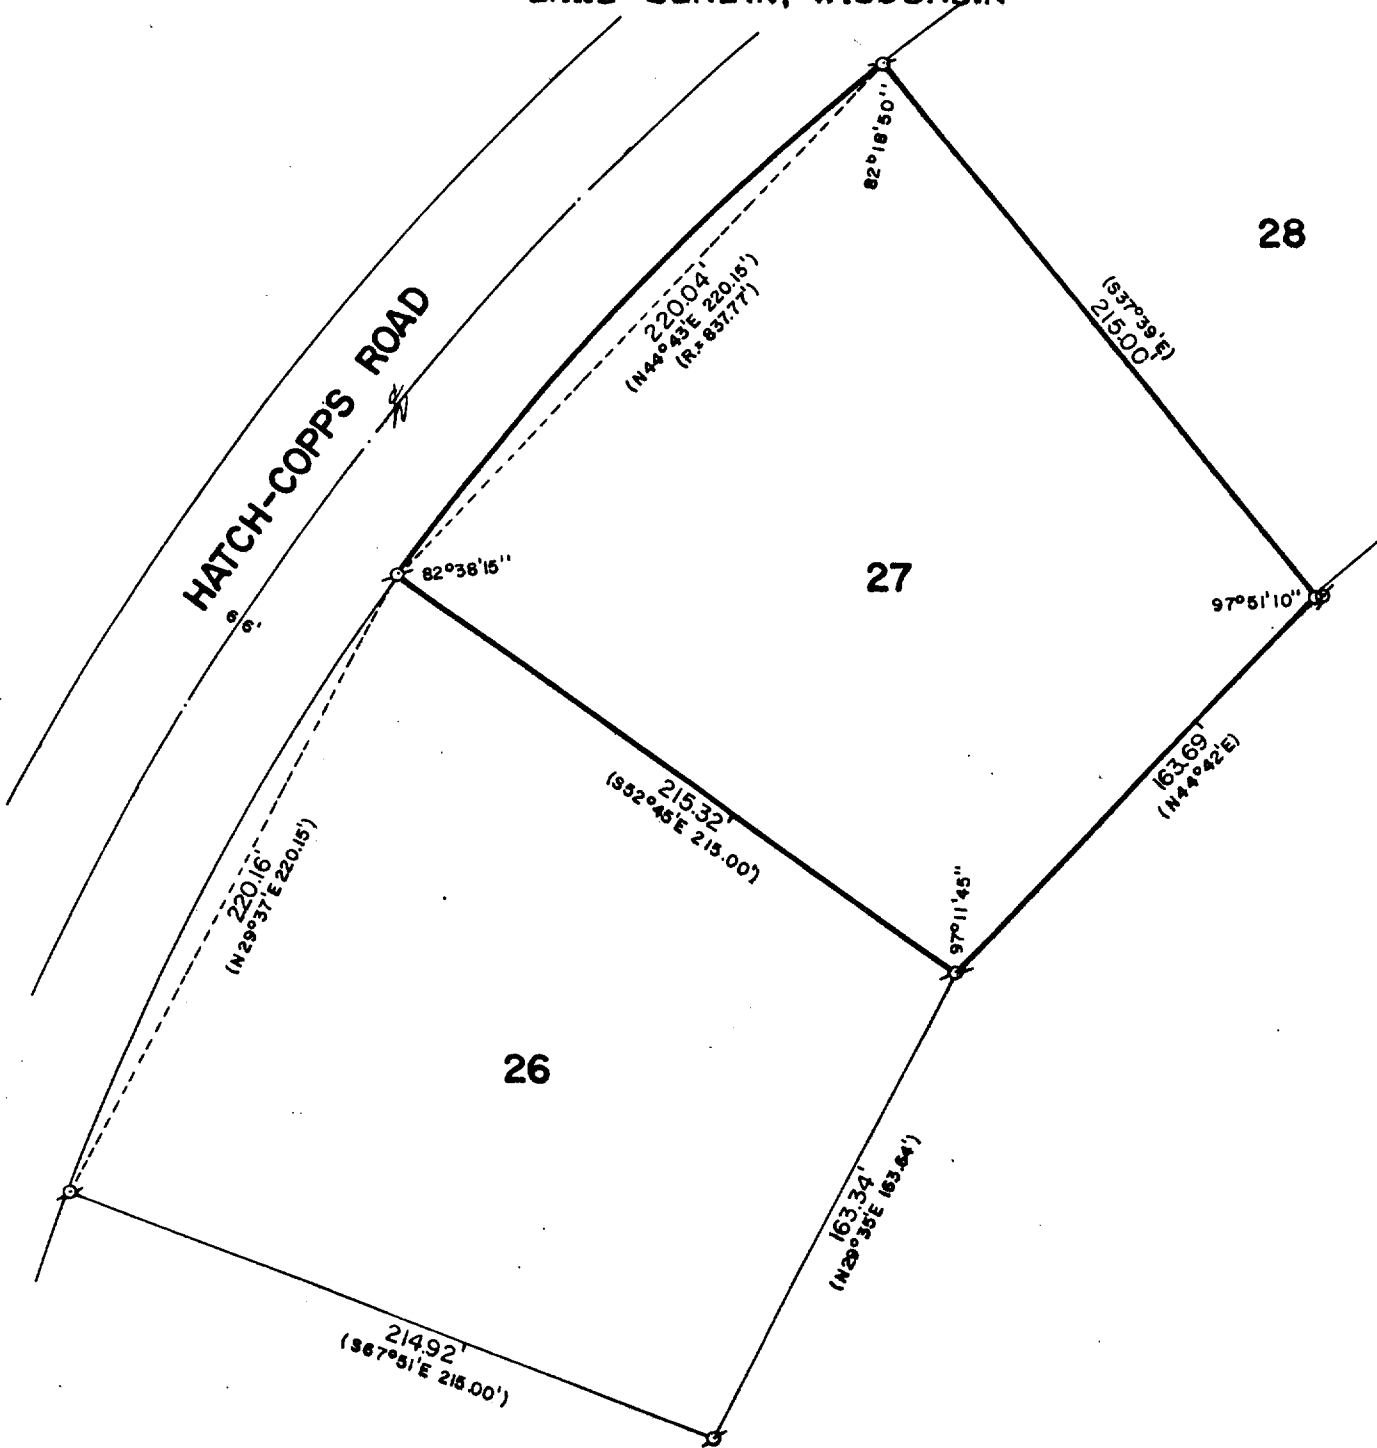

PLAT OF SURVEY OF

LOT 27 OF LINWOOD 1ST ADDITION, LOCATED
IN T 1 N, R 17 E, WALWORTH COUNTY, WIS-
CONSIN.

ORDERED BY: NANCY WILLIAMS
RT. 1, BOX 442
FONTANA, WISCONSIN



SCALE: 1"=60'

- ∘ - IRON PIPE FOUND
- - IRON ROD PLACED
- () - RECORDED AS

I, ROBERT M. BAERENWALD, DO HEREBY CERTIFY THAT I
HAVE SURVEYED THE PROPERTY HEREON DESCRIBED ACCORDING
TO THE OFFICIAL RECORDS AND THAT THE PLAT HEREON IS A
CORRECT REPRESENTATION OF THE PROPERTY LINES TO THE
BEST OF MY KNOWLEDGE AND BELIEF.

Robert M. Baerenwald
ROBERT M. BAERENWALD
WISCONSIN REGISTERED LAND SURVEYOR, S-1508

DATE July 19, 1987 JOB NO. 1128

NOTE: THIS IS NOT A CERTIFIED COPY UNLESS SEALED.