
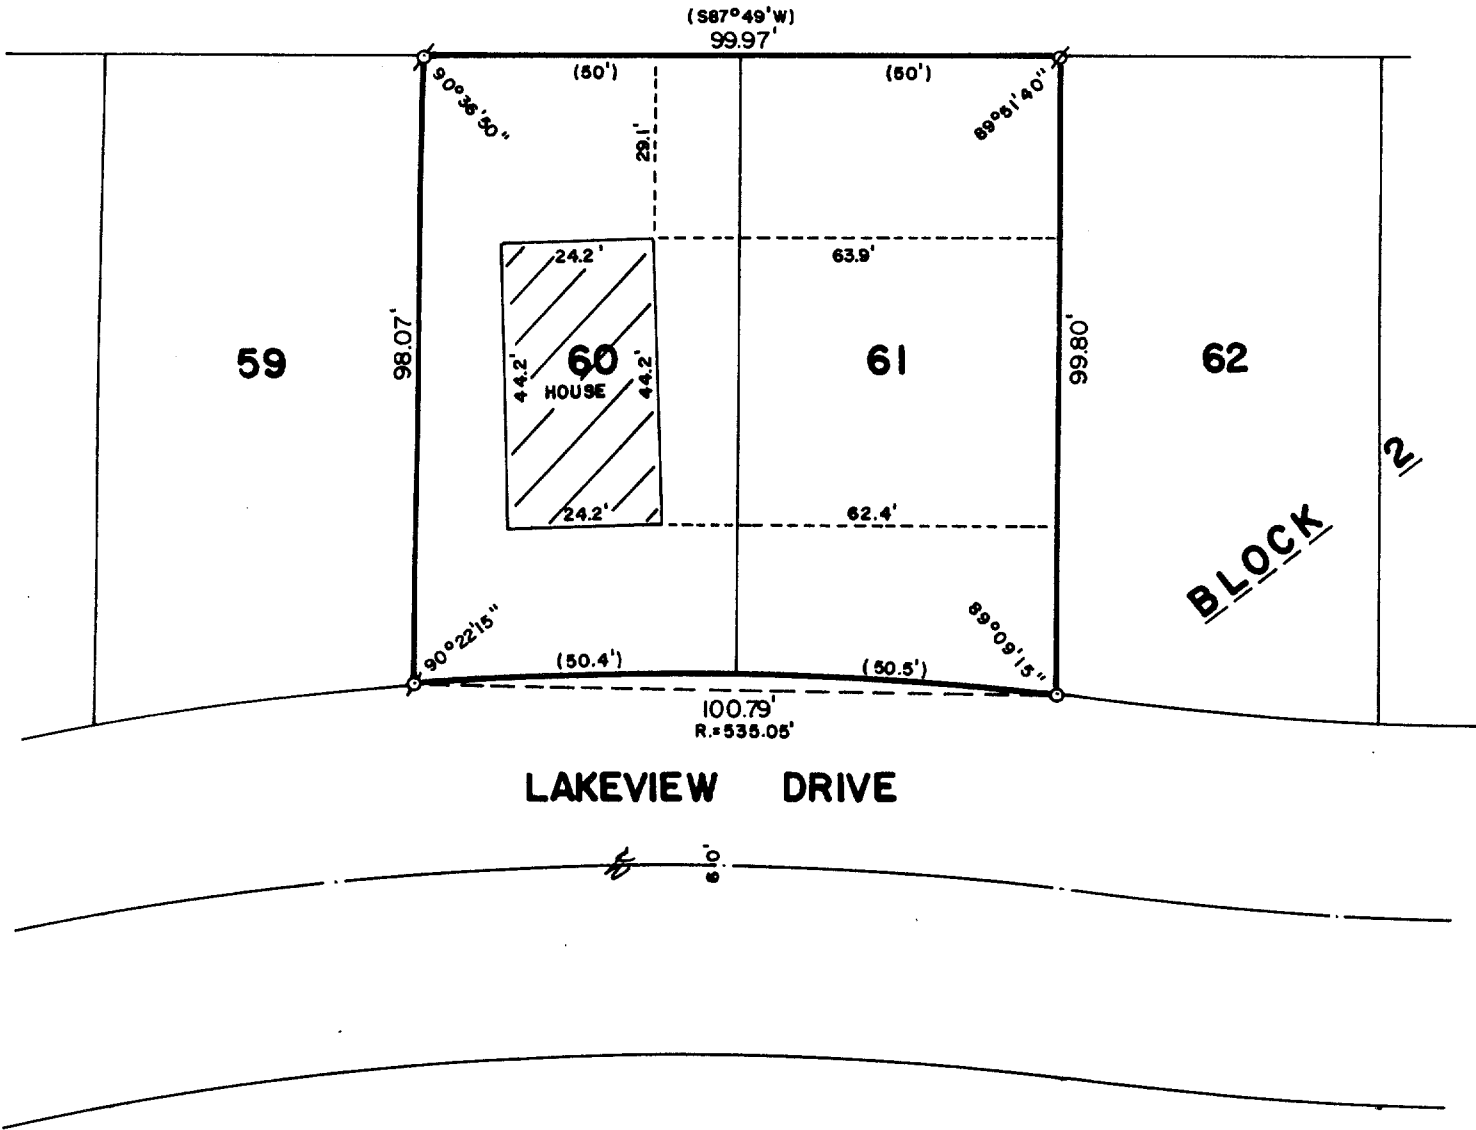


WALWORTH COUNTY  
SURVEYING & MAPPING  
LAKE GENEVA, WISCONSIN

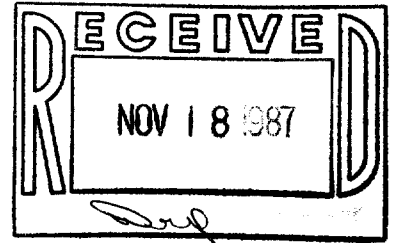


LAKEVIEW DRIVE

PLAT OF SURVEY OF

LOTS 60 AND 61, BLOCK 2 OF LAKEVIEW  
PARK, A SUBDIVISION LOCATED IN T 1 N,  
R 17 E, WALWORTH COUNTY, WISCONSIN.

ORDERED BY: **KEEFE REAL ESTATE**  
704 MAIN STREET  
LAKE GENEVA, WISCONSIN  
53147

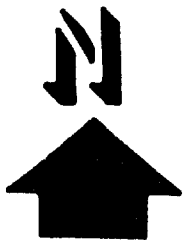

SCALE: 1"=30'

- ∅ - IRON PIPE FOUND
- ∅ - IRON PIN FOUND,  
IRON ROD PLACED
- - IRON ROD PLACED
- ( ) - RECORDED AS

I, ROBERT M. BAERENWALD, DO HEREBY CERTIFY THAT I  
HAVE SURVEYED THE PROPERTY HEREON DESCRIBED ACCORDING  
TO THE OFFICIAL RECORDS AND THAT THE PLAT HEREON IS A  
CORRECT REPRESENTATION OF THE PROPERTY LINES TO THE  
BEST OF MY KNOWLEDGE AND BELIEF.

*Robert M. Baerenwald*  
ROBERT M. BAERENWALD  
WISCONSIN REGISTERED LAND SURVEYOR, S-1508

*Nov. 3, 1987*  
DATE JOB NO. 1332

NOTE: THIS IS NOT A CERTIFIED COPY UNLESS SEALED.

16VP 12, 13