


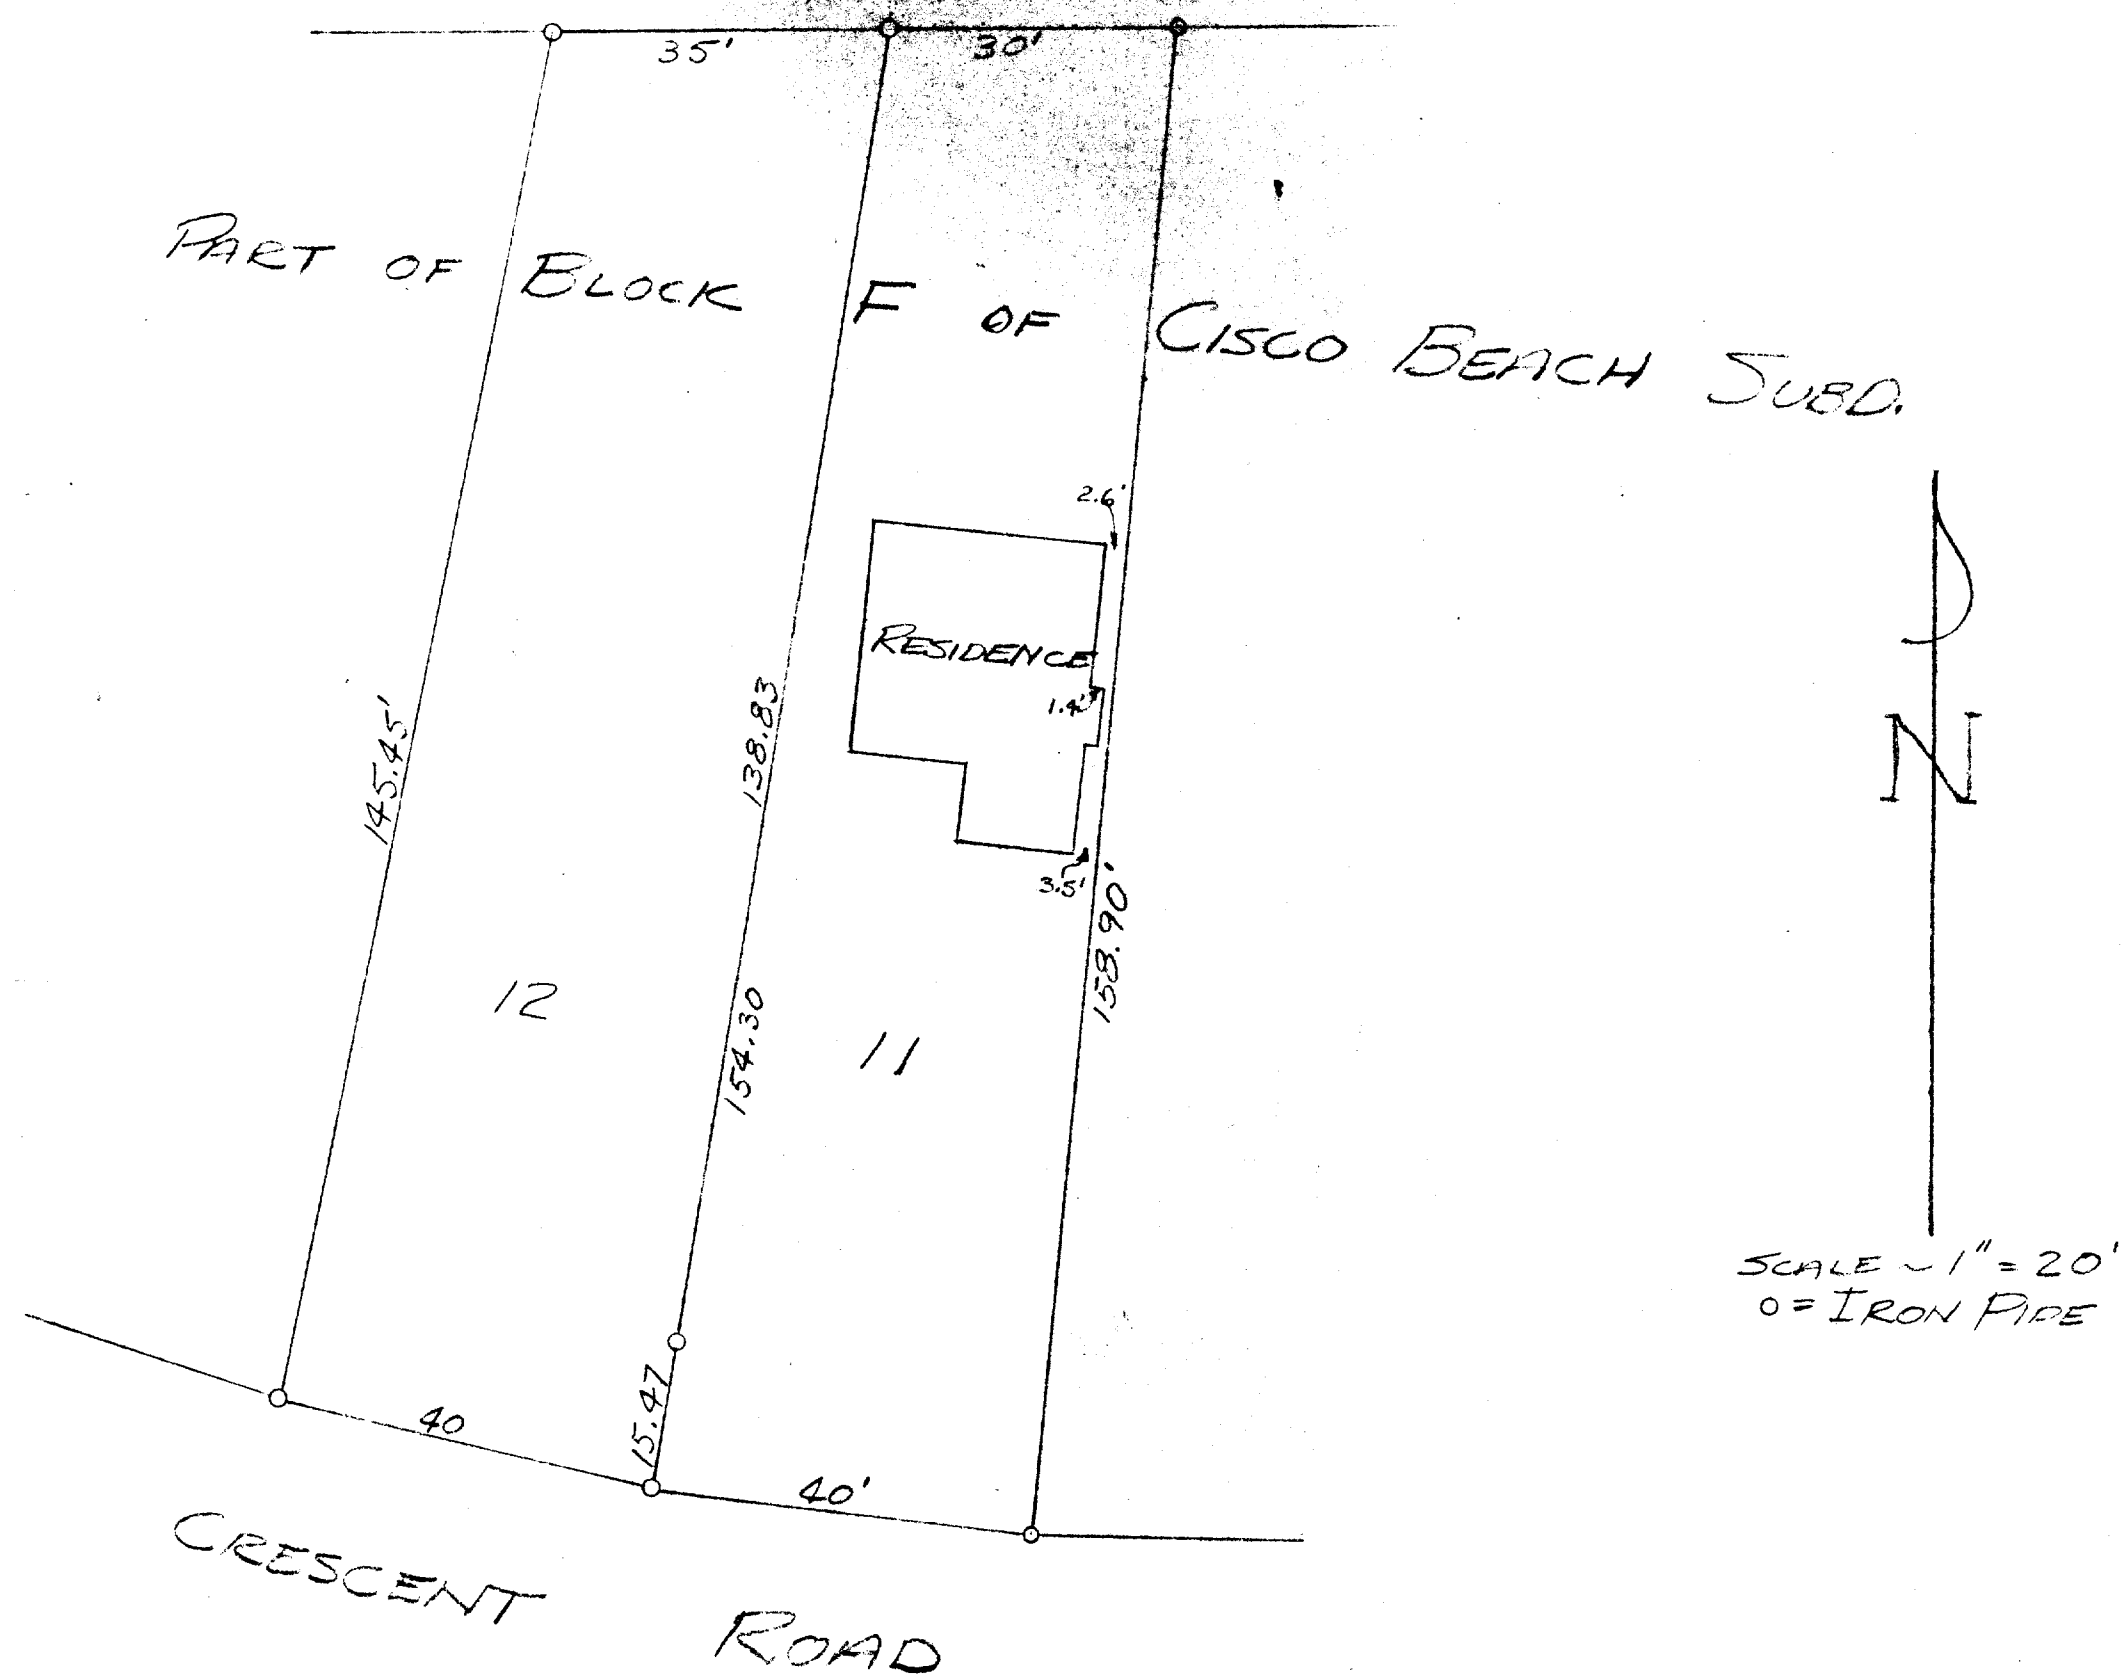

PLAT OF SURVEY OF LOTS 11 & 12 OF
 BLOCK F OF CISCO BEACH SUBDIVISION,
 TOWNSHIP 17E OF WALWORTH COUNTY, WISCONSIN.
 MAY 1950

Douglas L. Jensen
 COUNTY SURVEYOR