


OF Lot 33 except the northerly 5 feet and Lot 35, Lake Geneva Club, section 18, T 1 N, R 17 E, Town of Linn, Walworth County, Wisconsin.

SURVEYED BY: Jensen Surveying & Mapping, S.C.
Elkhorn, Wis. 53121
(414) 723-3434

RECEIVED

MAPPING DATE; MAY 14, 1987

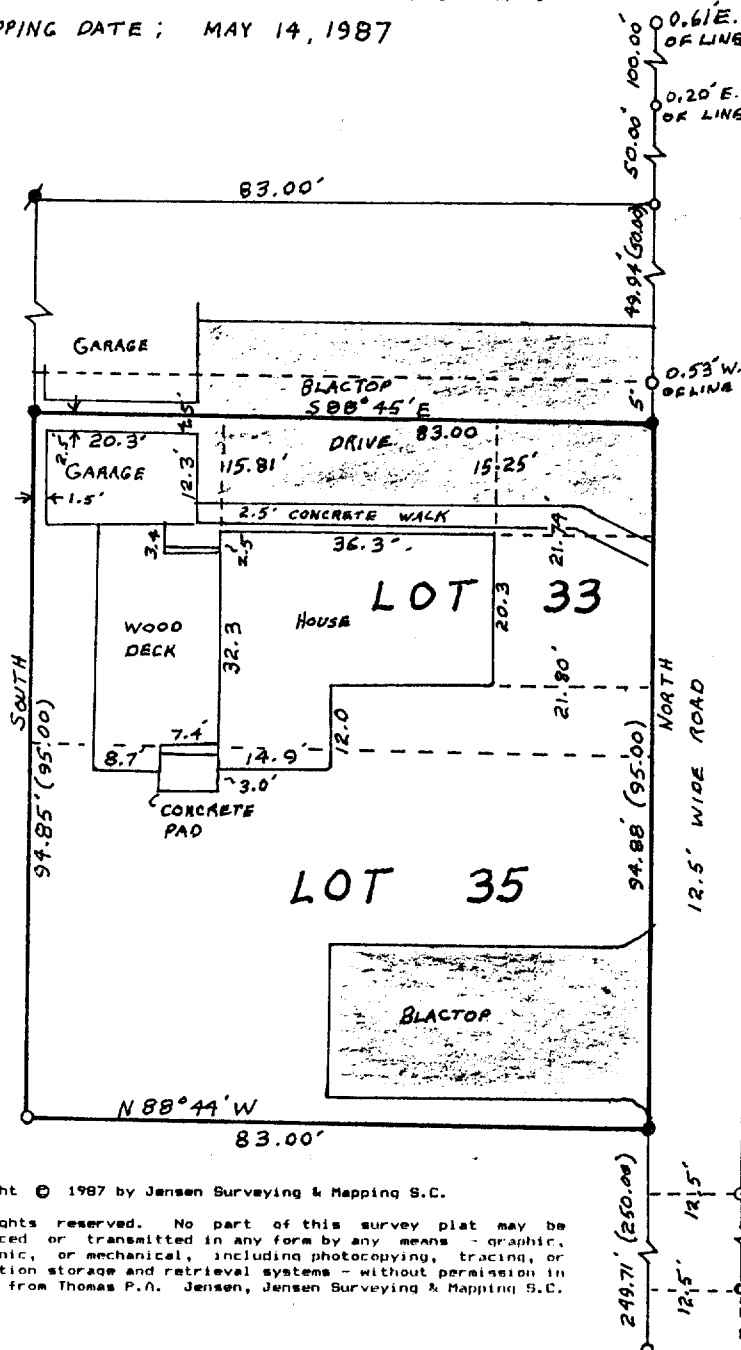

- FOUND IRON PIPE
- SET IRON ROD
- ✱ FOUND IRON ROD

N
↑
BEARINGS REFERENCED TO
THE ROAD LINE

SCALE: 1" = 20'

All rights reserved. No part of this survey plat may be reproduced or transmitted in any form by any means - graphic, electronic, or mechanical, including photocopying, tracing, or information storage and retrieval systems - without permission in writing from Thomas P.N. Jensen, Jensen Surveying & Mapping S.C.

1987.046