


OUTLOT 1
(PRIVATE ROAD)

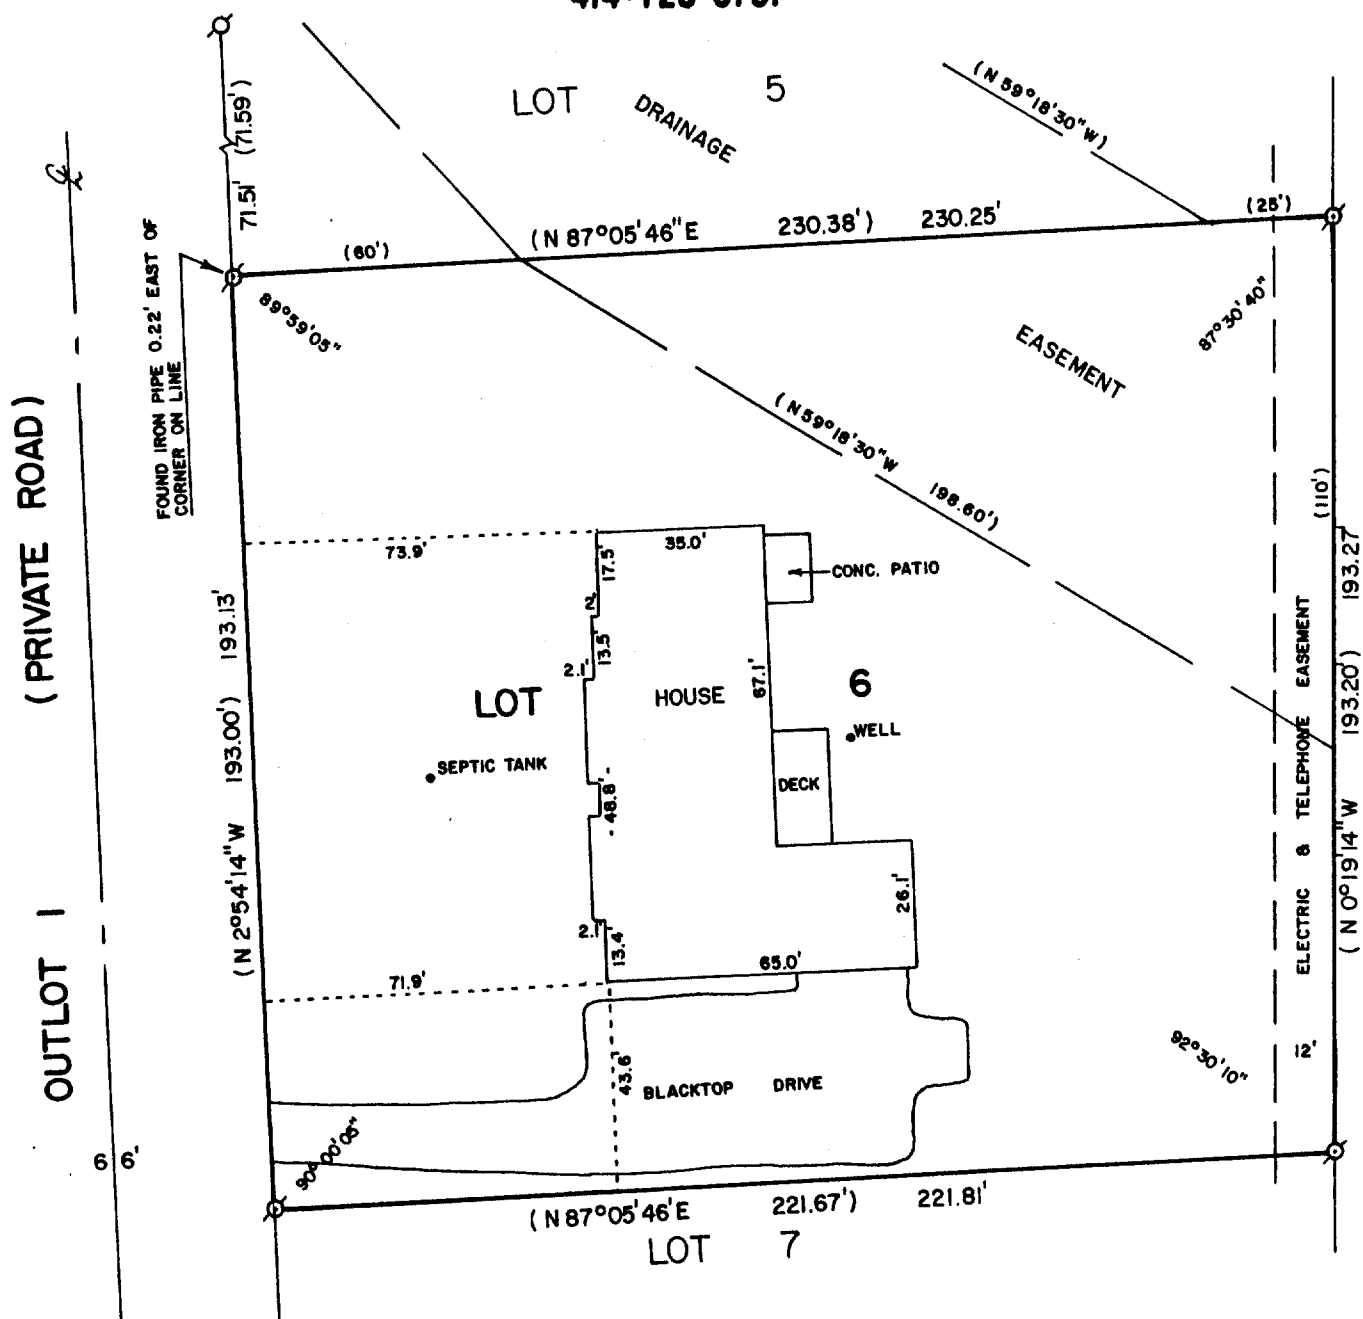

LOT 6 OF ACADEMY ESTATES, LOCATED IN THE NORTH-
EAST 1/4 AND THE SOUTHEAST 1/4 OF SECTION 18,
T1N,R17E, WALWORTH COUNTY, WISCONSIN.

RECEIVED



LEGEND

Ø - IRON PIPE FOUND
() - RECORDED AS

THIS SURVEY IS MADE FOR THE USE OF THE PRESENT OWNERS OF THE PROPERTY, AND ALSO THOSE WHO PURCHASE, MORTGAGE, OR GUARANTEE THE TITLE THERETO WITHIN ONE (1) YEAR FROM DATE HEREOF.

David F. Abell
DAVID F. ABELL
WISCONSIN REGISTERED LAND SURVEYOR, S-1596

DATE December 8, 1987 JOB NUMBER - 87200

NOTE: THIS IS NOT A CERTIFIED COPY UNLESS SEALED.