


COOPER SURVEYING SERVICES

Rural - Residential - Commercial

Route 3, Box 255 :: Elkhorn, Wisconsin 53121

Phone (414) 723-6265

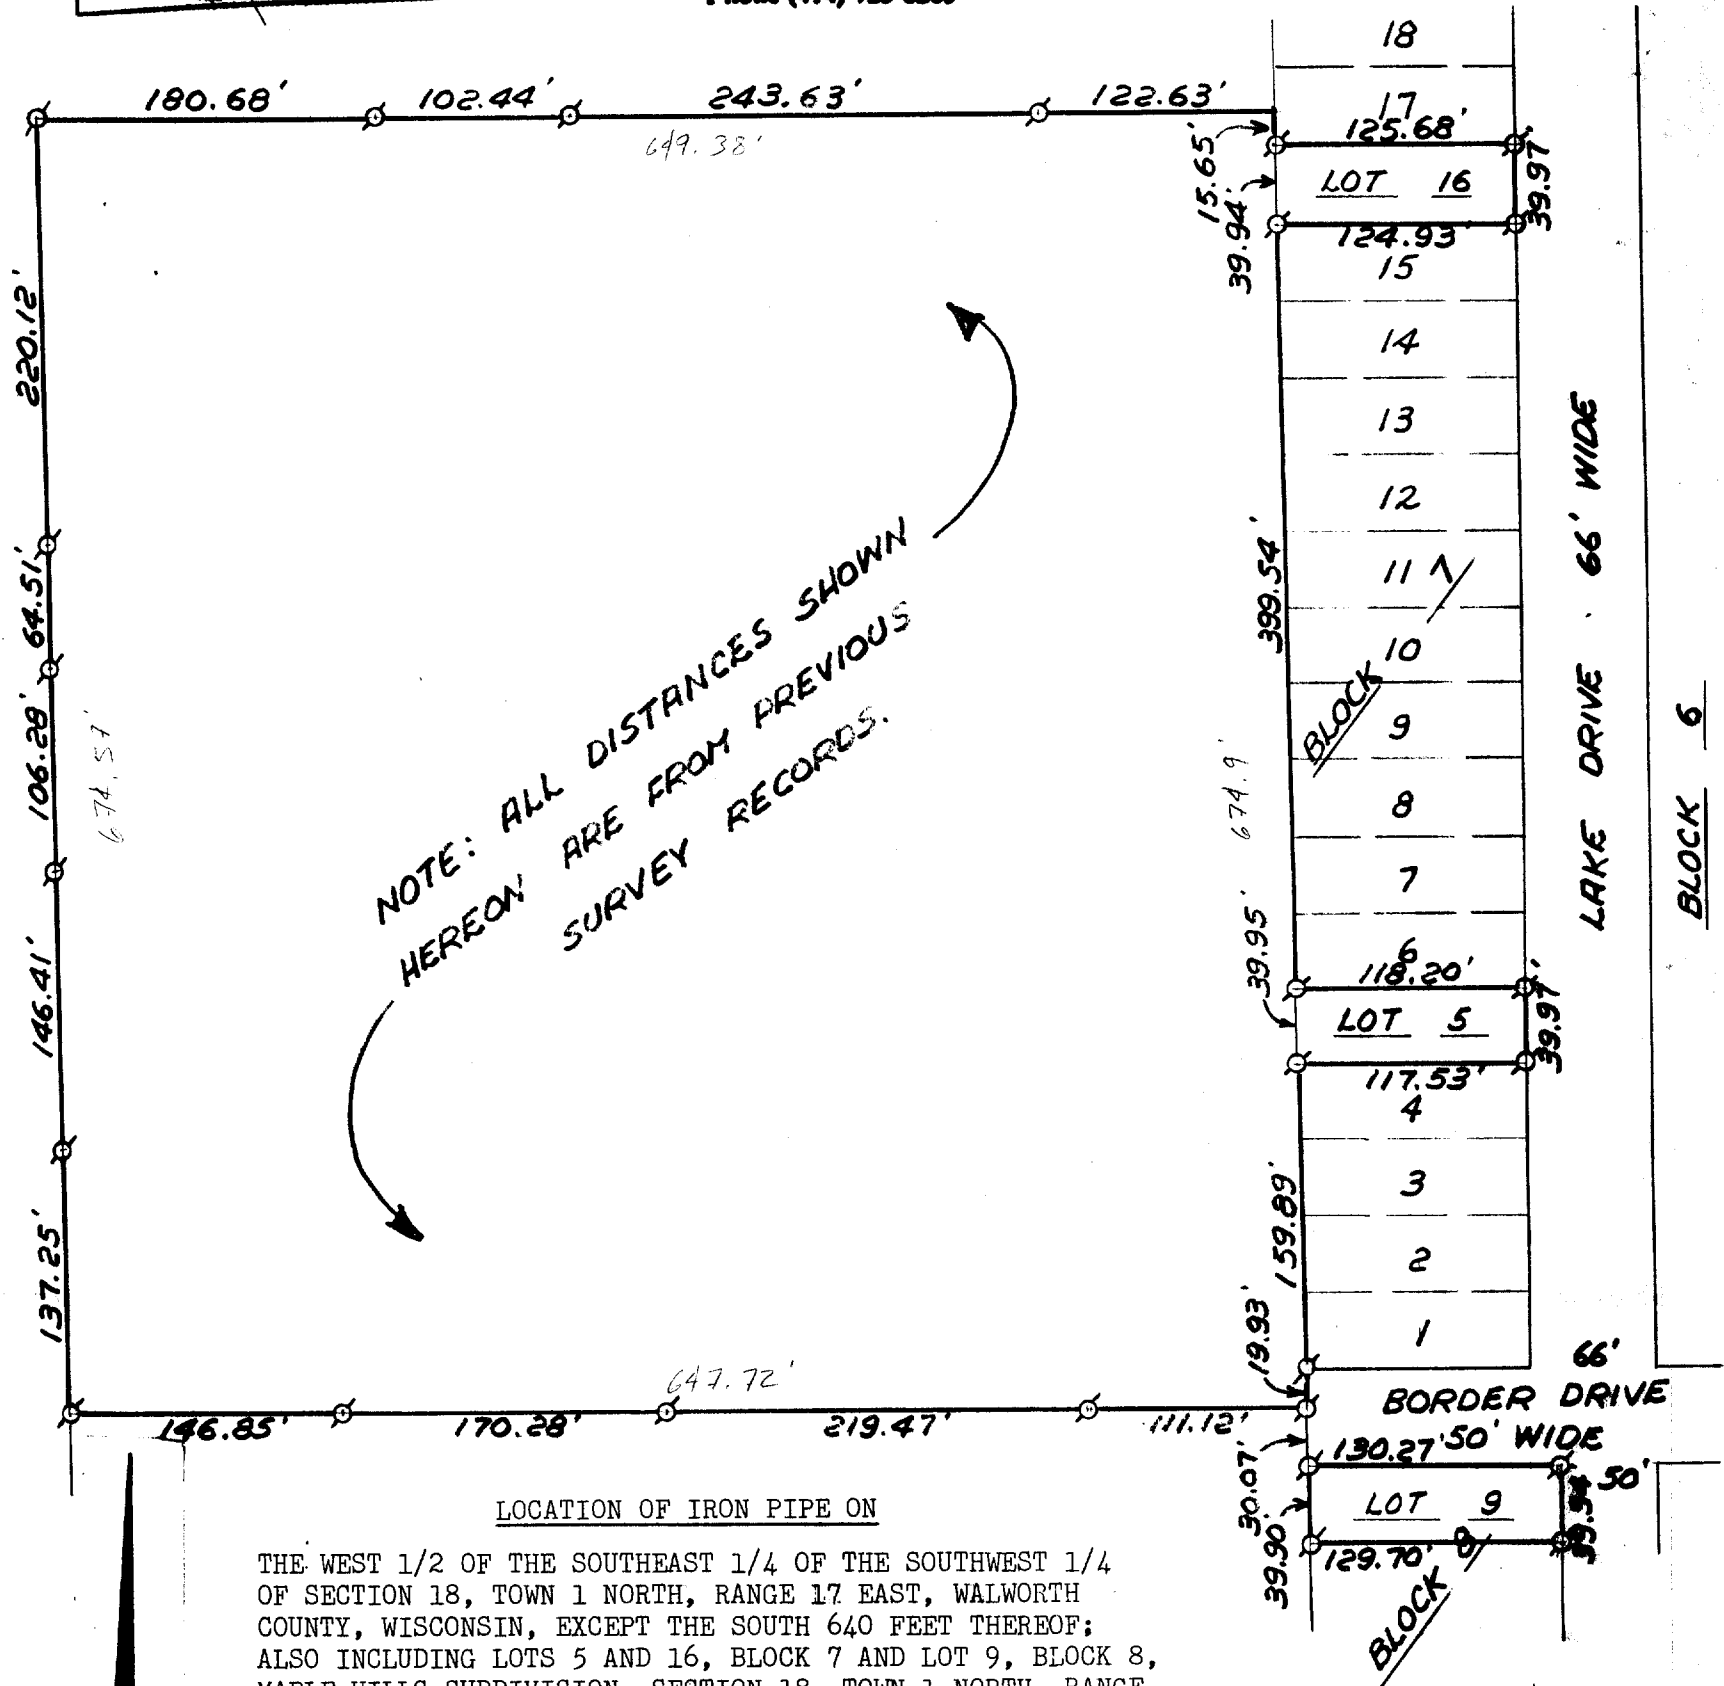


LOCATION OF IRON PIPE ON

THE WEST 1/2 OF THE SOUTHEAST 1/4 OF THE SOUTHWEST 1/4 OF SECTION 18, TOWN 1 NORTH, RANGE 17 EAST, WALWORTH COUNTY, WISCONSIN, EXCEPT THE SOUTH 640 FEET THEREOF; ALSO INCLUDING LOTS 5 AND 16, BLOCK 7 AND LOT 9, BLOCK 8, MAPLE HILLS SUBDIVISION, SECTION 18, TOWN 1 NORTH, RANGE 17 EAST, WALWORTH COUNTY, WISCONSIN.

ORDERED BY: MAUDE BRENNAN
%KEEFE REALTY


LEGEND

- IRON PIPE SURVEY MONUMENT FOUND
- 1" x 24" IRON PIPE SET
- ()—RECORD DIMENSION

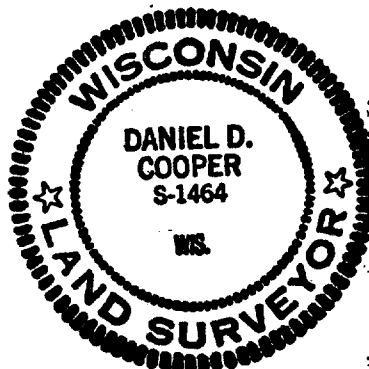

I HEREBY CERTIFY THAT I HAVE LOCATED THE IRON PIPE SURVEY STAKES ON THE PERIMETER OF THE PARCELS AS SHOWN HEREON.

Daniel D. Cooper
DANIEL D. COOPER, RLS NO. 1464
DATED THIS 2nd DAY OF July, 1984.

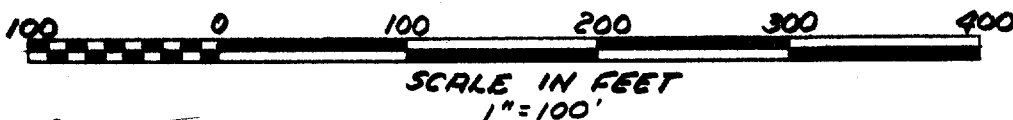

PROJ. NO. 1923

117-866