
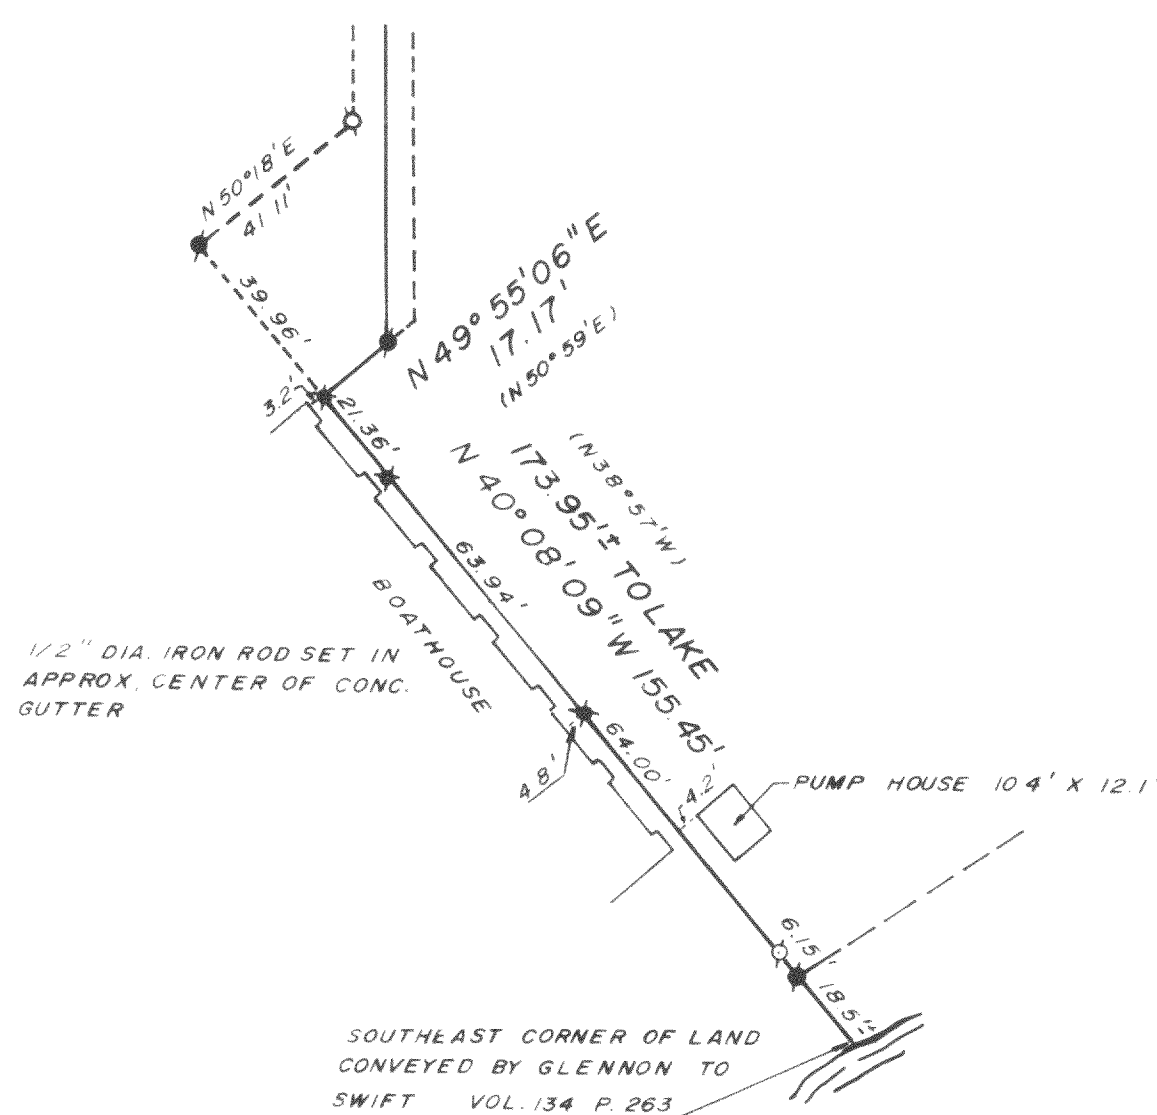
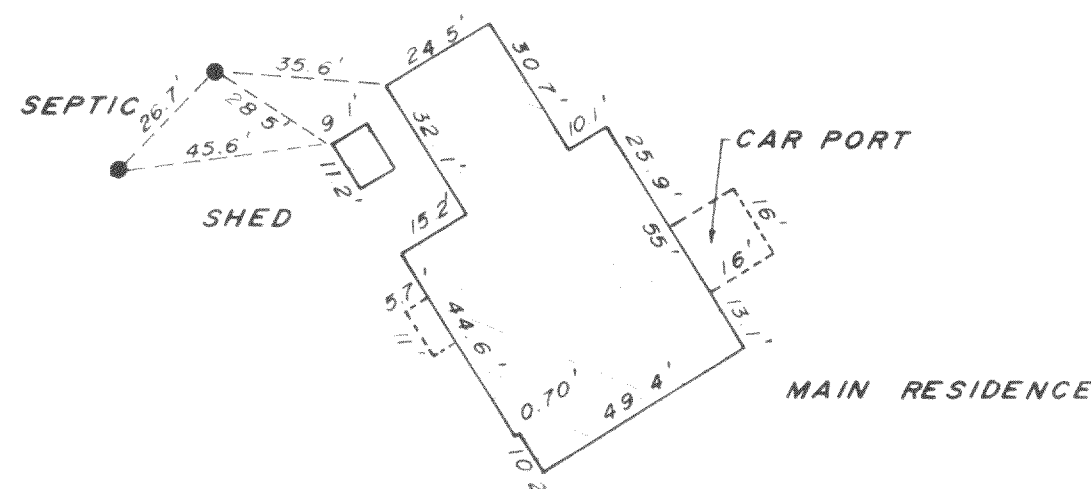
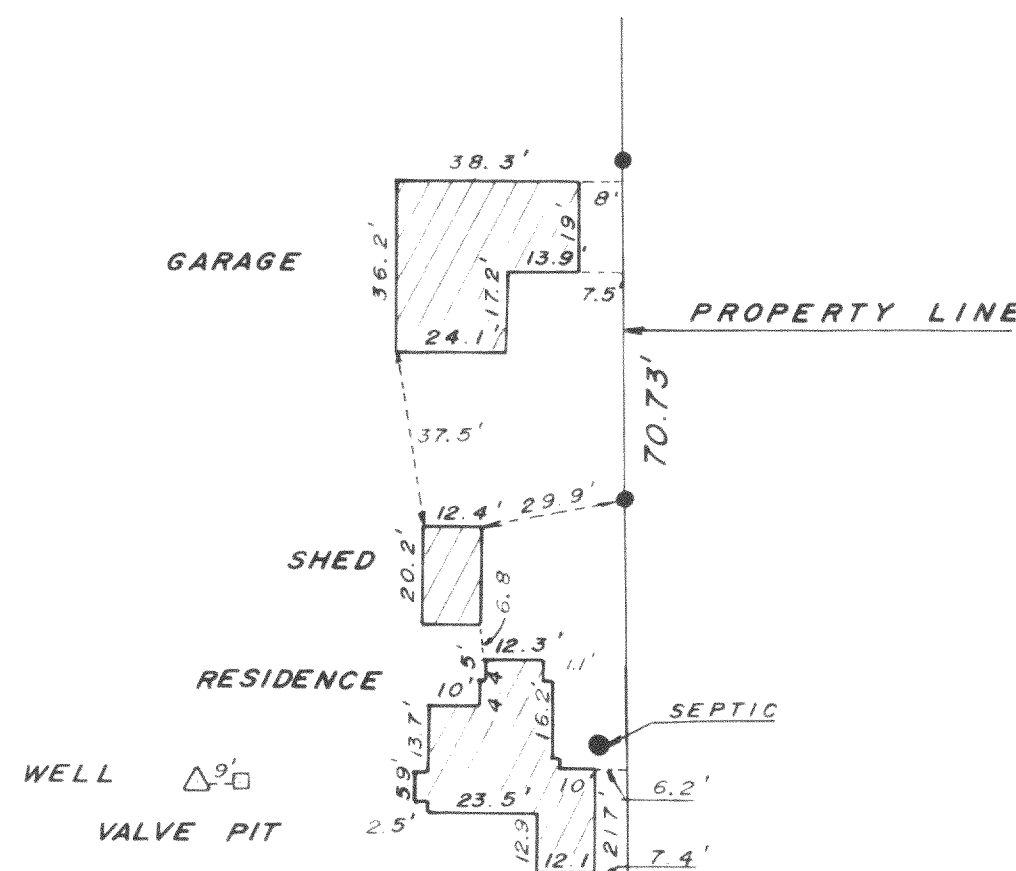
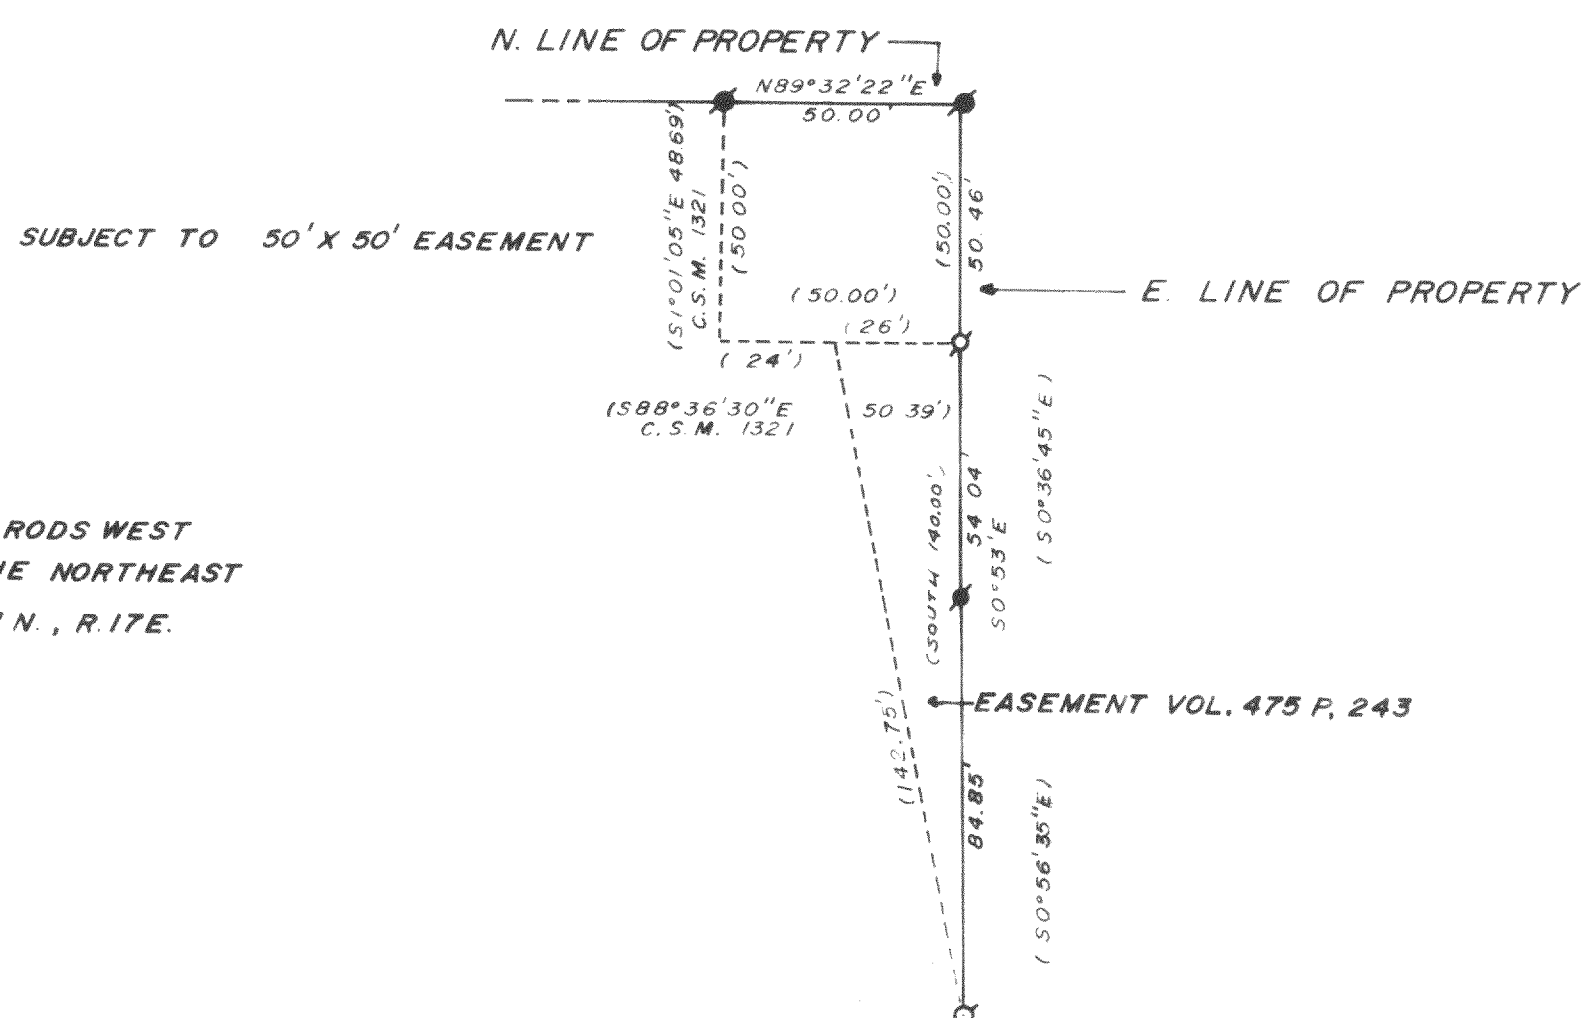


PARCEL OF LAND LOCATED IN THE NORTHEAST 1/4
OF SECTION 3, T.1N., R.17E., WALWORTH COUNTY, WI.

ORDERED BY: EARL A. DRECHSLER
PALM BEACH, FL.

OWNER GAIL D. BROWN
7575 LAKE ST
RIVER FOREST, ILL 60305

This easement area is shown as part of
Certified Survey Map No. 1321, recorded
Nov. 3, 1983. Other owners gave Quit Claim
Deeds to the Trust of William Wrigley over
an area (1370.73' x 50') which included this
50' x 50' area. However, no deeds were found
on record from Drechsler to Wrigley over the
subject area. In my opinion, Drechsler retains
title to this area subject to an easement.

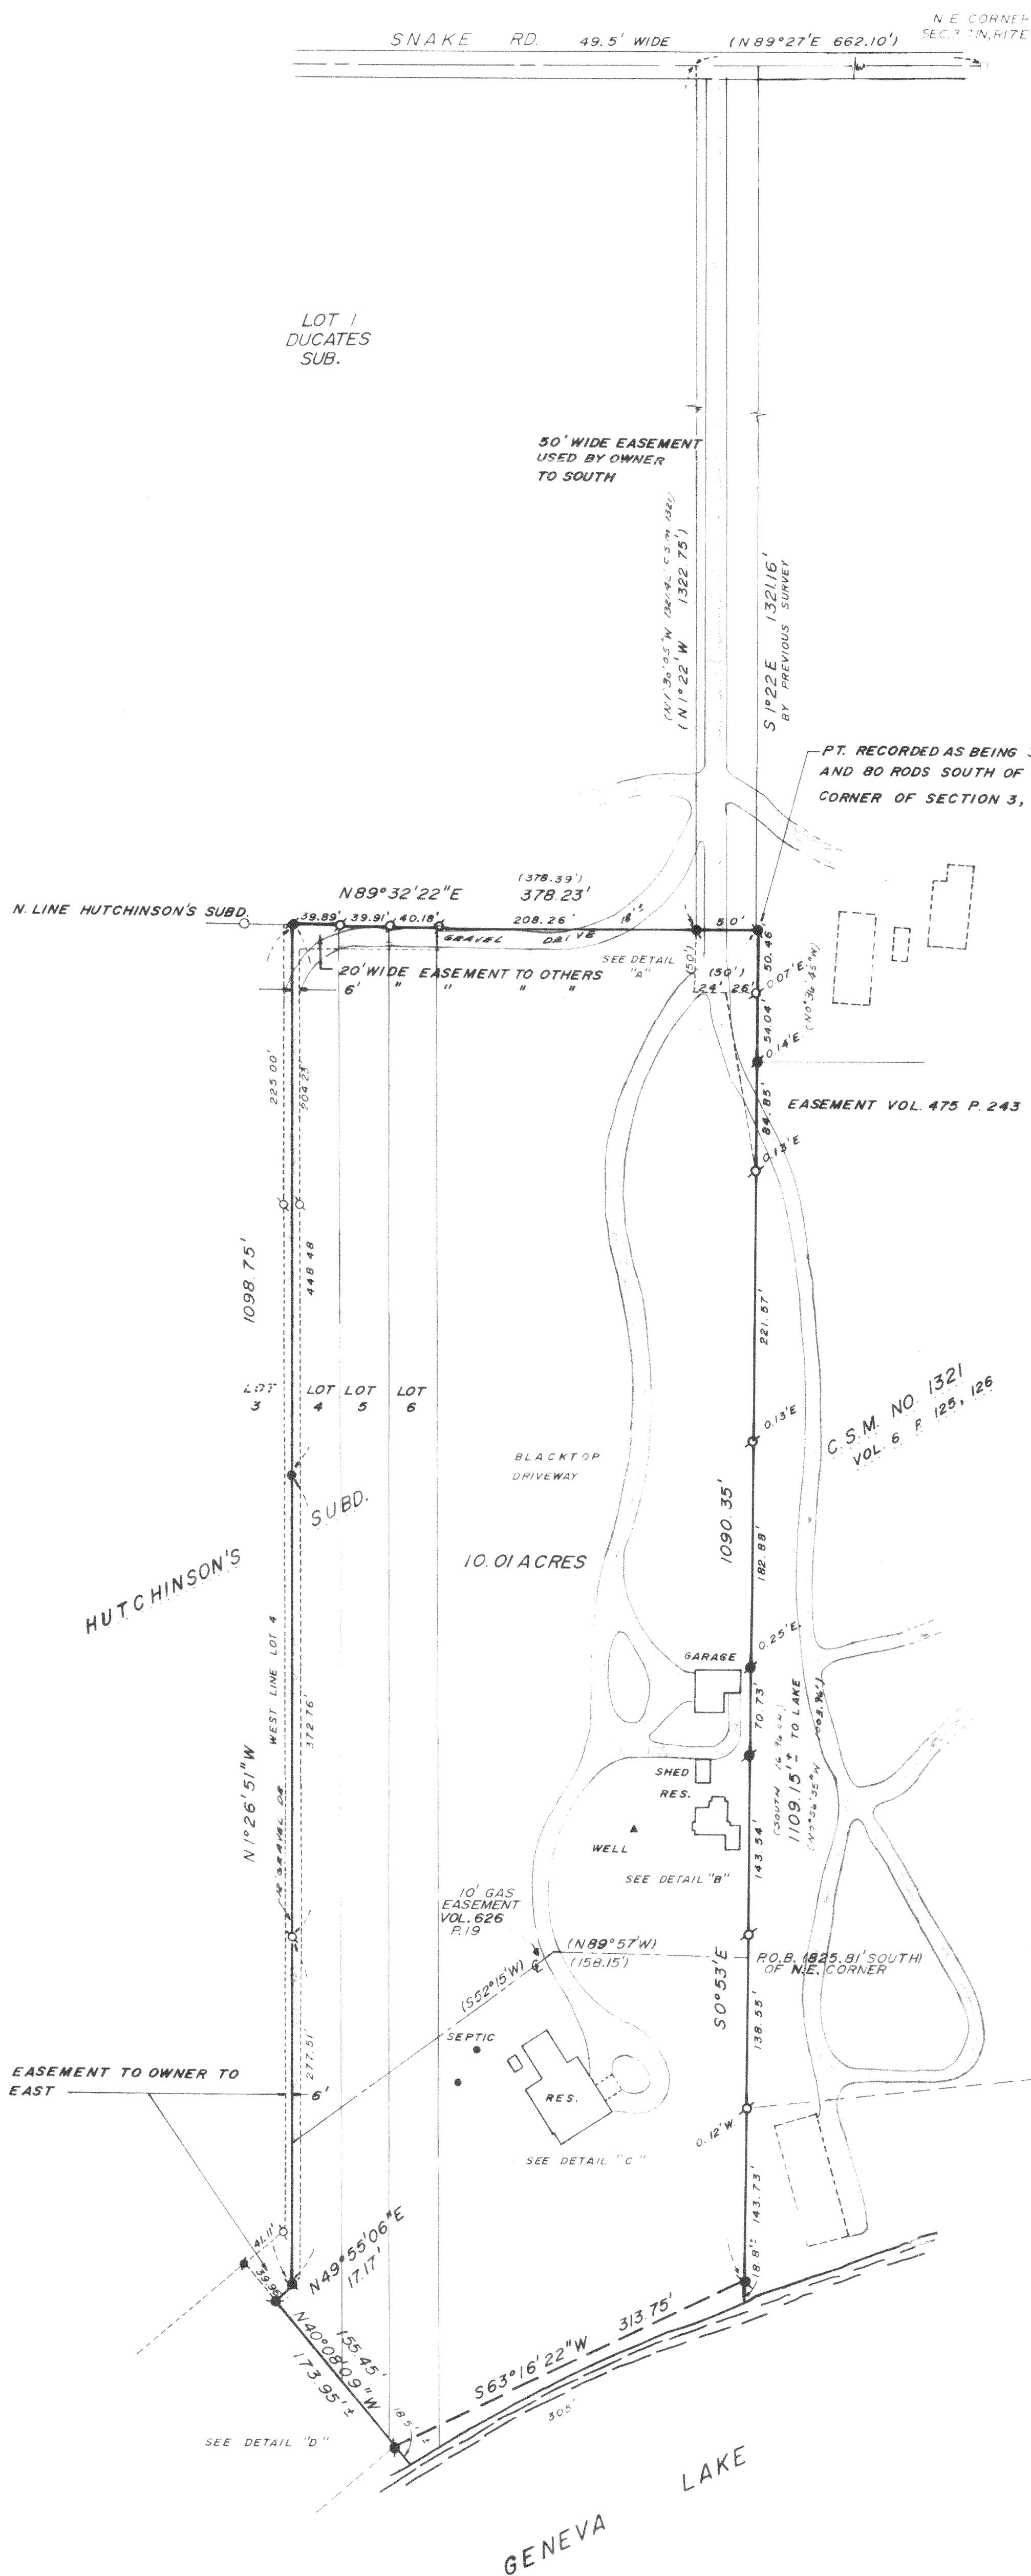

- Legend
- FOUND IRON PIPE
 - FOUND IRON ROD
 - FOUND BRASS CAPPED MONUMENT
 - FOUND CONCRETE MONUMENT
 - CHISEL CUT IN CONCRETE
 - SET IRON ROD, 24" LONG, WEIGHING 1.5 LBS./LINEAL FT., 3/4" DIA.
 - SET IRON ROD, 30" LONG, WEIGHING 4.5 LBS./LINEAL FT., 1-1/8" DIA.
 - RECORDED AS DIMENSION
 - EXISTING FENCE

I hereby certify that I have surveyed the above described property and that the above map is a true representation thereof and shows the size and location of the property, its exterior boundaries, the location of all visible structures and dimensions of all principal buildings thereon, boundary fences, apparent easements, roadways and visible encroachments, if any.

This survey is made for the use of the present owners of the property, and also those who purchase, mortgage, or guarantee the title thereto within one year from date hereof.

KENNETH B. ABERNATHY, JR.
WISCONSIN REGISTERED LAND SURVEYOR,
S-1594
Date: 10-18-87 Job No. 871001

This survey retraces a previous survey done by L. L. Jensen dated Jan. 1963. Bearings are based to match this survey. There is also an additional survey done by L.L. Jensen over this area dated Aug. 1941.