


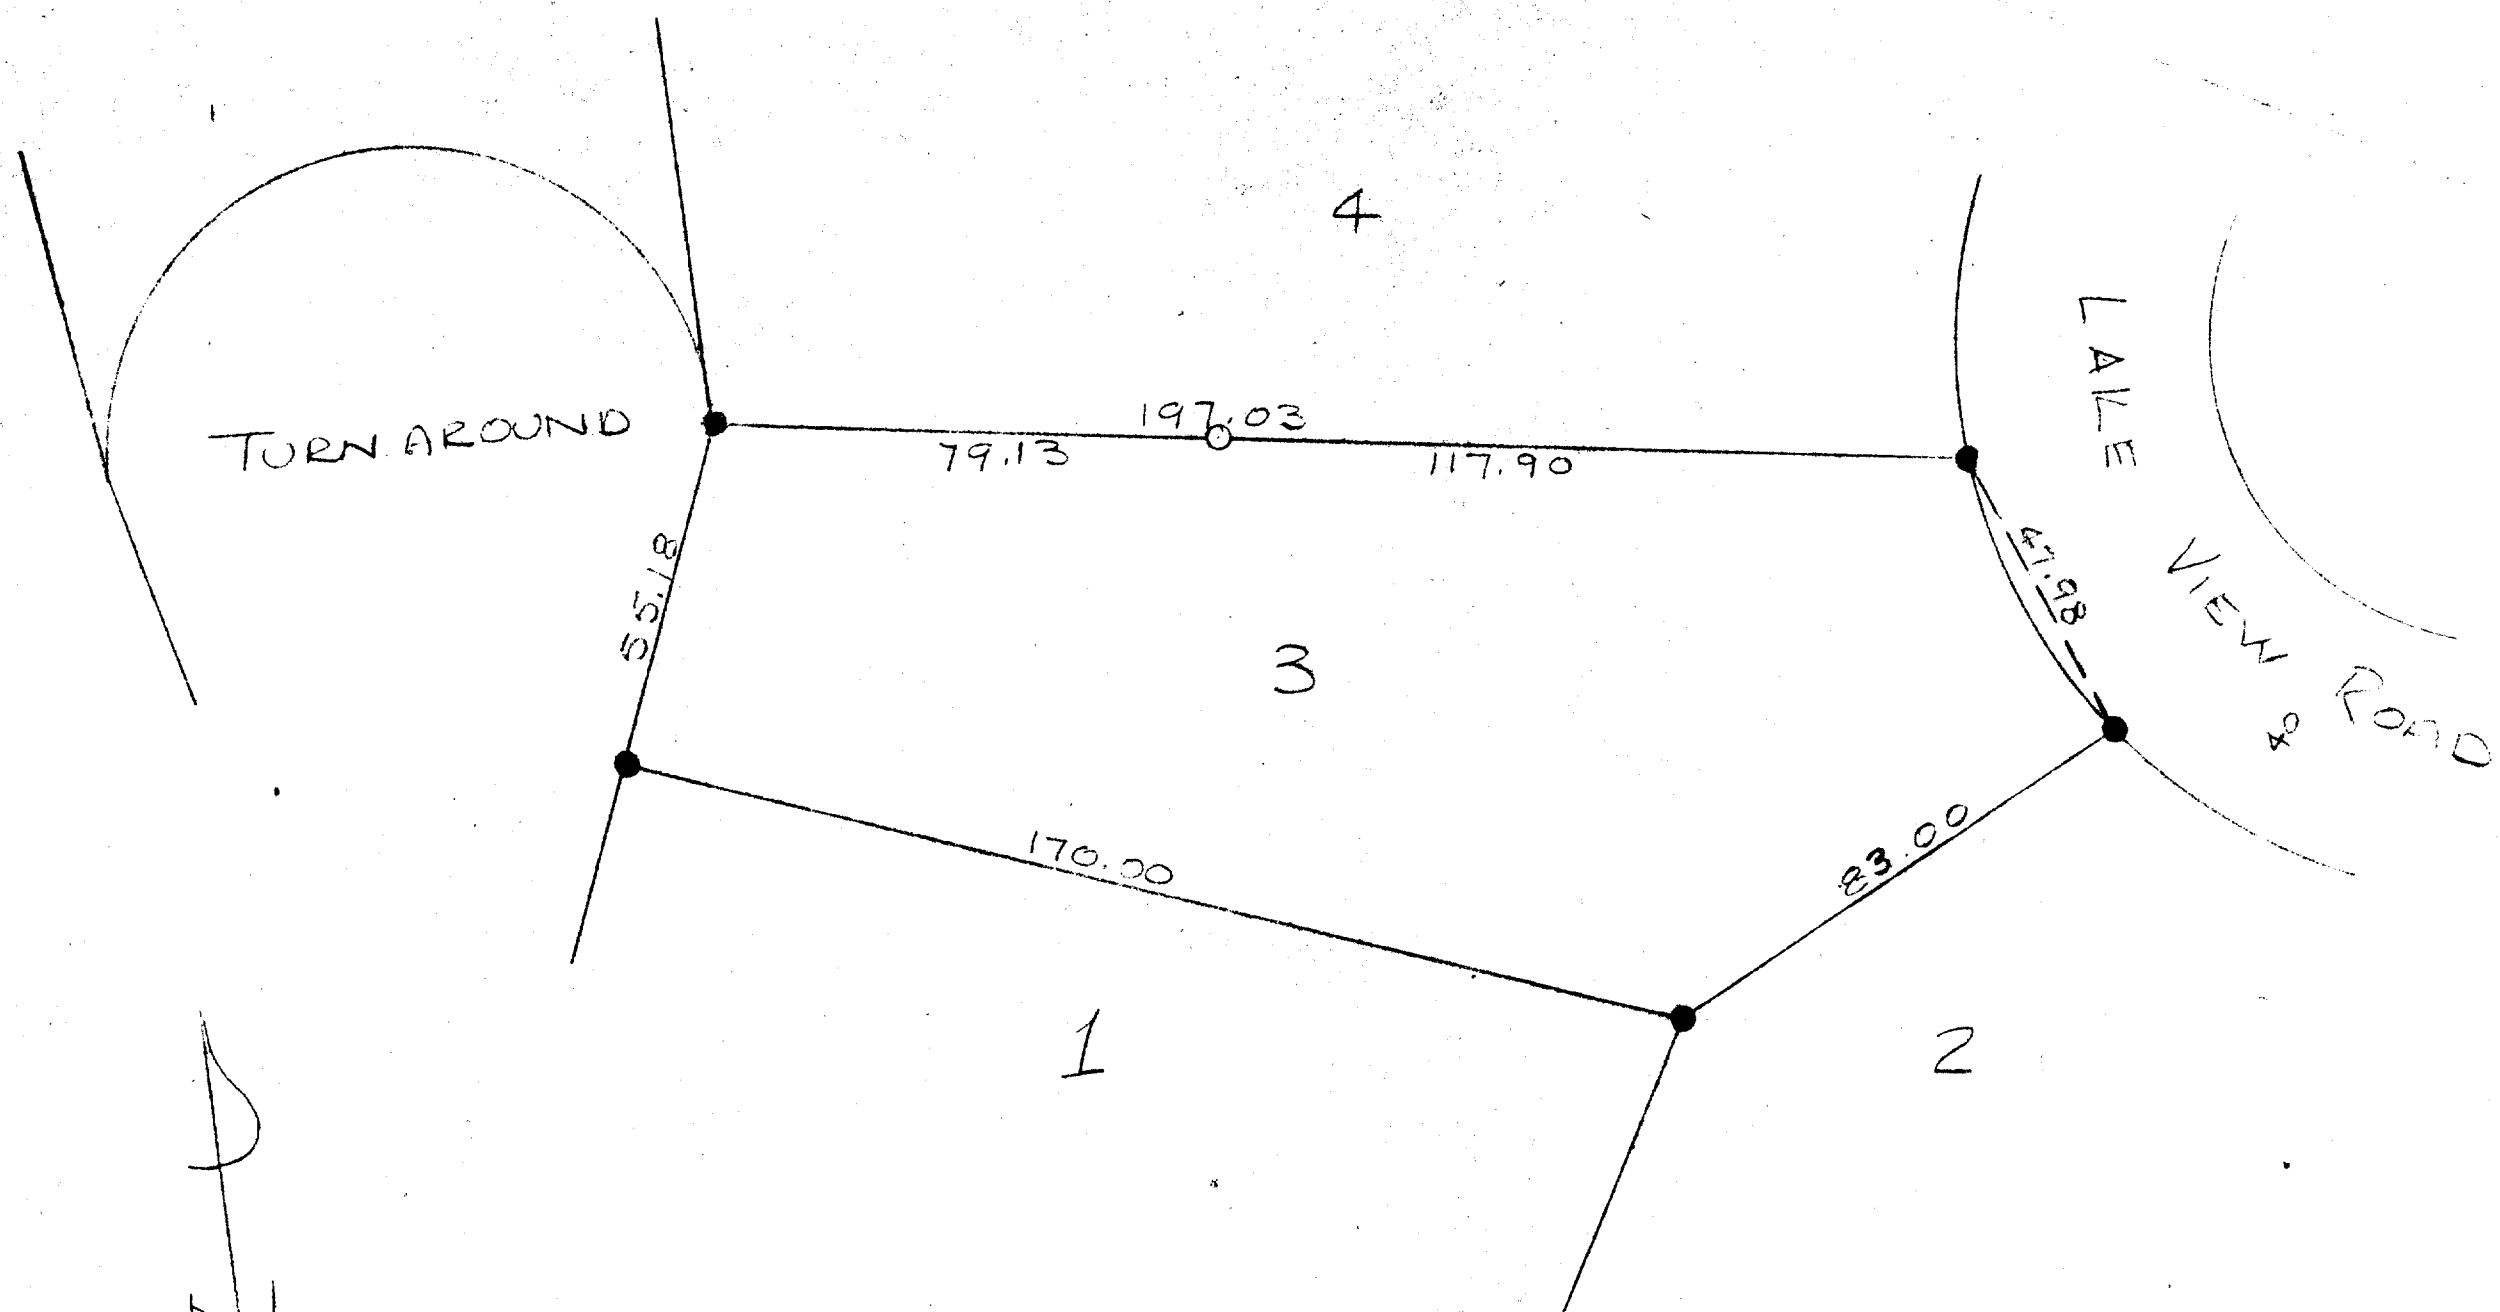

SCALE 1" = 30'
 ● = CORNER MONU.
 ○ = IRON PIPE

PLAT OF SURVEY OF LOT 3 OF BLOCK 1 OF
 WOODDALE ADDITION, LOCATED IN SECTION
 9, T1N R1E, WALWORTH COUNTY, WIS.

AUGUST, 1950

Lloyd L. Jensen
 COUNTY SURVEYOR