


WALWORTH COUNTY
SURVEYING & MAPPING
LAKE GENEVA, WISCONSIN

LOURET AVENUE

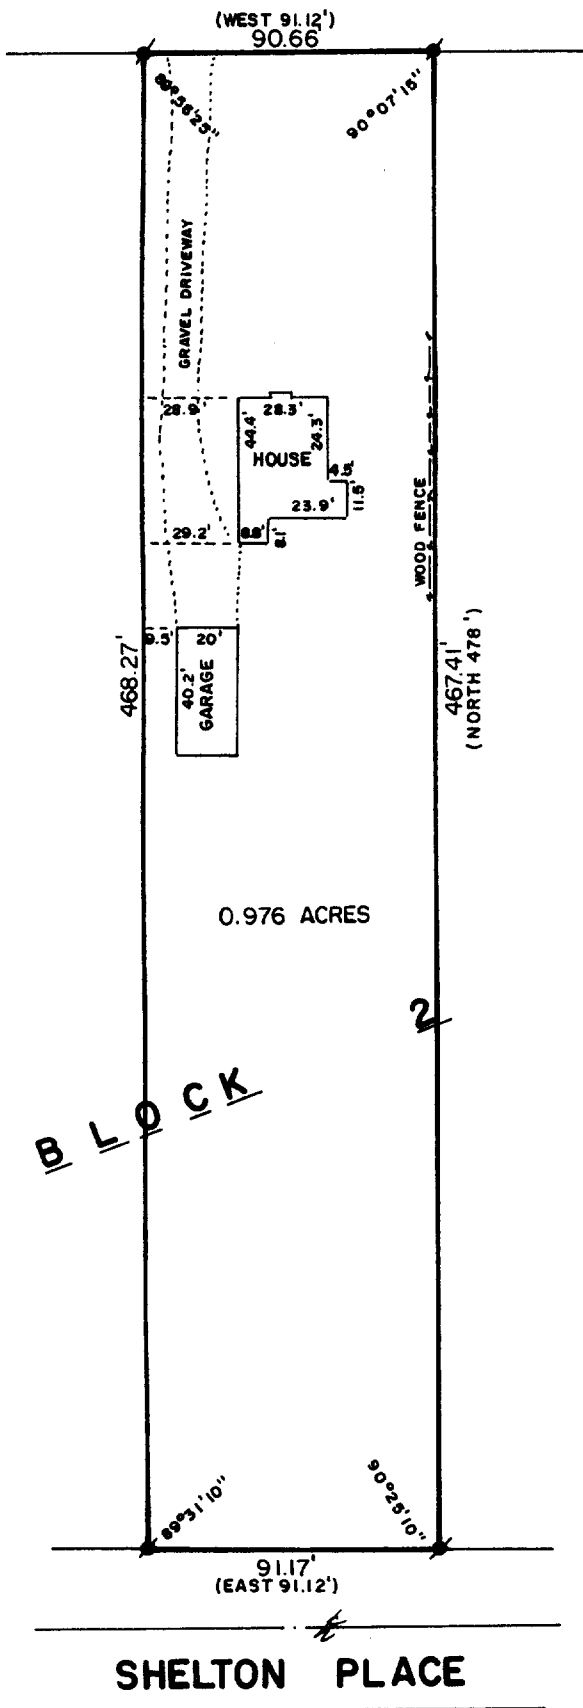


PLAT OF SURVEY OF

The East 1/2 of a certain tract of land described as: Commencing at a point in the North line of Block 2, in Rowena Park (a subdivision of a part of Section 5, Township 1 North, Range 17 East, said County and State) at a point 1046.1 feet East of the Northwest corner of said Block 2; run thence South 476 feet more or less to the North line of the highway; thence Easterly in the North line of said highway 182.25 feet; thence North 478 feet more or less to the North line of said Block 2; thence West 182.25 feet in the North line of said Block to the place of commencement in Walworth County, Wisconsin.

Tax Key No. IRP 00021A

ORDERED BY: CENTURY 21 GENEVA LAKE
503 CENTER STREET
LAKE GENEVA, WISCONSIN
53147

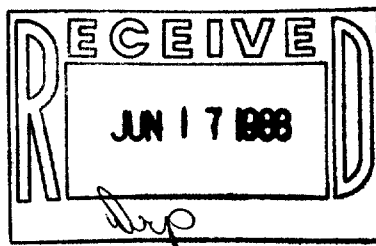

SCALE: 1"=30'

• -CONCRETE MONUMENT FOUND
() -RECORDED AS

I, ROBERT M. BAERENWALD, DO HEREBY CERTIFY THAT I HAVE SURVEYED THE PROPERTY HEREON DESCRIBED ACCORDING TO THE OFFICIAL RECORDS AND THAT THE PLAT HEREON IS A CORRECT REPRESENTATION OF THE PROPERTY LINES TO THE BEST OF MY KNOWLEDGE AND BELIEF.

Robert M. Baerenwald
ROBERT M. BAERENWALD
WISCONSIN REGISTERED LAND SURVEYOR, S-1508

May 16, 1988
DATE JOB NO. 1524

NOTE: THIS IS NOT A CERTIFIED COPY UNLESS SEALED.