



ABELL
SURVEYING & MAPPING
DELAVER, WISCONSIN 53115
414-728-6737

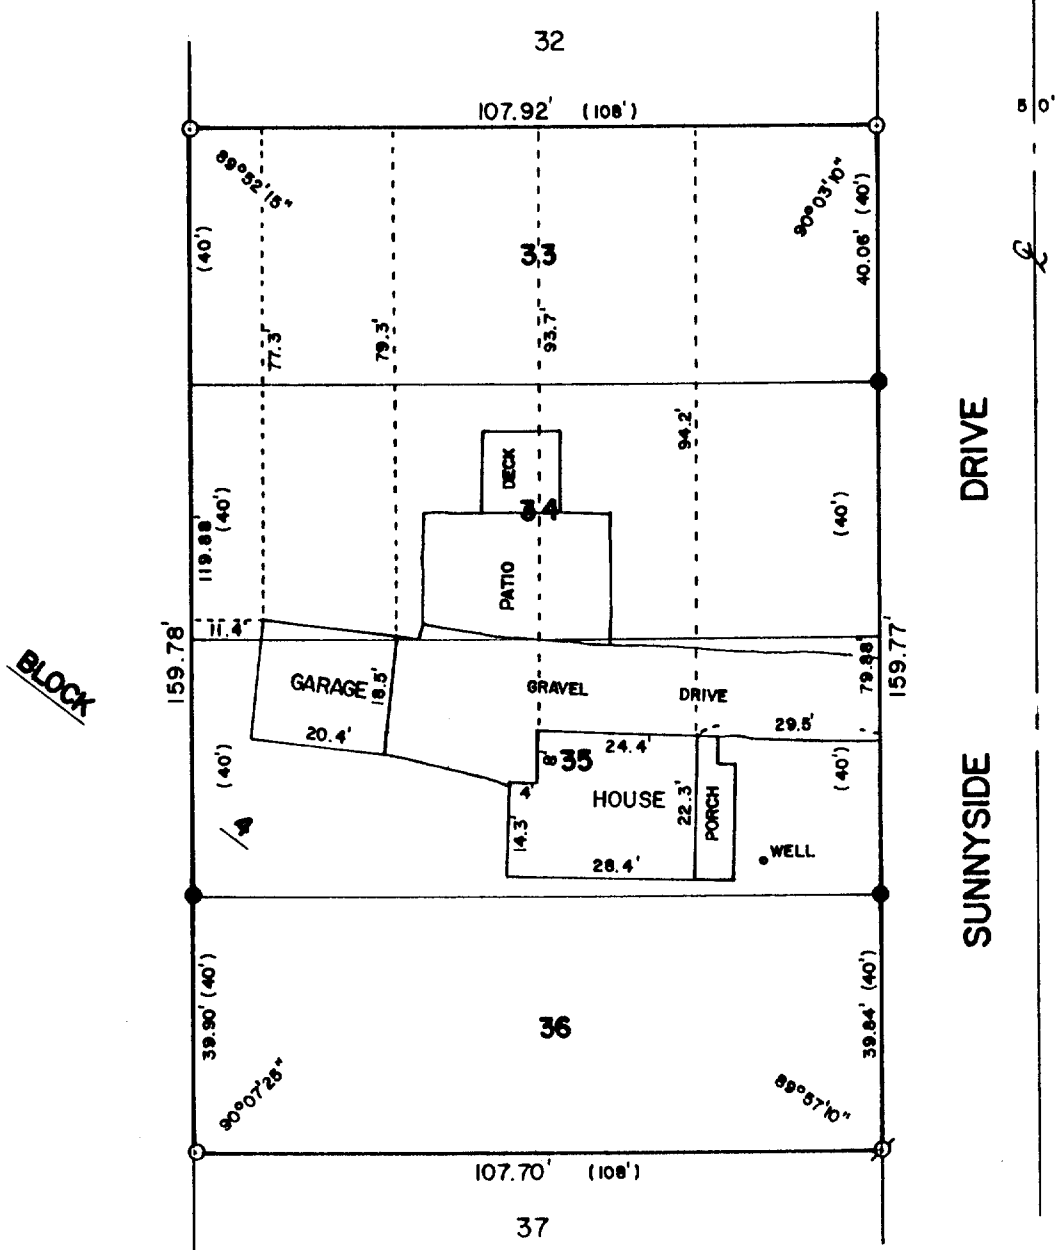

PLAT OF SURVEY OF

LOTS 33-36, BLOCK 4, MAPLE HILLS "A" SUBDIVISION,
T1N,R17E, WALWORTH COUNTY, WISCONSIN.

ORDERED BY: KEEFE REAL ESTATE
P.O. BOX 268
WALWORTH, WI. 53184

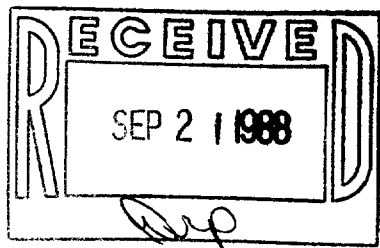

SCALE - 1"=30'

- LEGEND
- - IRON PIPE FOUND
 - - IRON ROD FOUND
 - - IRON ROD FOUND, SET 3/4" IRON ROD
 - () - RECORDED AS

I, DAVID F. ABELL, DO HEREBY CERTIFY
THAT I HAVE SURVEYED THE PROPERTY
HEREON DESCRIBED ACCORDING TO THE
OFFICIAL RECORDS AND THAT THE PLAT
HEREON IS A CORRECT REPRESENTATION
OF THE PROPERTY LINES TO THE BEST OF
MY KNOWLEDGE AND BELIEF.

David F. Abell

DAVID F. ABELL
WISCONSIN REGISTERED LAND SURVEYOR, S-1596

July 30, 1988

DATE JOB NUMBER - 88152

NOTE: THIS IS NOT A CERTIFIED COPY UNLESS SEALED.