


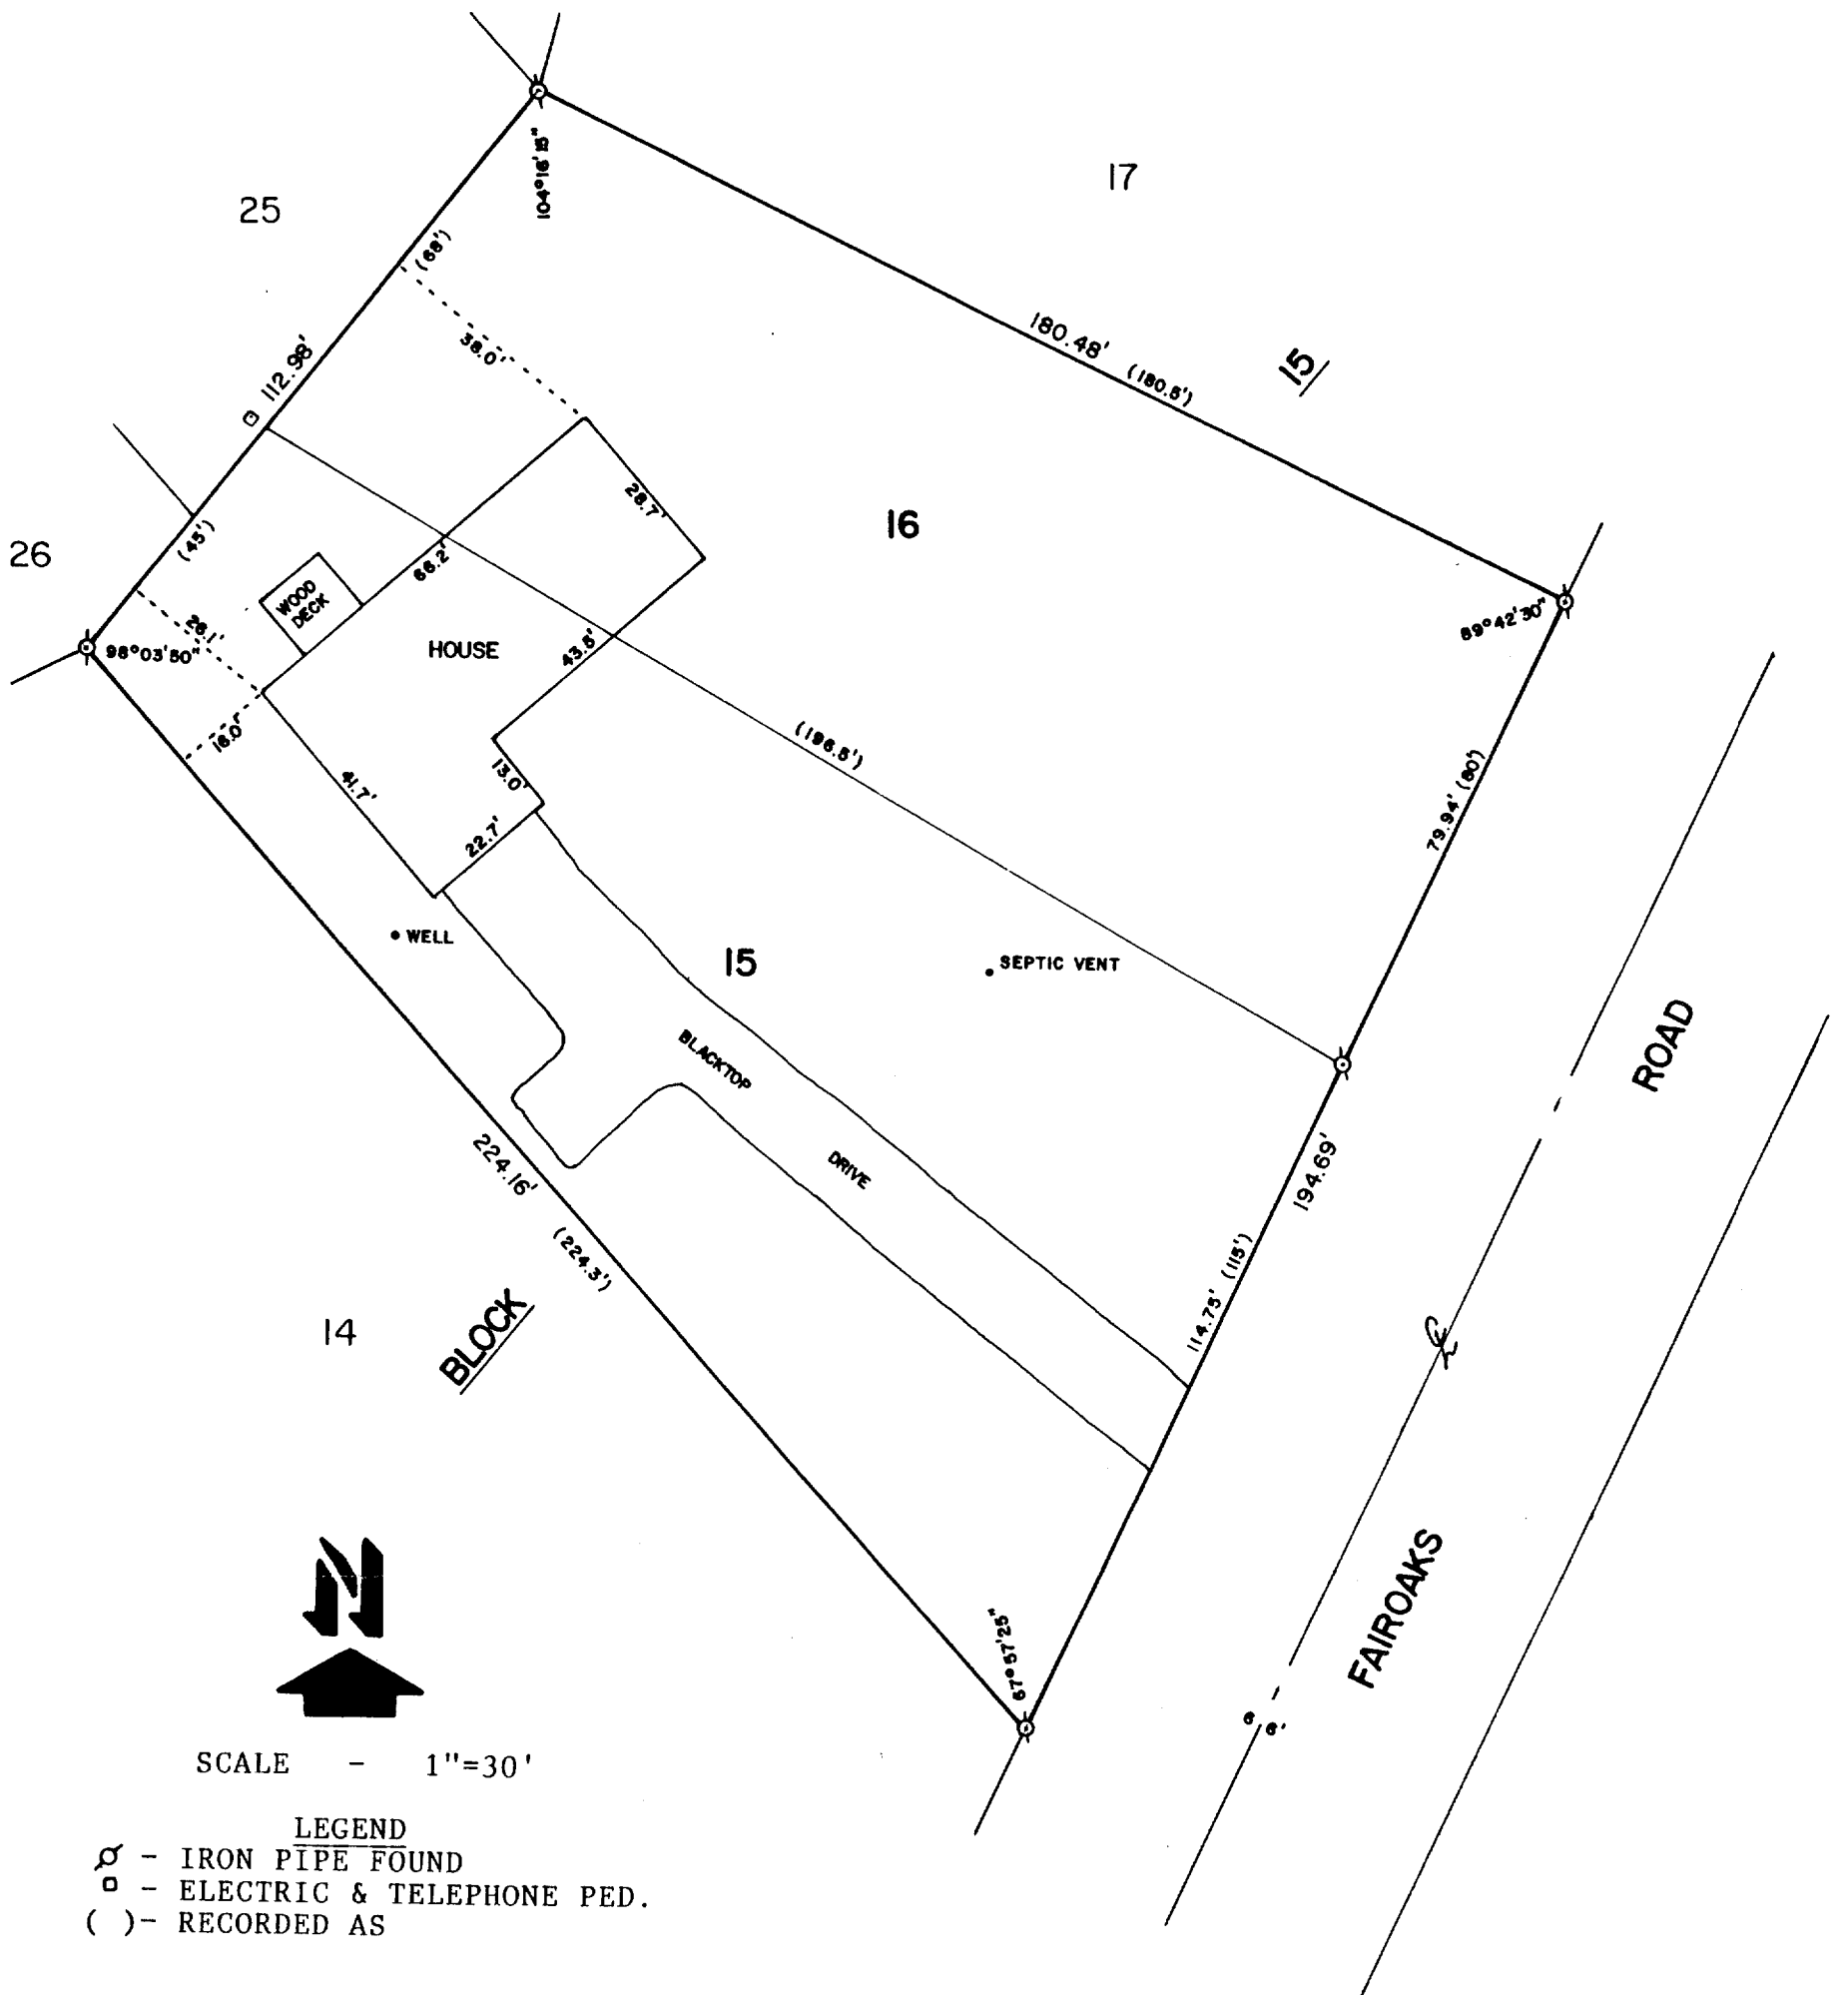


LEGEND  
 ♂ - IRON PIPE FOUND  
 □ - ELECTRIC & TELEPHONE PED.  
 ( ) - RECORDED AS

PLAT OF SURVEY OF

LOTS 15 AND 16, BLOCK 15 OF WOODDALE ADDITION,  
 LOCATED IN T1N,R17E, WALWORTH COUNTY, WISCONSIN.

ORDERED BY: LAKELAND REALTY  
 P.O. BOX 323  
 FONTANA, WI. 53125

SURVEYED BY: ABELL SURVEYING AND MAPPING  
 1140 SEQUOIA STREET  
 DELAVAN, WISCONSIN 53115  
 (414) 728-6737

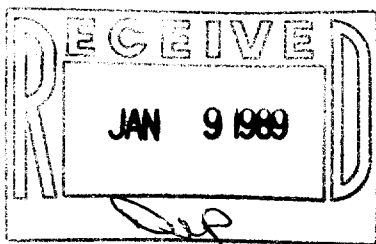

I HEREBY CERTIFY THAT I HAVE SURVEYED THE ABOVE DESCRIBED PROPERTY AND THAT THE ABOVE MAP IS A TRUE REPRESENTATION THEREOF AND SHOWS THE SIZE AND LOCATION OF THE PROPERTY, ITS EXTERIOR BOUNDARIES, THE LOCATION OF ALL VISIBLE STRUCTURES AND DIMENSIONS OF ALL PRINCIPAL BUILDINGS THEREON, BOUNDARIES FENCES, APPARENT EASEMENTS, ROADWAYS AND VISIBLE ENCROACHMENTS, IF ANY, TO THE BEST OF MY KNOWLEDGE AND BELIEF.

THIS SURVEY IS MADE FOR THE USE OF THE PRESENT OWNERS OF THE PROPERTY, AND ALSO THOSE WHO PURCHASE, MORTGAGE, OR GUARANTEE THE TITLE THERETO WITHIN ONE (1) YEAR FROM DATE HEREOF.

*David F. Abell*

DAVID F. ABELL  
 WISCONSIN REGISTERED LAND SURVEYOR, S-1596

*October 10, 1988*

DATE JOB NUMBER - 88231

NOTE: THIS IS NOT A CERTIFIED COPY UNLESS SEALED.

117-936