



ABELL
SURVEYING & MAPPING
 DELAVAN, WISCONSIN 53115
 414-728-6737

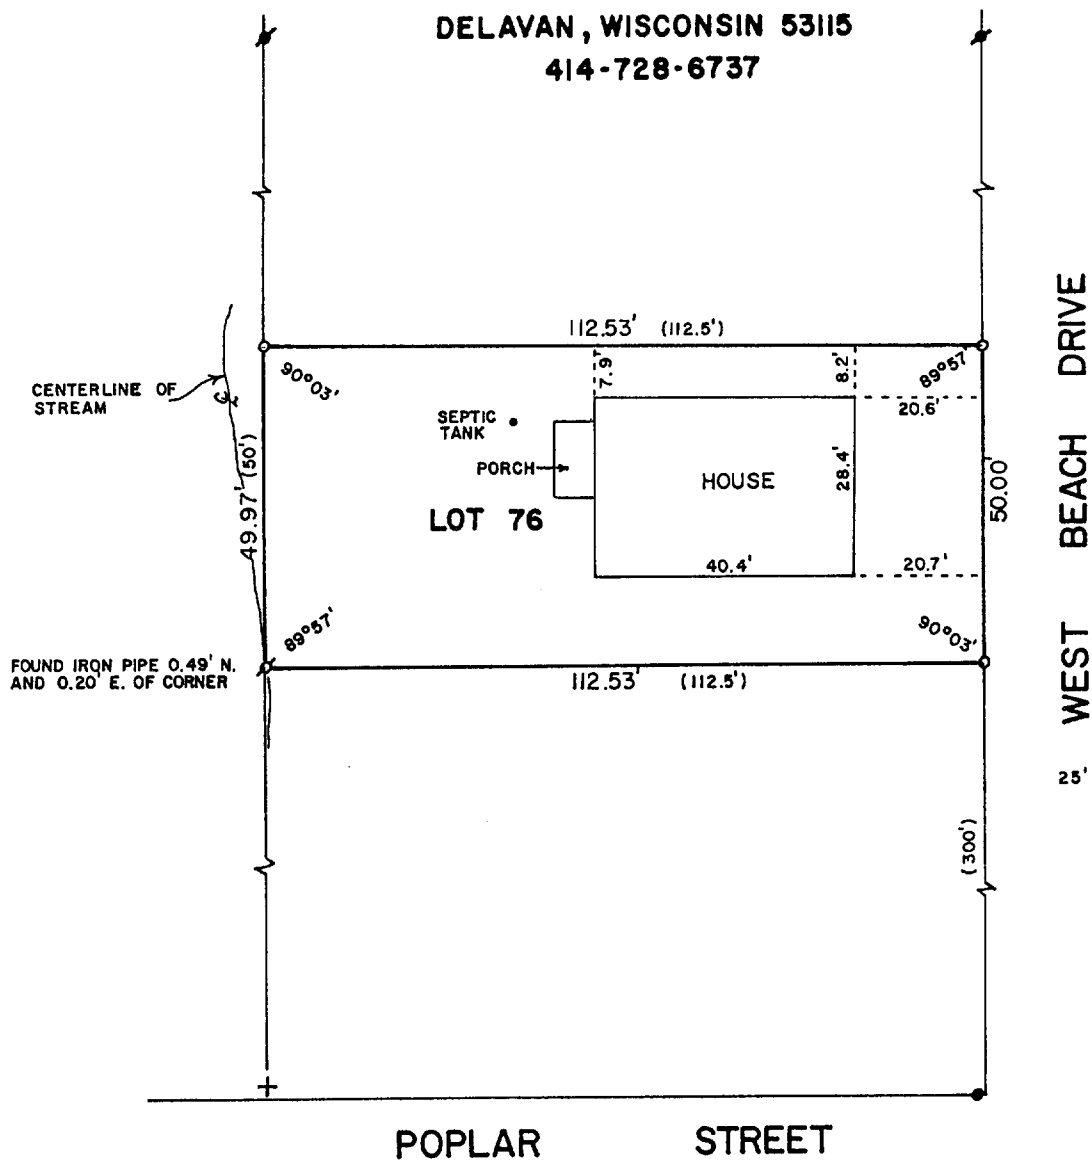

PLAT OF SURVEY OF

LOT 76 OF LAKE GENEVA BEACH, A SUBDIVISION
 LOCATED IN T1N, R17E, WALWORTH COUNTY,
 WISCONSIN.

ORDERED BY: CENTURY 21 - GENEVA LAKE
 503 CENTER STREET
 LAKE GENEVA, WI. 53147

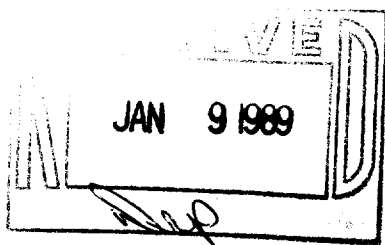

SCALE - 1"=30'

LEGEND

- ⊗ - IRON PIPE FOUND
- ⊕ - CONCRETE MONUMENT FOUND
- - IRON ROD SET
- () - RECORDED AS
- + - CUTCROSS IN CONCRETE FOUND
- - IRON ROD FOUND

I, DAVID F. ABELL, DO HEREBY CERTIFY
 THAT I HAVE SURVEYED THE PROPERTY
 HEREON DESCRIBED ACCORDING TO THE
 OFFICIAL RECORDS AND THAT THE PLAT
 HEREON IS A CORRECT REPRESENTATION
 OF THE PROPERTY LINES TO THE BEST OF
 MY KNOWLEDGE AND BELIEF.

David F. Abell
 DAVID F. ABELL
 WISCONSIN REGISTERED LAND SURVEYOR, S-1596

DATE *July 20, 1988* JOB NUMBER - 88144

NOTE: THIS IS NOT A CERTIFIED COPY UNLESS SEALED.