


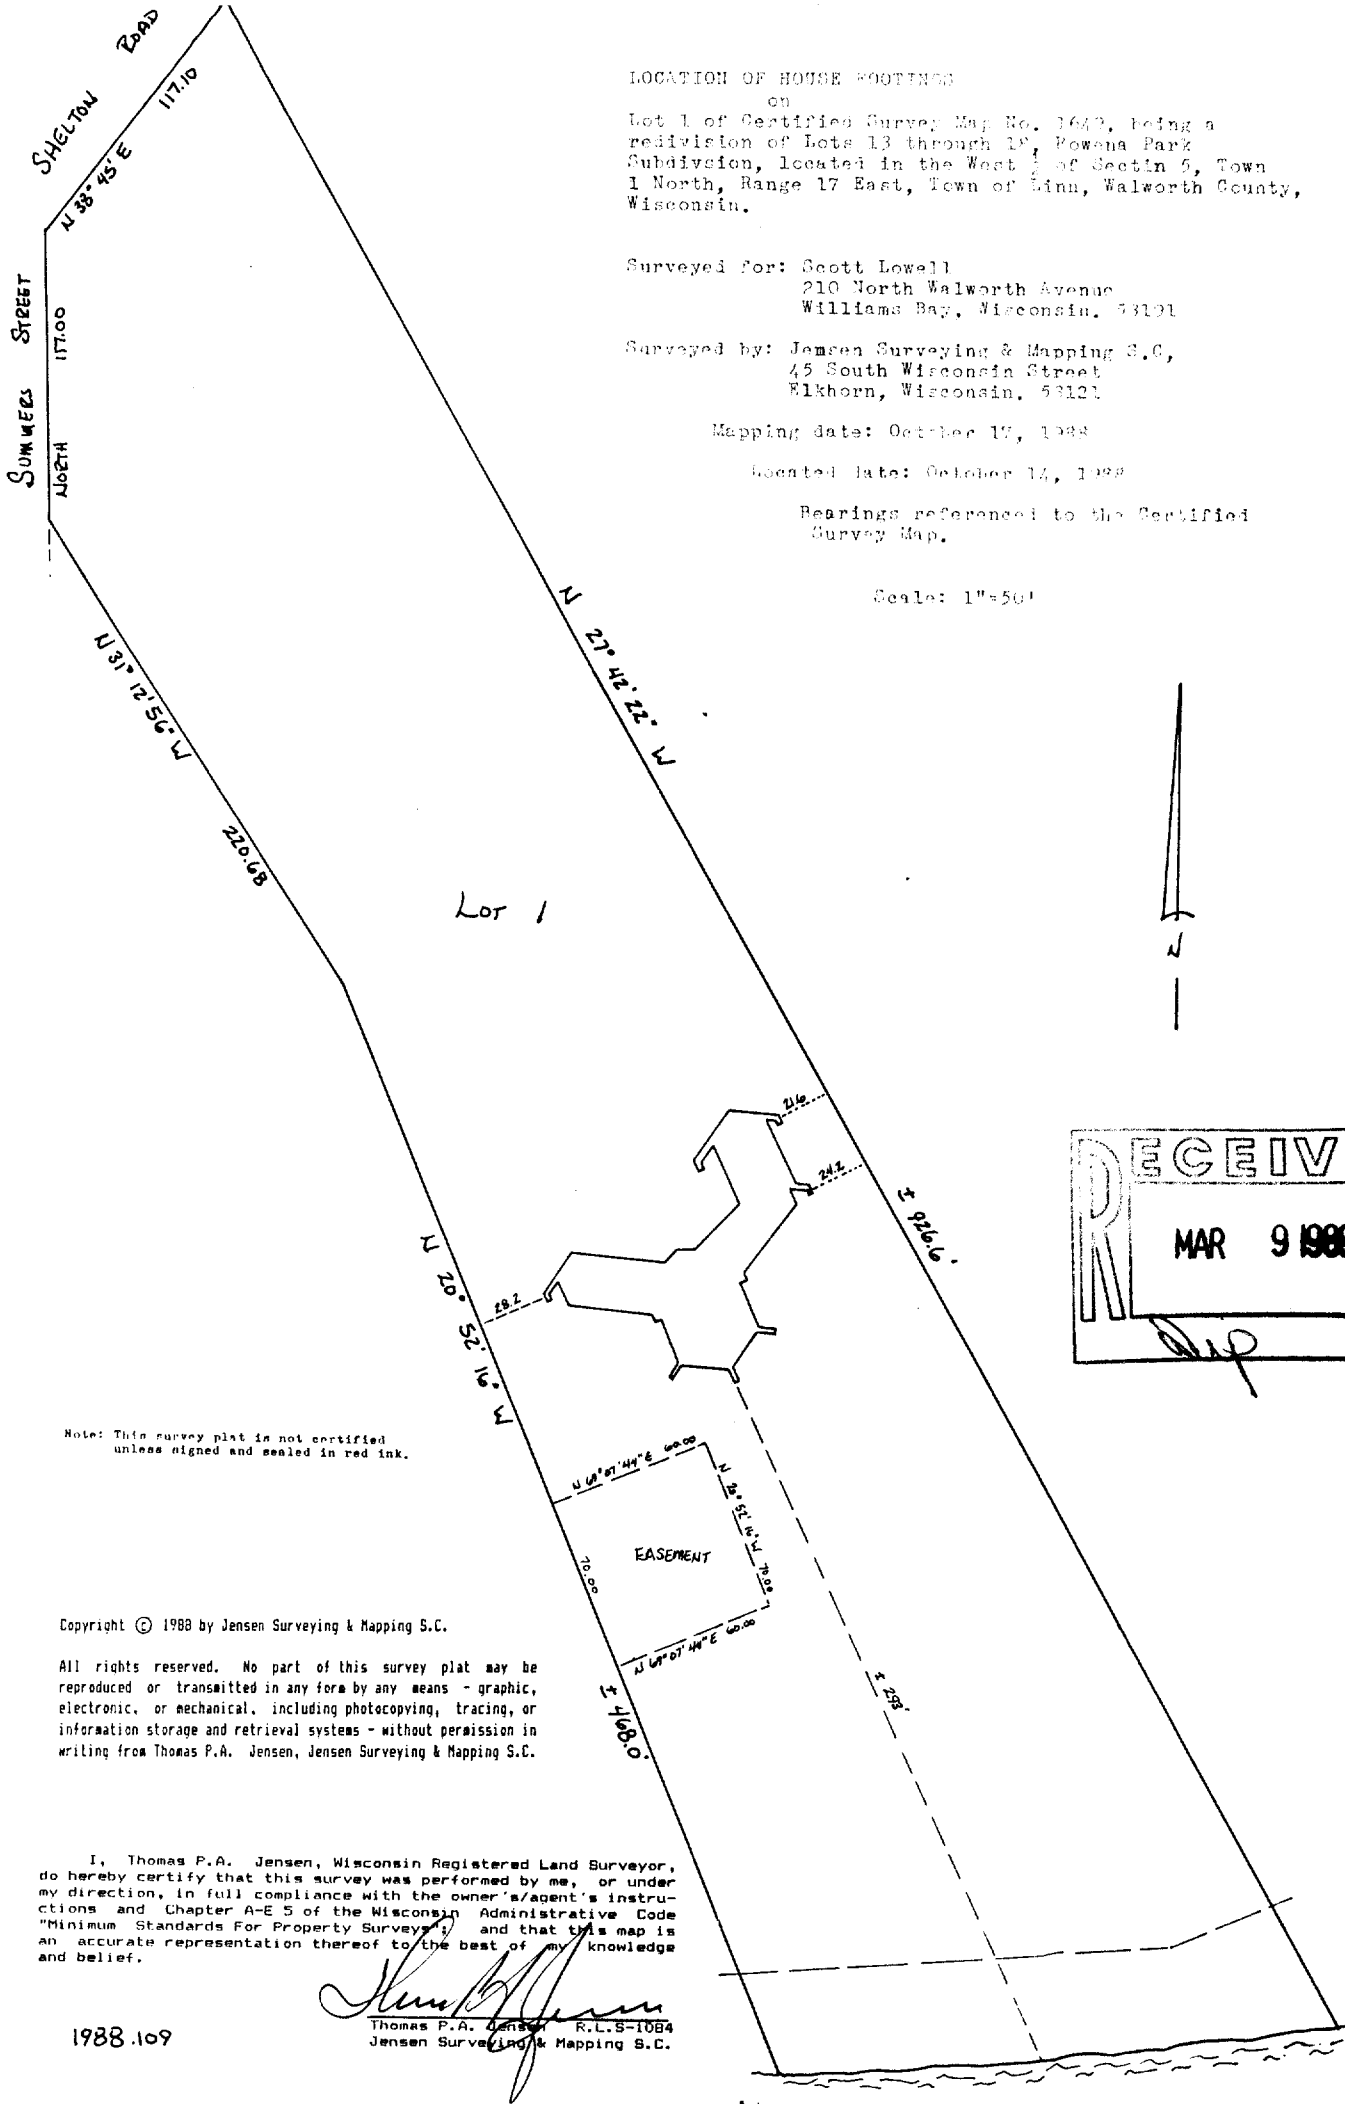

LOCATION OF HOUSE FOOTINGS

on
Lot 1 of Certified Survey Map No. 1642, being a
redivision of Lots 13 through 18, Rowena Park
Subdivision, located in the West 1/2 of Section 5, Town
1 North, Range 17 East, Town of Linn, Walworth County,
Wisconsin.

Surveyed for: Scott Lowell
210 North Walworth Avenue
Williams Bay, Wisconsin. 53191


Surveyed by: Jensen Surveying & Mapping S.C.,
45 South Wisconsin Street
Elkhorn, Wisconsin. 53121

Mapping date: October 17, 1988

Located date: October 17, 1988

Bearings referenced to the Certified
Survey Map.

Scale: 1"=50'

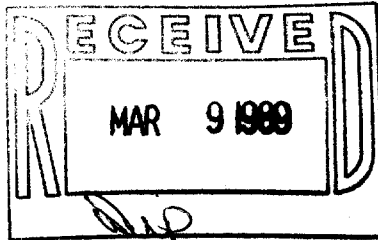

Note: This survey plat is not certified
unless signed and sealed in red ink.

Copyright © 1988 by Jensen Surveying & Mapping S.C.

All rights reserved. No part of this survey plat may be
reproduced or transmitted in any form by any means - graphic,
electronic, or mechanical, including photocopying, tracing, or
information storage and retrieval systems - without permission in
writing from Thomas P.A. Jensen, Jensen Surveying & Mapping S.C.

I, Thomas P.A. Jensen, Wisconsin Registered Land Surveyor,
do hereby certify that this survey was performed by me, or under
my direction, in full compliance with the owner's/agent's instru-
ctions and Chapter A-E 5 of the Wisconsin Administrative Code
"Minimum Standards For Property Surveys", and that this map is
an accurate representation thereof to the best of my knowledge
and belief.

1988.109

Thomas P.A. Jensen
Thomas P.A. Jensen R.L.S-1084
Jensen Surveying & Mapping S.C.

