


KOLB LAND CONSULTING, INC.  
LAND SURVEYING • SUBDIVIDING • LAND PLANNING

LAKE GENEVA, WISCONSIN 53147

WHITEWATER, WISCONSIN 53190  
RESURVEYED: 5-18-88

SURVEY NOT VALID  
UNLESS SURVEYOR'S  
SIGNATURE IS IN RED.

HAROLD H. KOLB

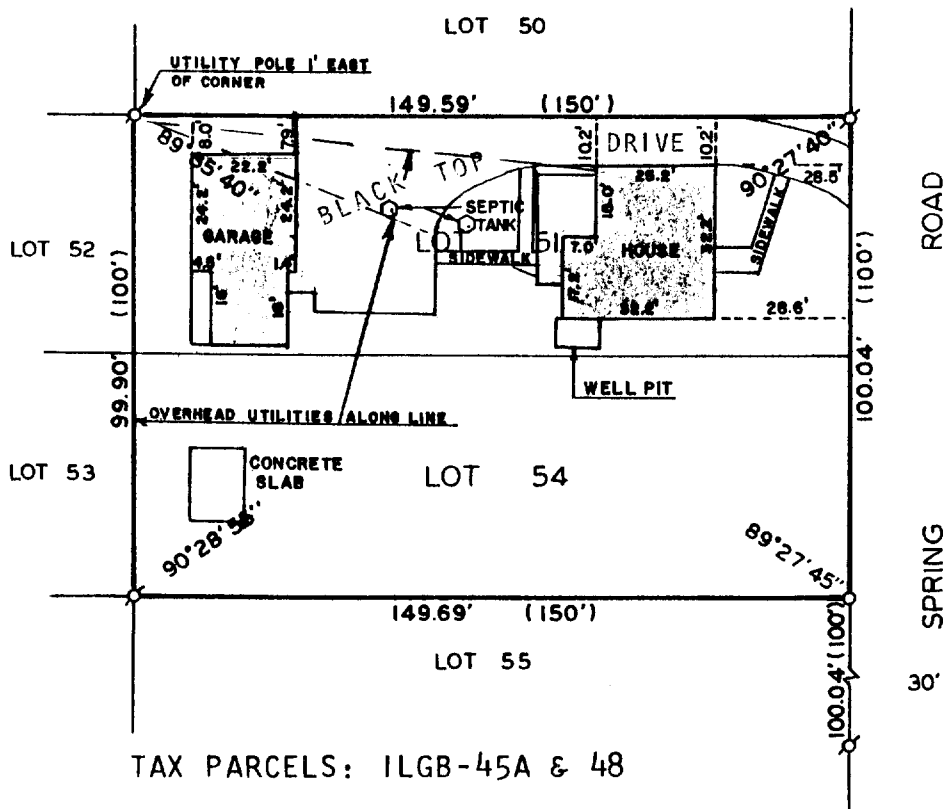


PLAT OF SURVEY OF

LOTS 51 AND 54, LAKE GENEVA BEACH SUB.,  
TOWN 1 NORTH, RANGE 17 EAST, WALWORTH  
COUNTY, WISCONSIN.

ORDERED BY: TERRY WILLIAMS  
P.O. BOX 667  
DELAVER, WI. 53115

FOR OWNER: PAUL G. BARTNICKI

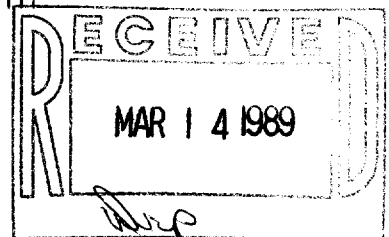

SCALE 1" = 40'

LEGEND

- o - IRON PIPE SET
- σ - IRON PIPE FOUND
- ( ) - RECORDED AS IRON ROD FOUND

I HEREBY CERTIFY THAT I HAVE SURVEYED THE  
ABOVE DESCRIBED PROPERTY AND THAT THE ABOVE  
MAP IS A TRUE REPRESENTATION THEREOF AND  
SHOWS THE SIZE AND LOCATION OF THE PROPERTY,  
ITS EXTERIOR BOUNDARIES, THE LOCATION OF ALL  
VISIBLE STRUCTURES AND DIMENSIONS OF ALL  
PRINCIPAL BUILDINGS THEREON, BOUNDARY FENCES,  
APPARENT EASEMENTS, ROADWAYS AND VISIBLE  
ENCROACHMENTS, IF ANY.

THIS SURVEY IS MADE FOR THE USE OF THE  
PRESENT OWNERS OF THE PROPERTY, AND ALSO  
THOSE WHO PURCHASE, MORTGAGE, OR GUARANTEE  
THE TITLE THERETO WITHIN ONE (1) YEAR FROM  
DATE HEREOF.

*Harold H. Kolb*  
HAROLD H. KOLB

WISCONSIN REGISTERED LAND SURVEYOR, S-187

DATE Sept. 1, 1982

REVISED: SEPTEMBER 17, 1982

REVISED: APRIL 5, 1984

117-945

1-17-417