

16

27

15

14

29

13

30

12

31

FOUND IRON PIPE 0.9' SOUTH & 1' WEST OF CORNER

1.4'

(140') 139.92'

(90') 89.98'

20.00'

20.01'

90°58'

26.2'

24.2'

24.2'

26.2'

89°23'

PENGE

BLACKTOP DRIVEWAY

OVERHEAD UTILITIES ALONG LINE

(100') 99.94'

79.82'

99.83' (100')

35

90°53'

90.00'

40.2'

89°26'

9.85'

12.5'

6.5'

9.3'

12.5'

7.3'

16.5'

14.3'

14.4'


9.7'

HOUSE

BLOCK "H"

SHORE VIEW DRIVE

THE SOUTH 1/2 OF LOT 28 AND ALL OF LOTS
29 AND 30, BLOCK "H" OF CISCO BEACH, A
SUBDIVISION LOCATED IN SECTION 5, T 1 N,
R 17 E, WALWORTH COUNTY, WISCONSIN.

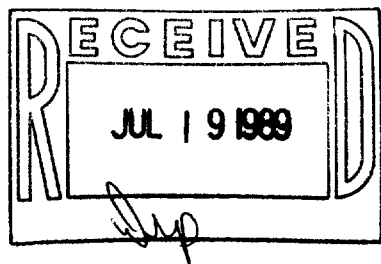

ORDERED BY: KEEFE REAL ESTATE
704 MAIN STREET
LAKE GENEVA, WISCONSIN
53147



♂ - IRON PIPE FOUND
 ♀ - "POSEY" PIN FOUND
 ○ - IRON ROD PLACED
 () - RECORDED AS

I HEREBY CERTIFY THAT I HAVE SURVEYED THE ABOVE DESCRIBED PROPERTY AND THAT THE ABOVE MAP IS A TRUE REPRESENTATION THEREOF AND SHOWS THE SIZE AND LOCATION OF THE PROPERTY, ITS EXTERIOR BOUNDARIES, THE LOCATION OF ALL VISIBLE STRUCTURES AND DIMENSIONS OF ALL PRINCIPAL BUILDINGS THEREON, BOUNDARY FENCES, APPARENT EASEMENTS AND ROADWAYS AND VISIBLE ENCROACHMENTS, IF ANY.

THIS SURVEY IS MADE FOR THE EXCLUSIVE USE OF THE PRESENT OWNERS OF THE PROPERTY, AND ALSO THOSE WHO PURCHASE, MORTGAGE, OR GUARANTEE THE TITLE THERETO WITHIN ONE (1) YEAR FROM DATE HEREOF.

Robert M. Baerenwald
ROBERT M. BAERENWALD
WISCONSIN REGISTERED LAND SURVEYOR, S-1508

DATE April 7, 1959 JOB NO. 1892

NOTE: THIS IS NOT A CERTIFIED COPY UNLESS SEALED.