


ABELL
SURVEYING & MAPPING
DELAVER, WISCONSIN 53115
414-728-8787

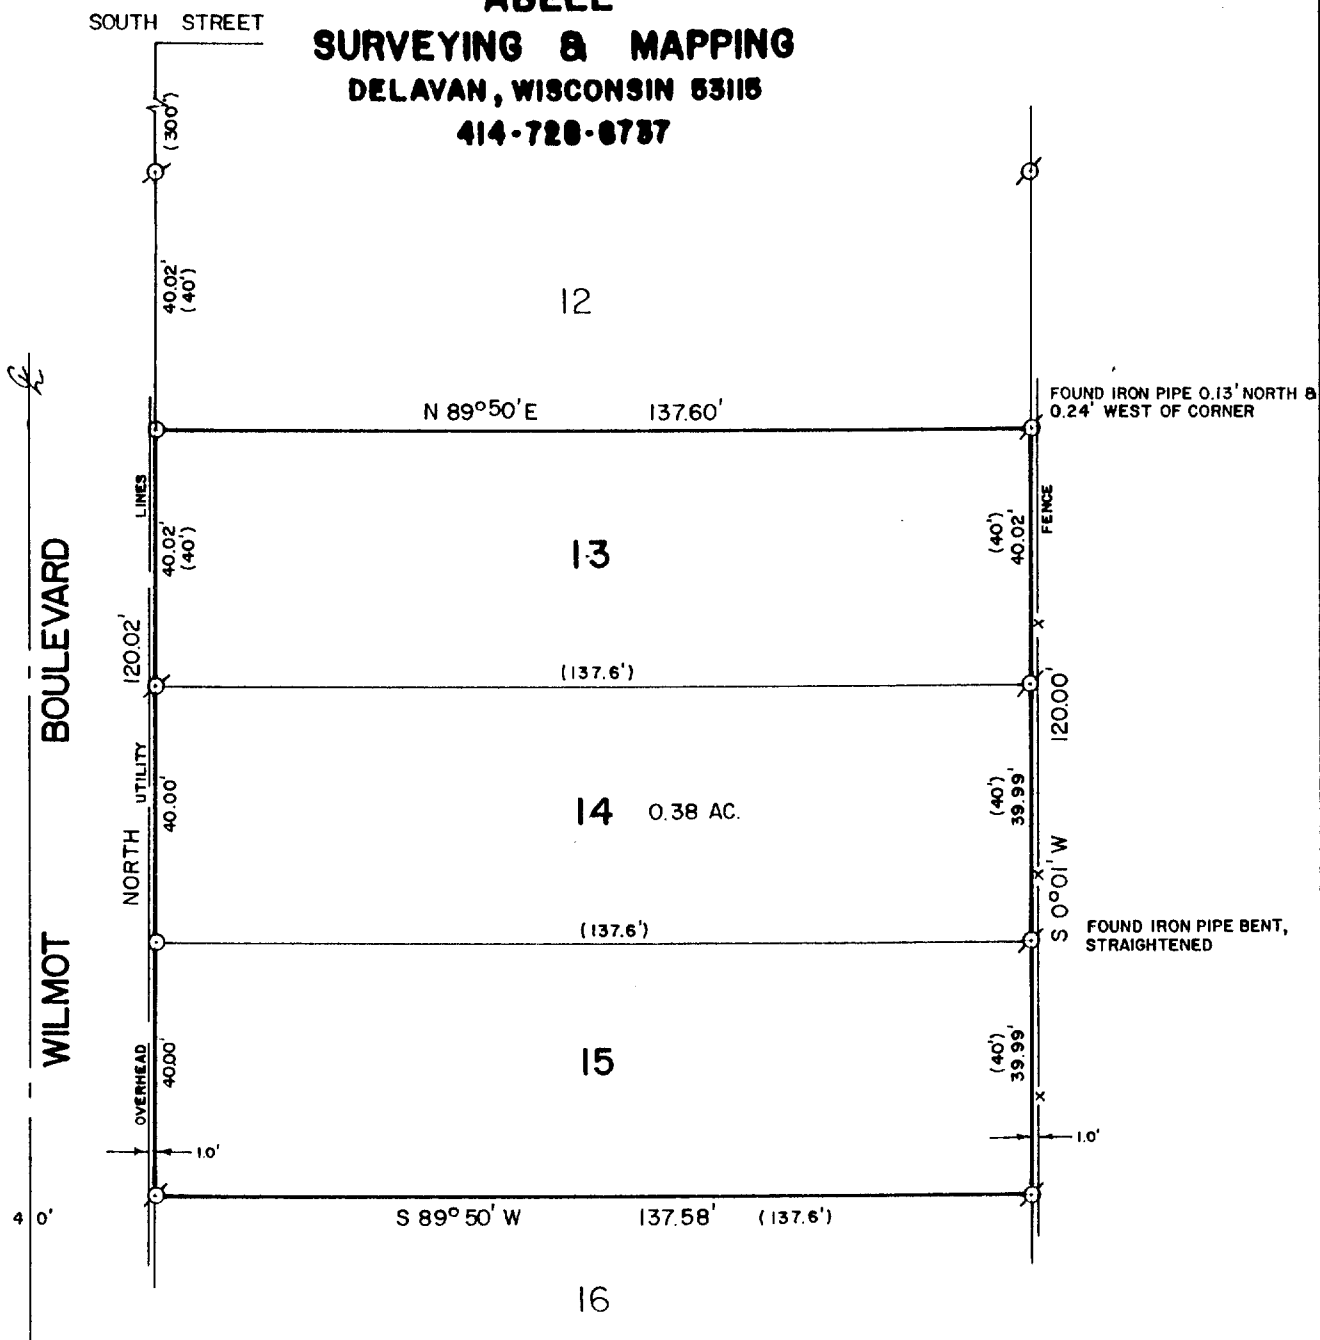


PLAT OF SURVEY OF

LOTS 13-15 OF PARADISE VISTA, A SUBDIVISION LOCATED
IN THE SOUTHEAST 1/4 OF SECTION 1, T1N,R17E, WALWORTH
COUNTY, WISCONSIN.

NOTE: THE BEARING ON THE WEST LINE OF LOTS 13-15 IS ASSUMED
NORTH.

ORDERED BY: THE RAULAND AGENCY
118 KENOSHA STREET
WALWORTH, WI. 53184

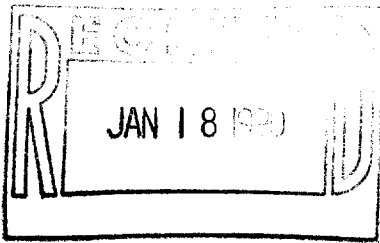

SCALE - 1"=30'

LEGEND

- Ø - IRON PIPE FOUND
- - IRON ROD SET
- () - RECORDED AS

I HEREBY CERTIFY THAT I HAVE SURVEYED THE ABOVE DESCRIBED PROPERTY AND THAT THE
ABOVE MAP IS A TRUE REPRESENTATION THEREOF AND SHOWS THE SIZE AND LOCATION OF
THE PROPERTY, ITS EXTERIOR BOUNDARIES, THE LOCATION OF ALL VISIBLE STRUCTURES
AND DIMENSIONS OF ALL PRINCIPAL BUILDINGS THEREON, BOUNDARY FENCES, APPARENT
EASEMENTS, ROADWAYS AND VISIBLE ENCROACHMENTS, IF ANY, TO THE BEST OF MY
KNOWLEDGE AND BELIEF.

THIS SURVEY IS MADE FOR THE USE OF THE PRESENT OWNERS OF THE PROPERTY, AND ALSO
THOSE WHO PURCHASE, MORTGAGE, OR GUARANTEE THE TITLE THERETO WITHIN ONE (1) YEAR
FROM DATE HEREOF.

David F. Abell
DAVID F. ABELL

WISCONSIN REGISTERED LAND SURVEYOR, S-1596

October 18, 1989

DATE: *October 18, 1989* JOB NUMBER - 89225
NOTE: THIS IS NOT A CERTIFIED COPY UNLESS SEALED.

IPV-3B1

T-1111