


AMBIT LAND SURVEYING  
P. O. Box 42  
Bassett, Wisconsin 53101-0042

# PLAT OF SURVEY OF

PHONE: 262-537-4874  
FAX: 262-537-4221

**PARCEL 1:** All the North Half of the Southeast Quarter of Section 26, Township 1 North, Range 18 East of the 4th Principal Meridian, Town of Bloomfield, Walworth County, Wisconsin, that lies West of GRA DEN WOODS Subdivision.

**PARCEL 2:** Lots 7, 8, 9, 10, 11 and 12 of GRA DEN WOODS, located in the North Half of the Southeast Quarter of Section 26, Township 1 North, Range 18 East of the 4th Principal Meridian, Town of Bloomfield, Walworth County, Wisconsin.

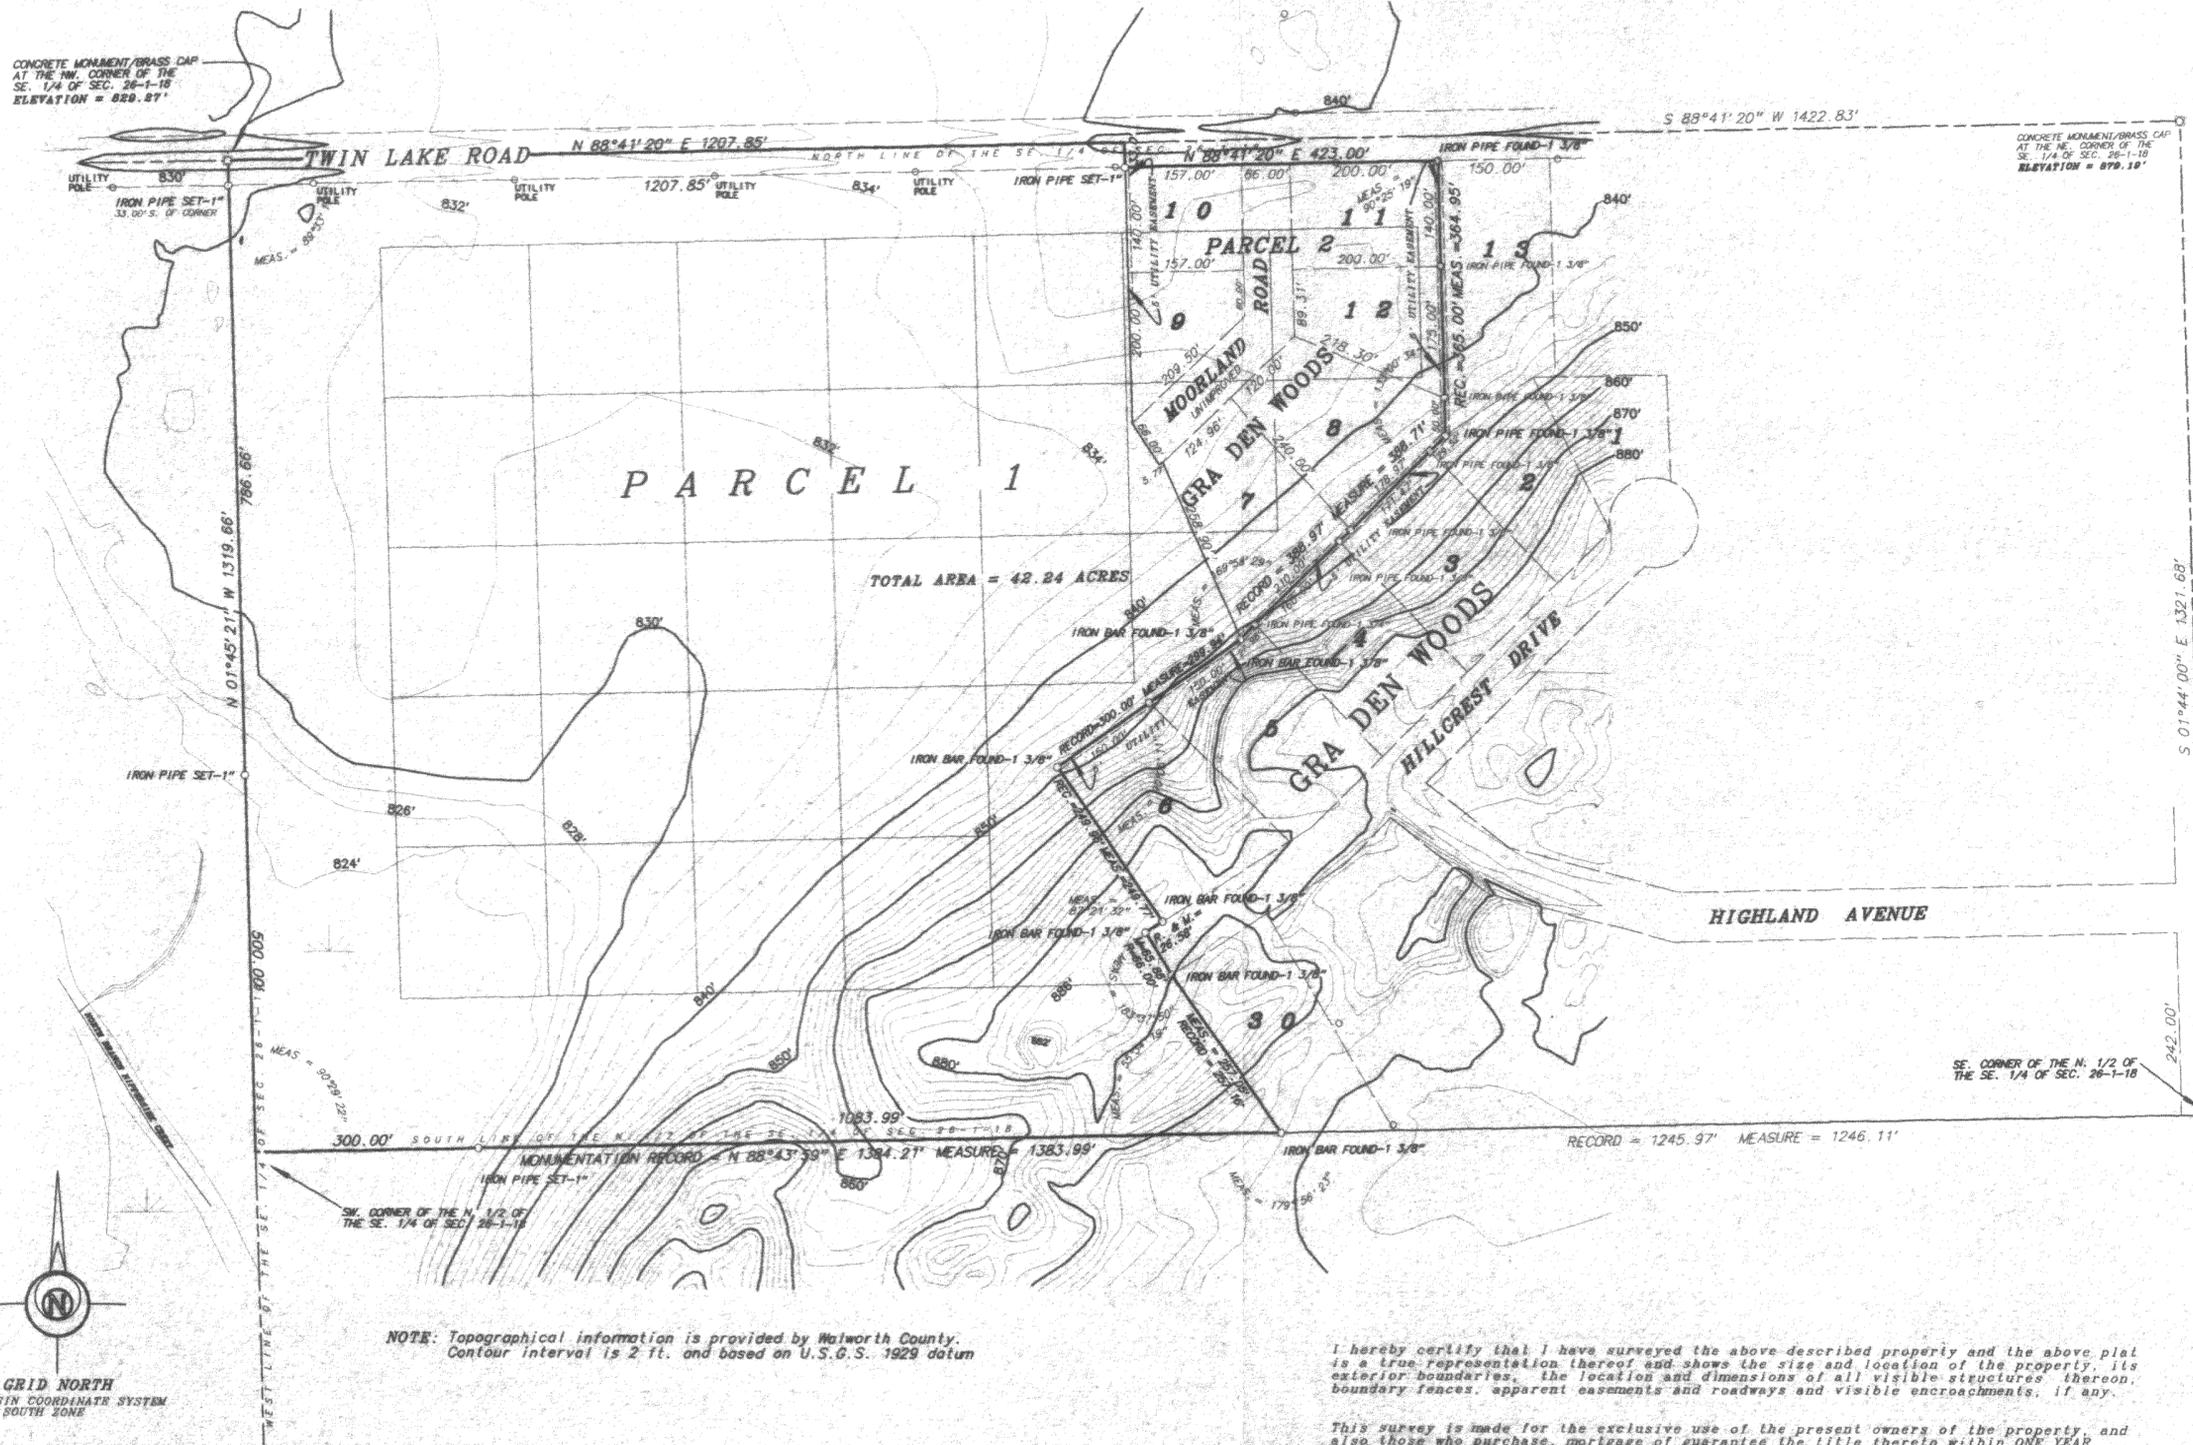


NOTE: Topographical information is provided by Walworth County.  
Contour interval is 2 ft. and based on U.S.G.S. 1929 datum

I hereby certify that I have surveyed the above described property and the above plat is a true representation thereof and shows the size and location of the property, its exterior boundaries, the location and dimensions of all visible structures thereon, boundary fences, apparent easements and roadways and visible encroachments, if any.

This survey is made for the exclusive use of the present owners of the property, and also those who purchase, mortgage or guarantee the title thereto within ONE YEAR from the date hereof.

Dated at Bassett, Wisconsin this \_\_\_\_\_ day of \_\_\_\_\_ 2003.

Mark A. Bolander  
Wisconsin Registered Land Surveyor S - 1784

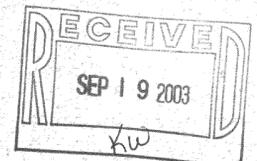

SCALE 1 inch = 160 feet

ORDERED BY D. Laurine  
JOB NO. 03204

MGDW-7 MGDW-11  
MGDW-8 MGDW-12  
MGDW-9 MB26-8  
MGDW-10

118-2316