


PLAT OF SURVEY  
OF

LOT 22, GRA DEN WOODS, A SUBDIVISION LOCATED IN THE N 1/2 OF THE SE 1/4 OF SECTION 26,  
T. 1N., R. 18 E. TOWN OF BLOOMFIELD, WALWORTH COUNTY, WISCONSIN.

FOR: GINO AND MELISSA SANTI  
W 534 GRA DEN WOOD LANE  
GENOA CITY, WI. 53128

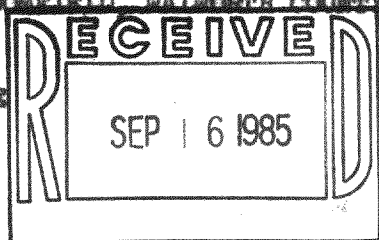

SCALE 1" = 60'

- o = IRON PIPE STAKE SET.
- = SOLID IRON BAR FOUND.
- σ = IRON PIPE STAKE FOUND.

BEARING DATUM IS THAT OF  
RECORDED PLAT.

We surveyed the above-described property and the map hereon is a true representation thereof and shows the size and location of the property, its exterior boundaries, the location and dimensions of all structures thereon, fences, appurtenant easements and roadways, as visible on the date of survey.

This survey is made for the exclusive use of the present owners of the property, and all those who purchase the same are granted the title therein, which shall be binding hereof.

Dated at Burlington, Wis. 20th  
Day of July 1985  
John F. Degen  
Land Surveyor S. 100

