




PLAT OF SURVEY

of Lots 1343, 1344, 1345 and 1346 and Lots 1382, 1383, 1384 and 1385, Block 30 of PELL LAKE SUBDIVISION, Walworth County, Wisconsin, according to the recorded plat thereof.

AMBIT LAND SURVEYING
P.O. Box 42
Bassett, Wisconsin 53101
414-537-4874

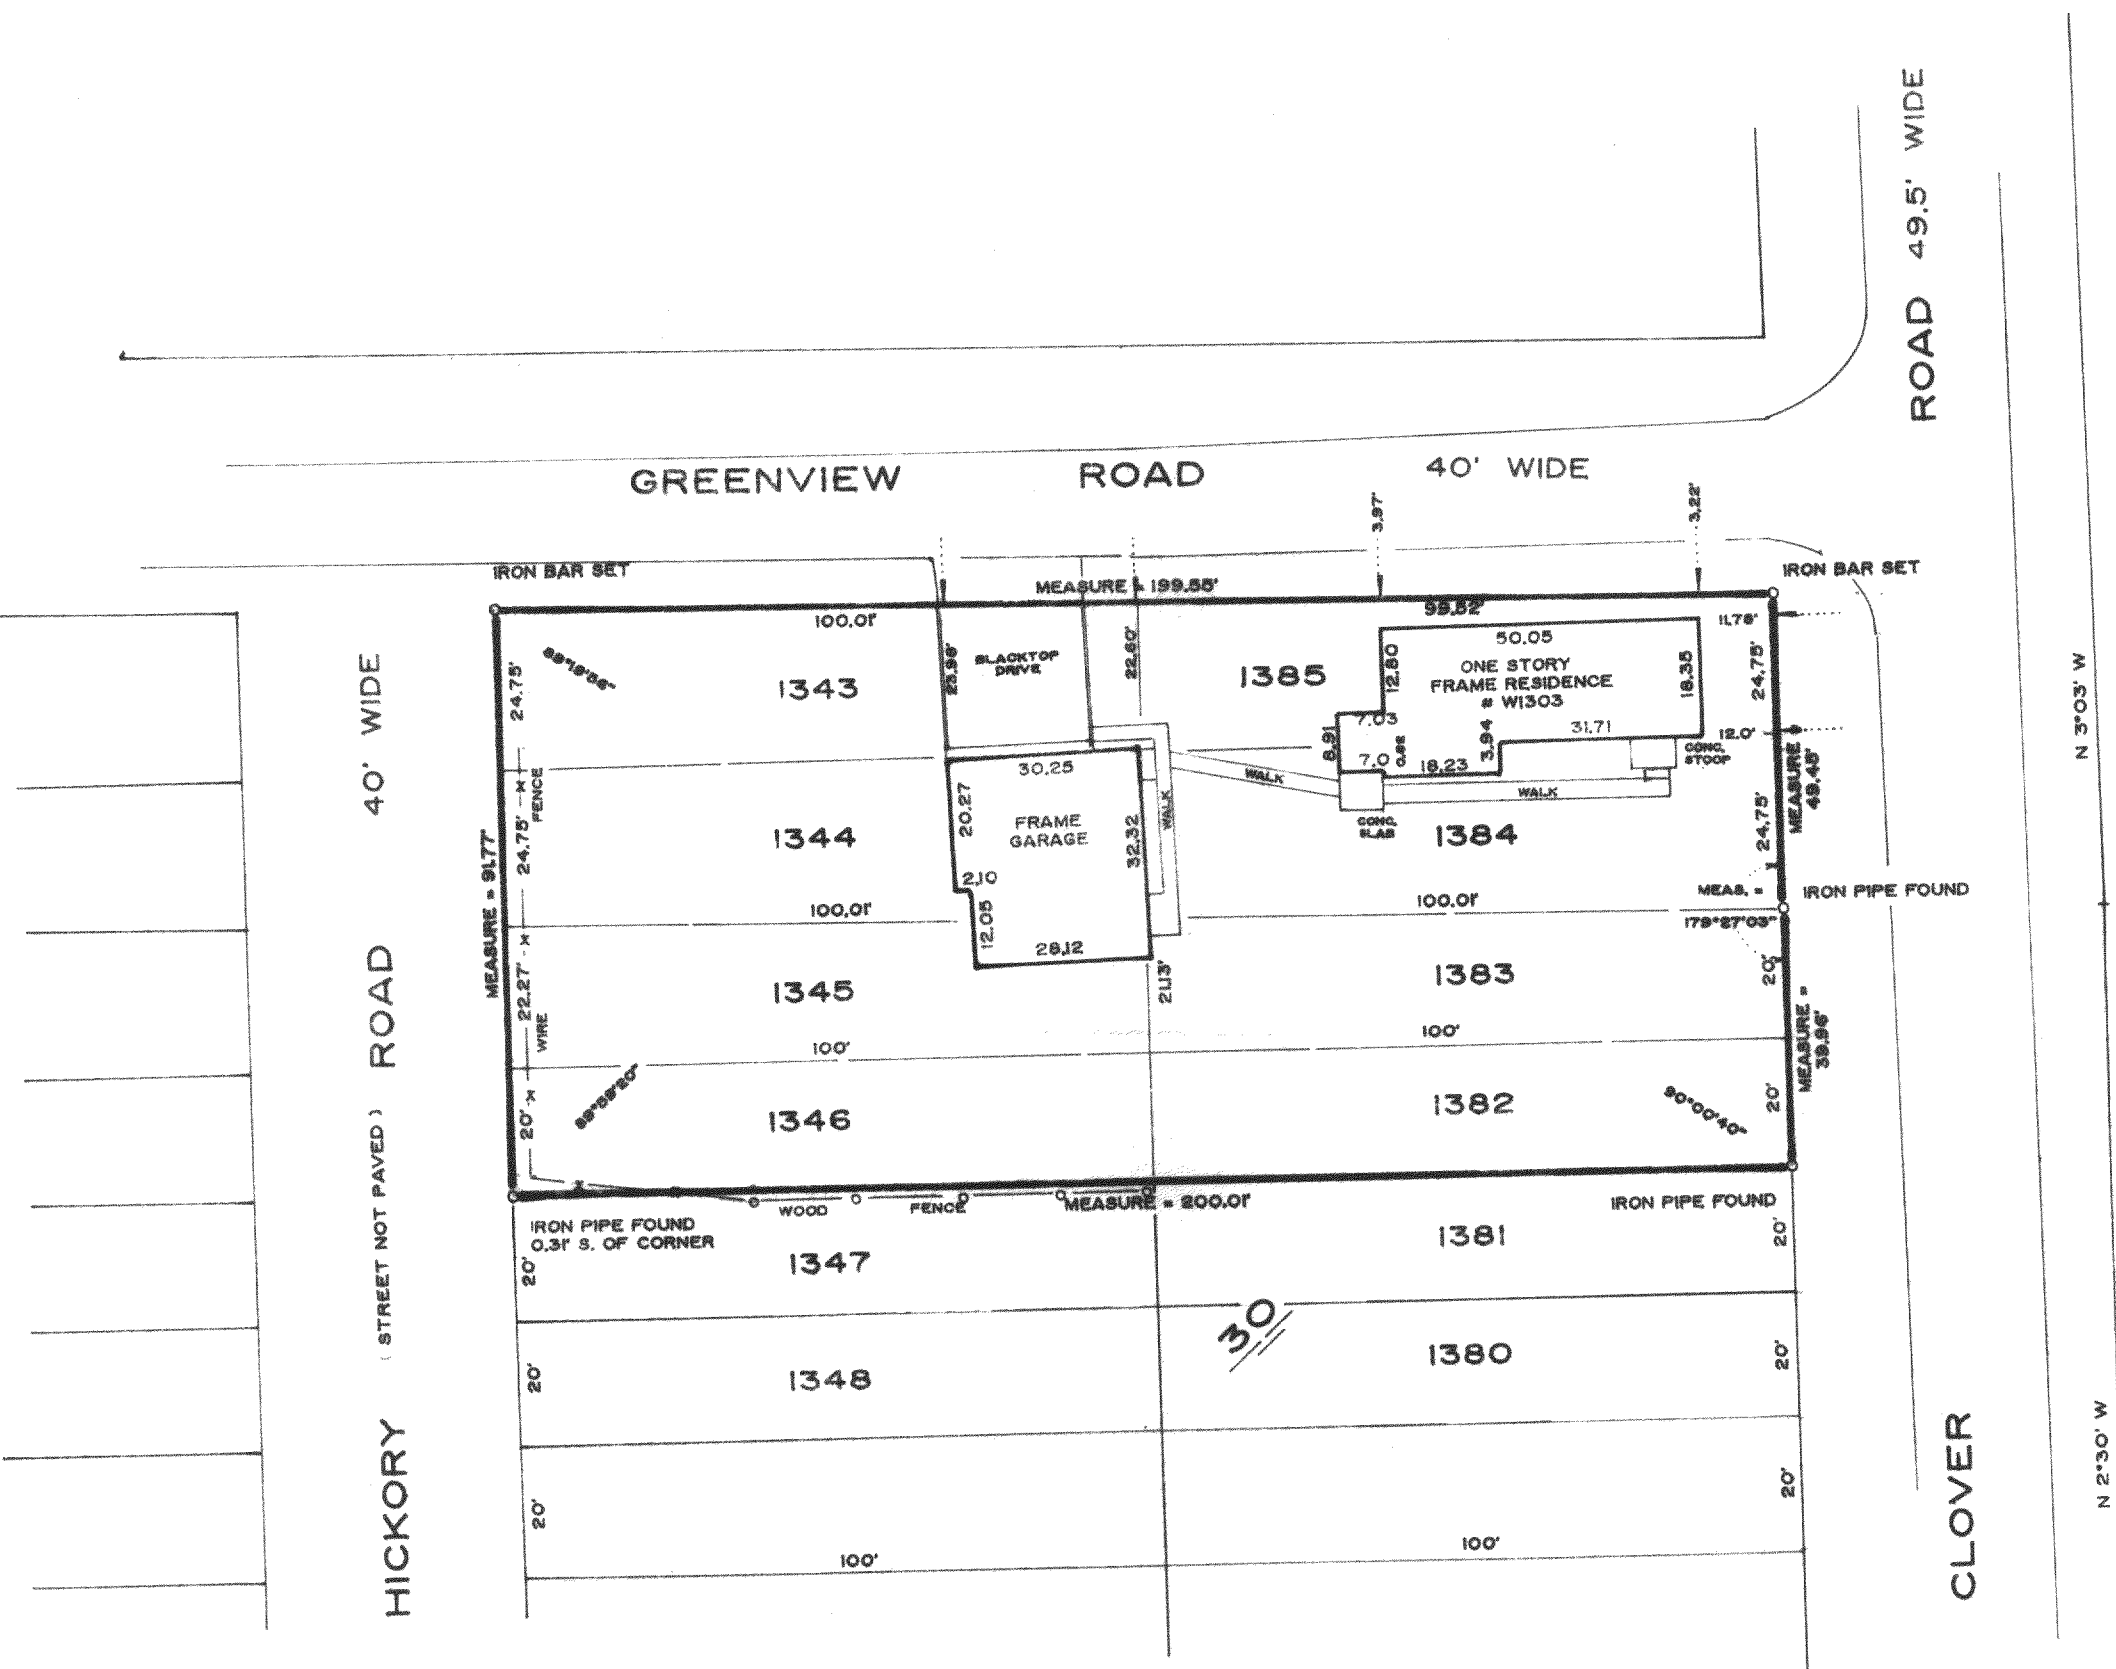

BLOCK

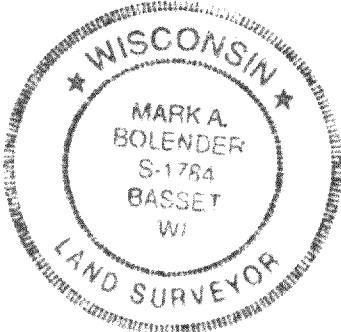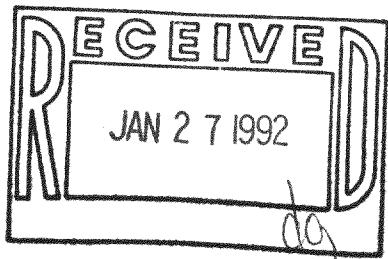

I hereby certify that I have surveyed the above described property and the above plat is a true representation thereof and shows the size and location of the property, its exterior boundaries, the location and dimensions of all visible structures thereon, boundary fences, apparent easements and roadways and visible encroachments, if any.

This survey is made for the exclusive use of the present owners of the property, and also those who purchase, mortgage, or guarantee the title thereto within one year from the date hereof.

Dated at Bassett, Wisconsin this 19th day of NOVEMBER 1990.

Mark A. Bolender
Mark A. Bolender
Wisconsin Registered Land Surveyor S - 1784

SCALE 1" = 30'
ORDERED BY R. Livingston / C-21 L. Hodges
JOB NO. 90076

MPL 00305
MPL 00297

118-1016