


ABELL SURVEYING & MAPPING


DELAVER, WISCONSIN 53115

414-728-6737

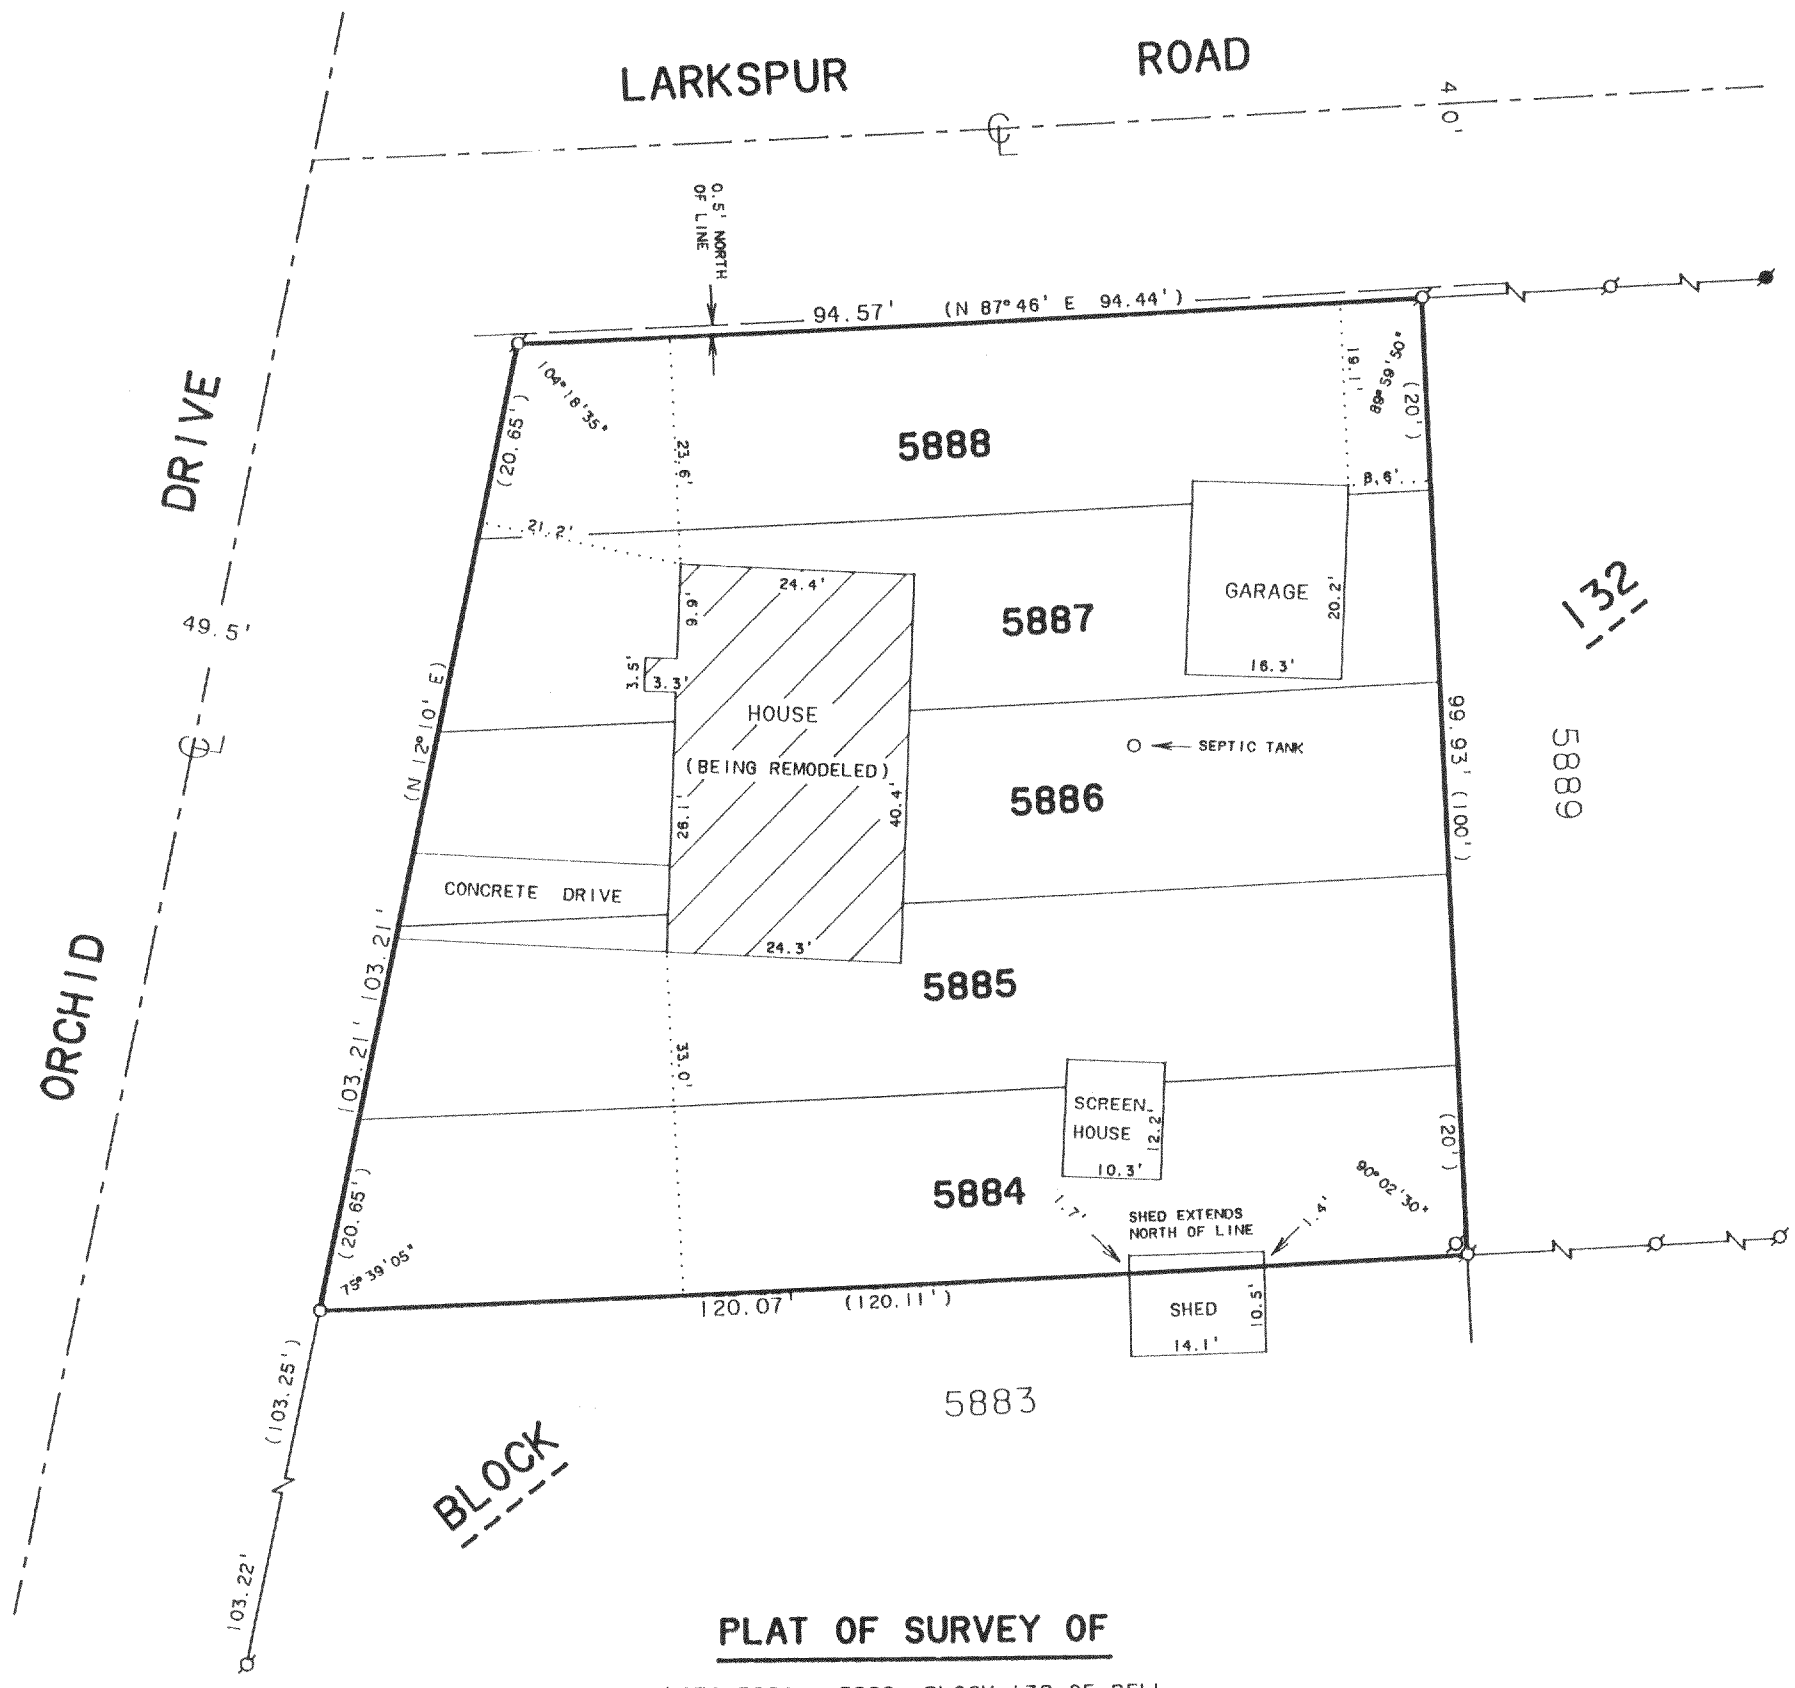

PLAT OF SURVEY OF

LOTS 5884 - 5888, BLOCK 132 OF PELL
LAKE SUBDIVISION, LOCATED IN T1N. R18E,
WALWORTH COUNTY, WISCONSIN.

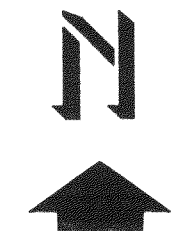


SCALE 1"=20'

LEGEND

- - IRON PIPE FOUND
- - IRON ROD FOUND
- - IRON PIPE SET
- - OVERHEAD UTILITY LINES
- () - RECORDED AS

ORDERED BY: BILL GAEDE
3139 WEST DRIVE
LAKE GENEVA, WI. 53147

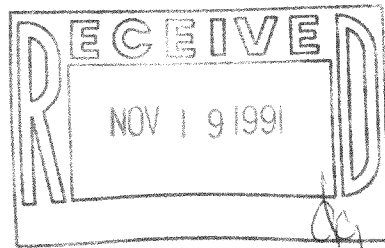

I, DAVID F. ABELL, DO HEREBY CERTIFY THAT I HAVE SURVEYED THE PROPERTY HEREON DESCRIBED ACCORDING TO THE OFFICIAL RECORDS AND THAT THE PLAT HEREON IS A CORRECT REPRESENTATION OF THE PROPERTY LINES TO THE BEST OF MY KNOWLEDGE AND BELIEF.

David F. Abell
DAVID F. ABELL

WISCONSIN REGISTERED LAND SURVEYOR, S-1596

July 18, 1991

DATE

JOB NUMBER - 91144

NOTE: THIS IS NOT A CERTIFIED COPY UNLESS SEALED.

118-1026

MAP 01278