


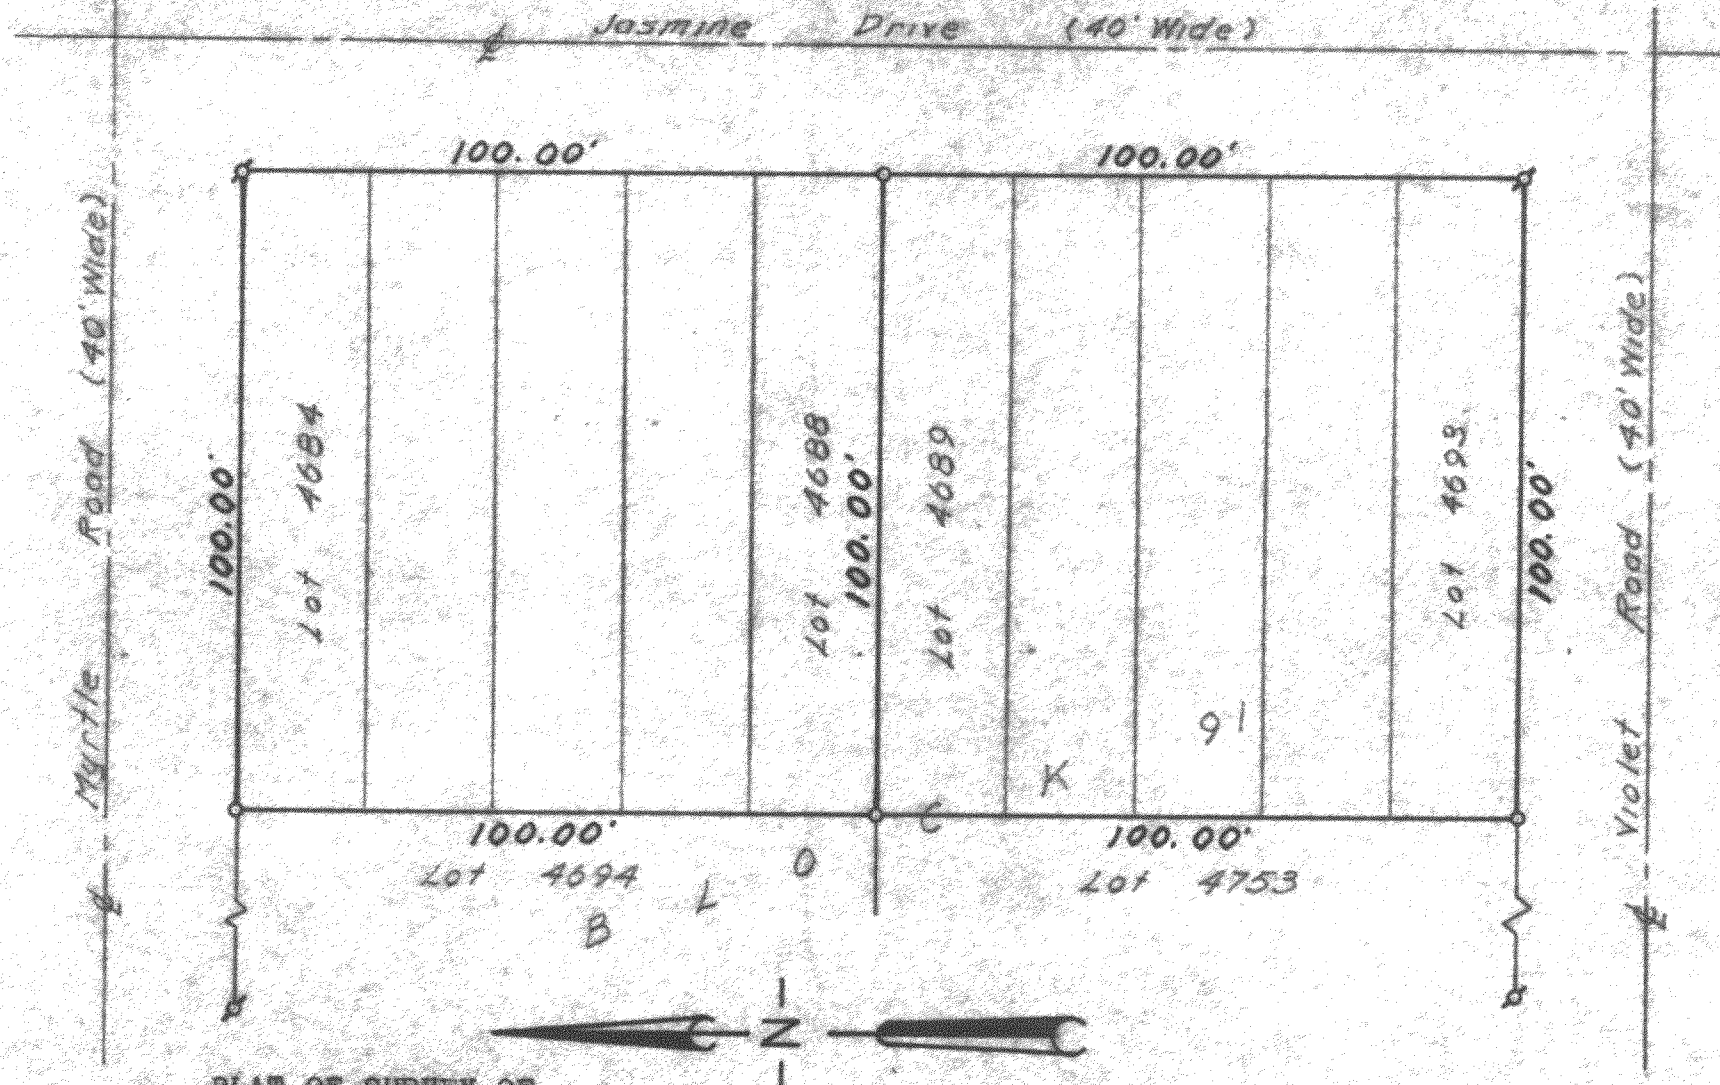

PLAT OF SURVEY OF

Lots 4684-4688 & Lots 4689-4693,
Block 91, Pell Lake Subdivision, located
in Section 15, T 1 N, R 16 E, Walworth
County, Wisconsin.

Harold H. Kolb

Harold H. Kolb, Wis. Registered Surveyor, S-187

⊗ - Iron Pipe Found
o - Iron Pipe Placed
Scale 1" = 30'

6-4-62

118-103