

PLAT OF SURVEY
OF



LOTS 2186 THRU 2204 IN BLOCK 45 OF PELL LAKE SUBDIVISION, SECTION NO. 2, LOCATED IN THE TOWN OF BLOOMFIELD, WALWORTH COUNTY, WISCONSIN.

FOR: DULBIS

SCALE 1" = 50'

IP = IRON PIPE FOUND

IS = IRON PIPE SET.

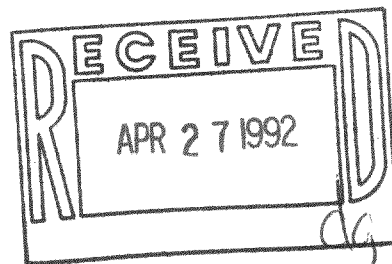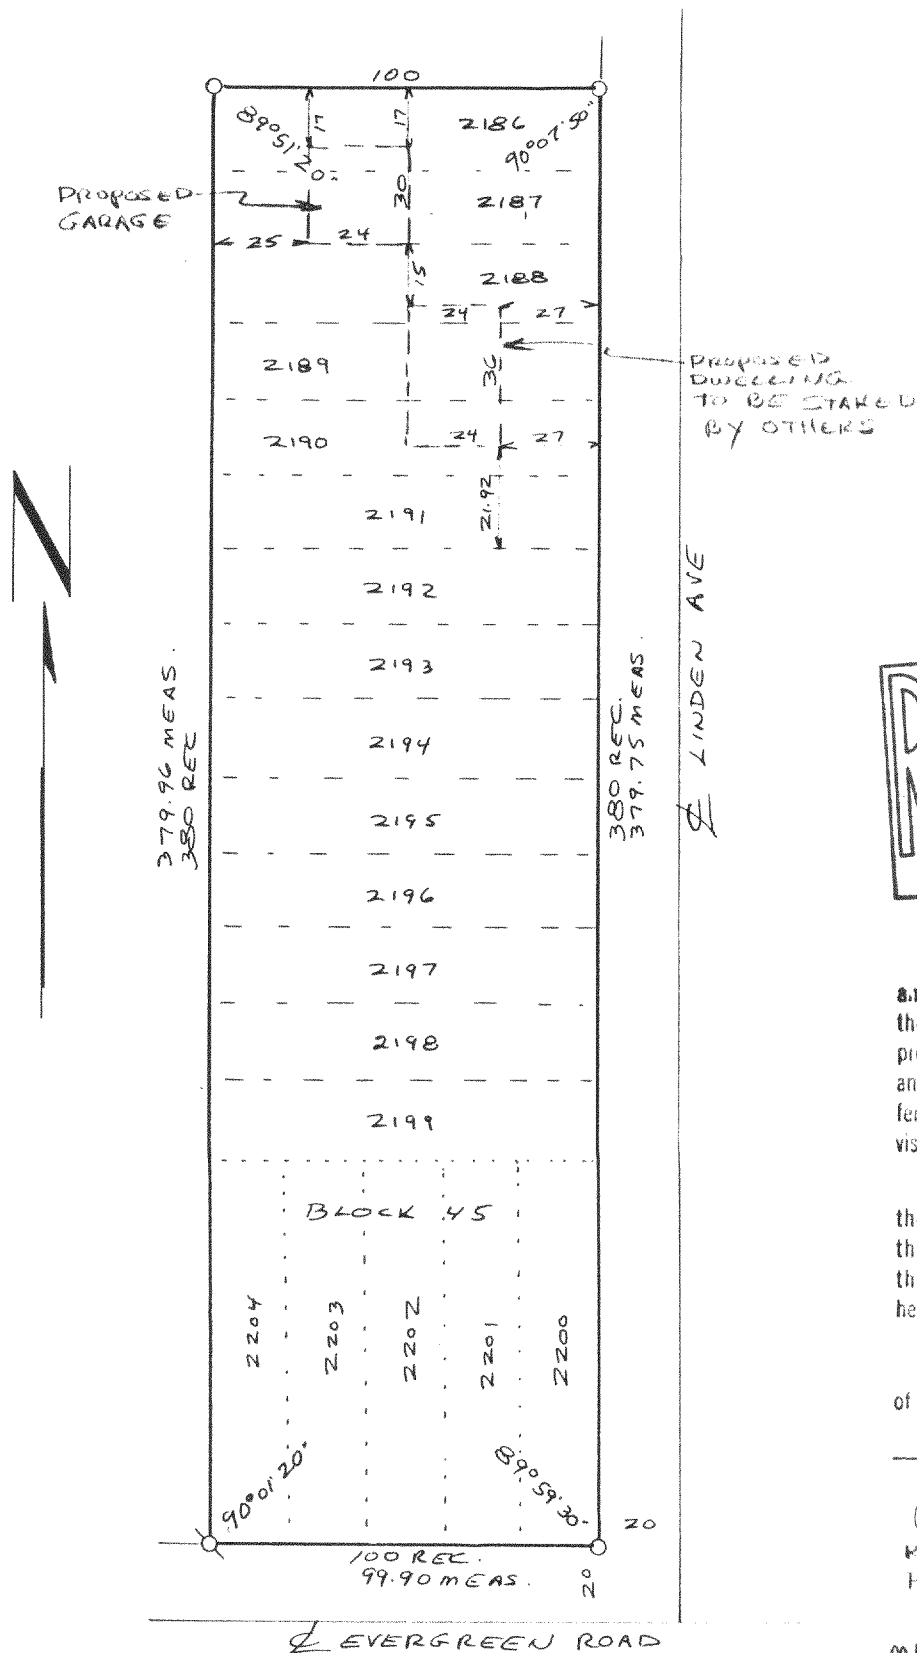

I have surveyed the above-described property, and the map hereon is a true representation thereof and shows the size and location of the property, its exterior boundaries, the location and dimensions of all visible structures thereon, fences, apparent easements and roadways and visible encroachments, if any.

This survey is made for the exclusive use of the present owners of the property, and also those who purchase, mortgage, or guarantee the title thereto, within one year from date hereof.

Dated at Burlington, this 2ND day,

of APRIL, 1992

John F. Degen

John F. Degen, Land Surveyor S 242
589 N. Pine St. Burlington, WI 53105

REVISED 4-16-92 TO SHOW
PROPOSED BUILDINGS.

MPL-452
MPL-453
MPL-454
MPL-455

118-1032

PLAT OF SURVEY



LOTS 2186 THRU 2204 IN BLOCK 45 OF PELL LAKE SUBDIVISION, SECTION NO. 2, LOCATED IN THE TOWN OF BLOOMFIELD, WALWORTH COUNTY, WISCONSIN.

FOR: DULBIS

SCALE 1" = 50'

⊘ = IRON PIPE FOUND

o = IRON PIPE SET.

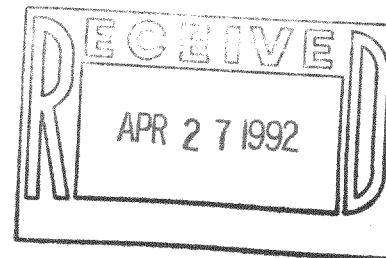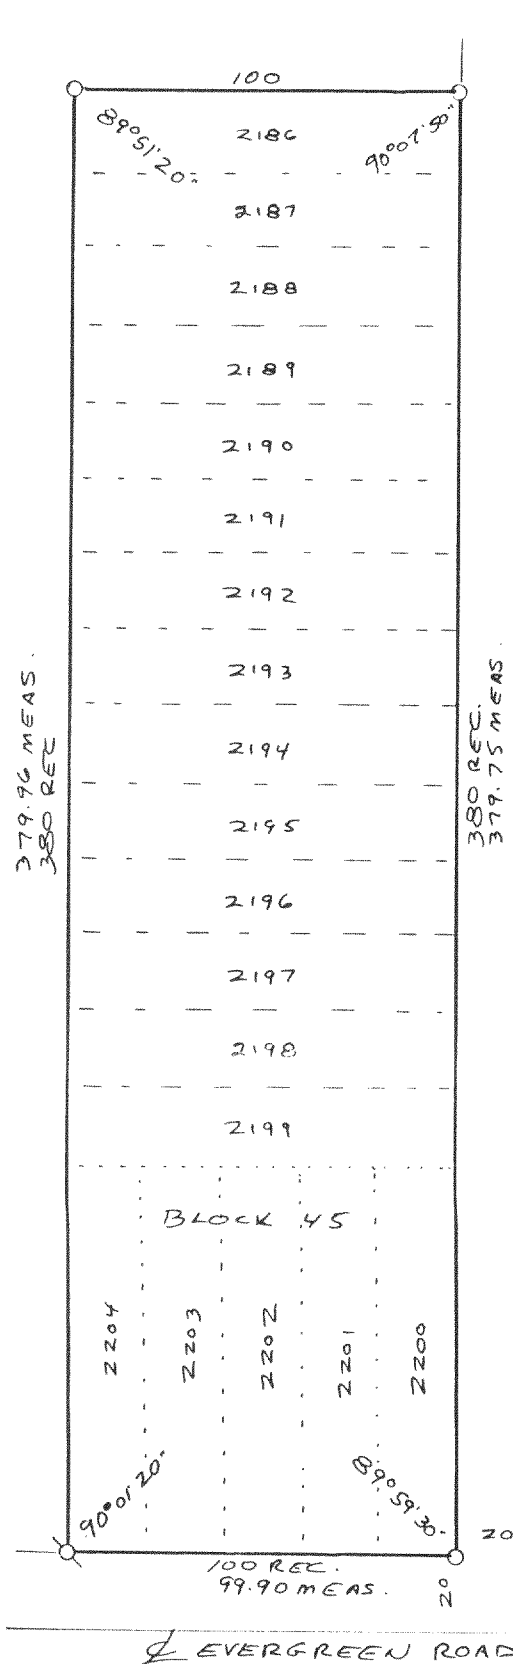

I have surveyed the above-described property, and the map hereon is a true representation thereof and shows the size and location of the property, its exterior boundaries, the location and dimensions of all visible structures thereon, fences, apparent easements and roadways and visible encroachments, if any.

This survey is made for the exclusive use of the present owners of the property, and also those who purchase, mortgage, or guarantee the title thereto, within one year from date hereof.

Dated at Burlington, this 2ND day, of APRIL, 1992.
John F. Degen
 John F. Degen, Land Surveyor S 242
 589 N. Pine St. Burlington, WI 53105