


Daisy Drive (50' Wide)

Camelia Road (40' Wide)

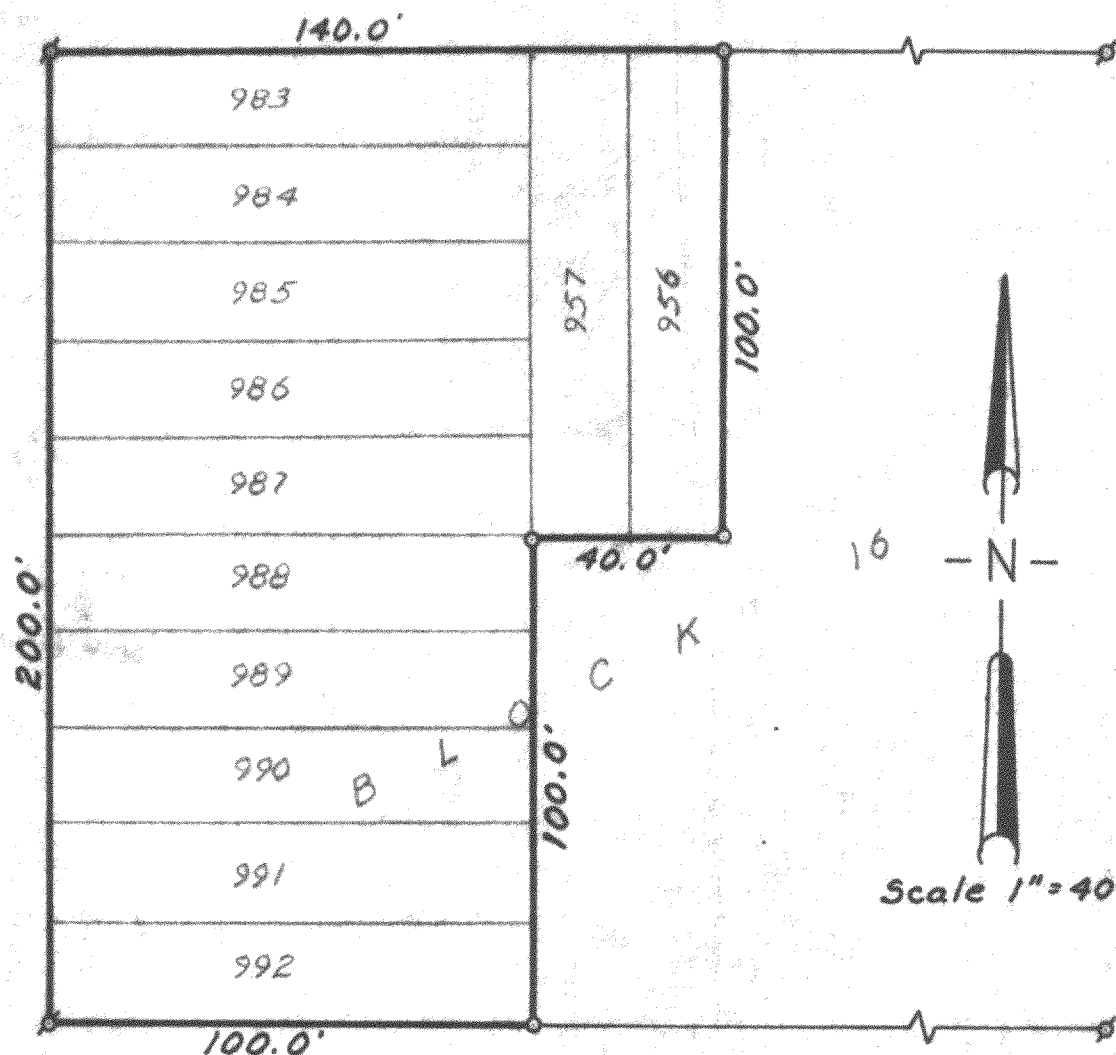

Primrose Road (40' Wide)

PLAT OF SURVEY OF
 Lots 956, 957 & 983-992, Block 16, Fell Lake
 Addition, located in the SW 1/4 of Section 14,
 T 1 N, R 18 E, Walworth County, Wisconsin.

Harold H. Kolb

Harold H. Kolb, Registered Land Surveyor, S-187
 Lake Geneva, Wisconsin

ø - Iron Pipe Found
 o - Iron Pipe Placed

6-22-62

118-784