

PLAT OF SURVEY
OF

LOT 21 AND THE EAST HALF OF LOT 20 IN BLOCK 6, OF ROSE NIPPERSINK GARDENS, A SUBDIVISION
LOCATED IN SECTION 24, T. 1 N, R. 18 E. OF THE 4TH P.M., TOWNSHIP OF BLOOMFIELD, COUNTY
OF WALWORTH, STATE OF WISCONSIN.

FOR: STUMPF

SCALE 1" = 40'

o = IRON PIPE STAKE SET.

✓ = IRON PIPE STAKE FOUND.



BEARINGS RELATE TO RECORDED
PLAT DATUM..

NOTE: TERM "HALF" IN TITLE
DESCRIPTION WAS SURVEYED AS
HALF AREA.

I have surveyed the above-described property,
and the map hereon is a true representation
thereof and shows the size and location of the
property, its exterior boundaries, the location
and dimensions of all visible structures thereon,
fences, apparent easements and roadways and
visible encroachments, if any

This survey is made for the exclusive use of
the present owners of the property, and also
those who purchase, mortgage, or guarantee
the title thereto, within one year from date
hereof.

Dated at Burlington, this 23rd day,
of SEPT, 1992
John F. Degen
John F. Degen, Land Surveyor S 242
589 N. Pine St. Burlington, WI 53105

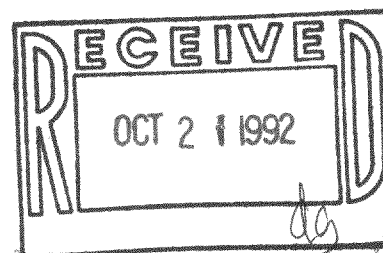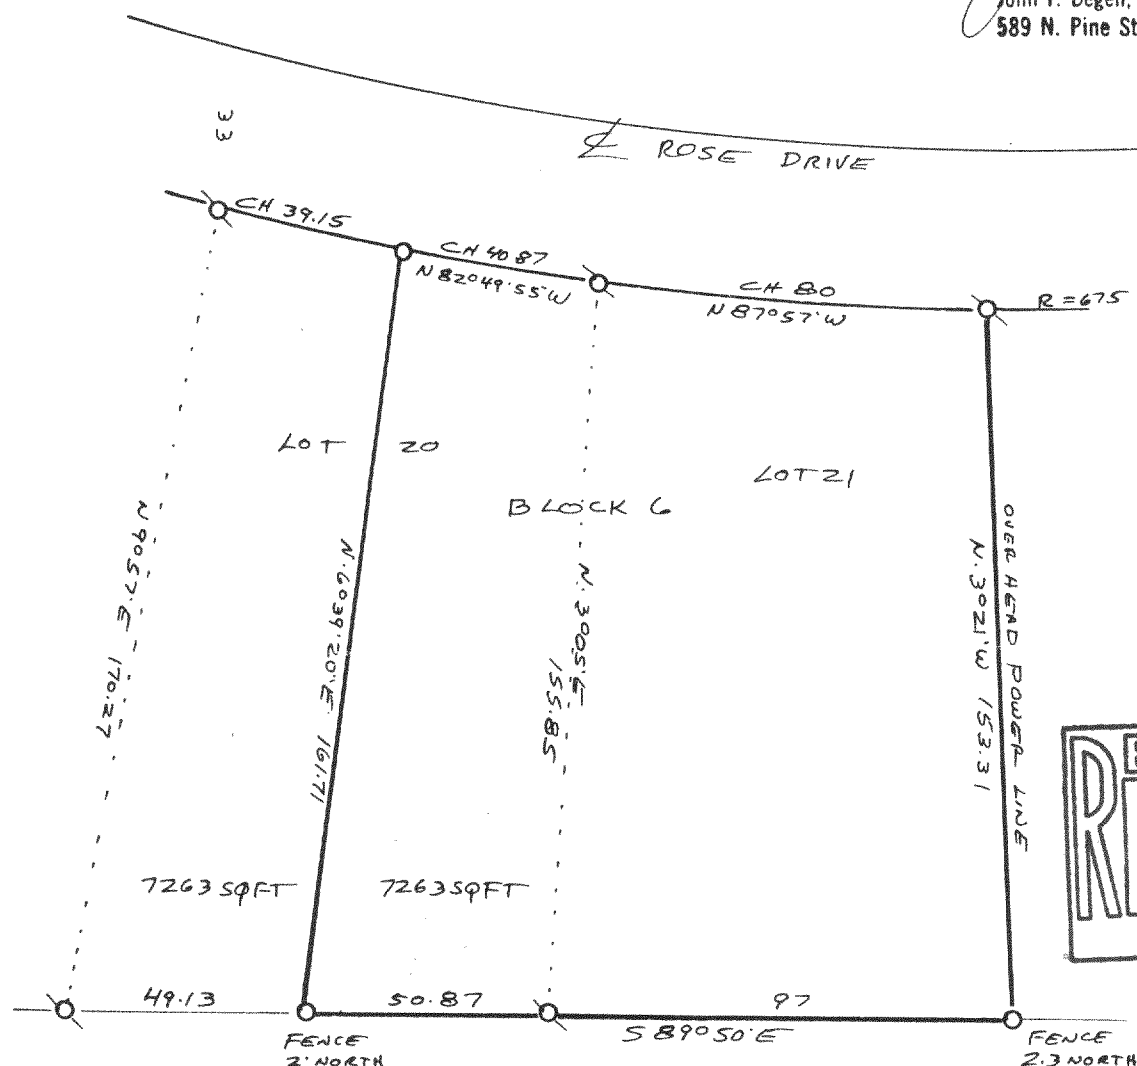

118-1066

16-11 H 12
MRNG-68