
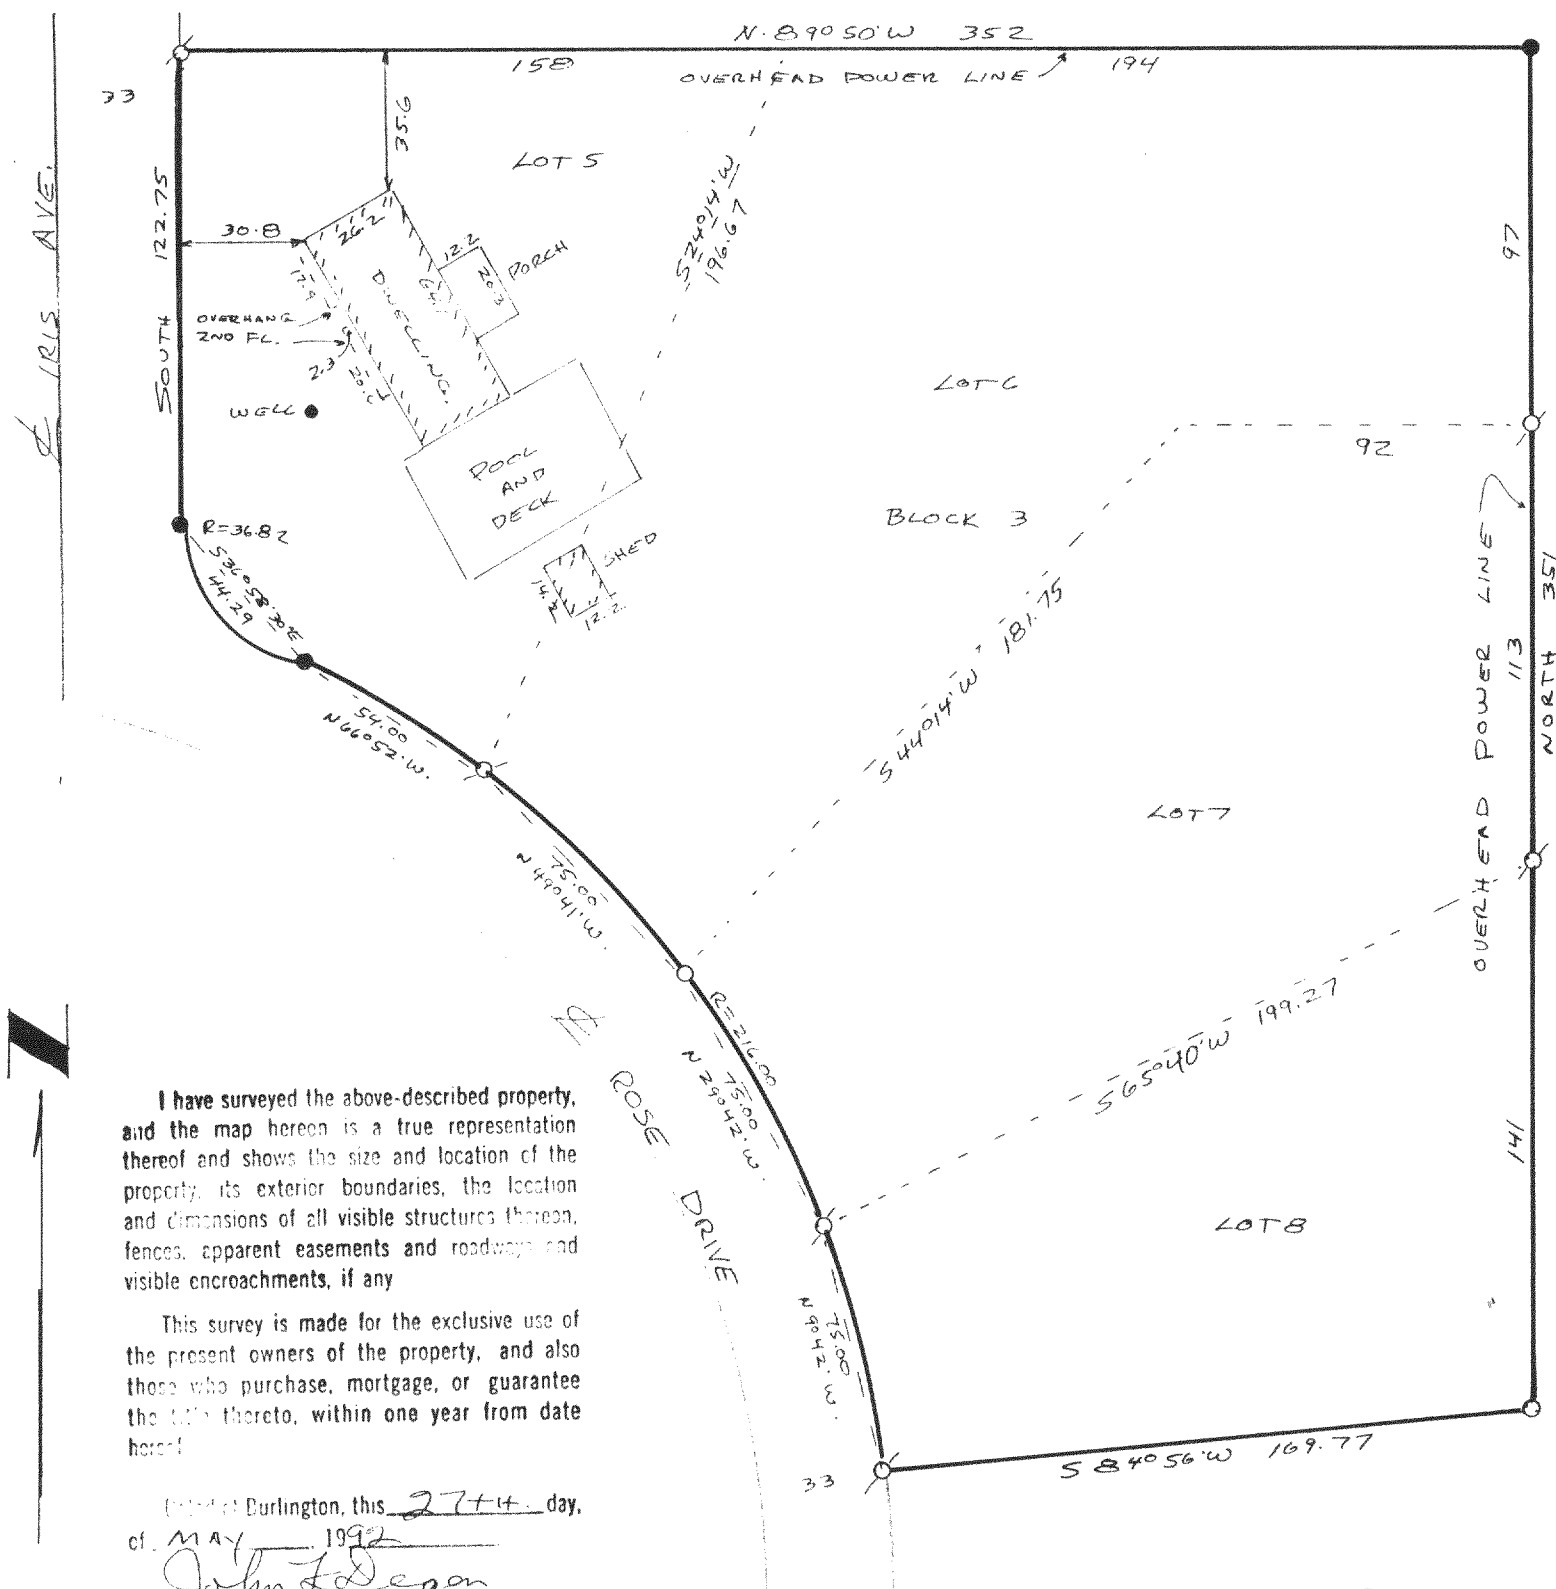


LOTS 5,6,7 & 8, IN BLOCK 3 OF ROSE NIPPERSINK GARDENS, A SUBDIVISION LOCATED IN THE SOUTHEAST 1/4 OF SECTION 24, T. 1 N., R. 18 E. OF THE 4TH P.M., TOWNSHIP OF BLOOMFIELD, COUNTY OF WALWORTH, STATE OF WISCONSIN.

O = IRON PIPE STAKE SET.

Ø = IRON PIPE STAKE FOUND

● = CONCRETE MONUMENT FOUND.

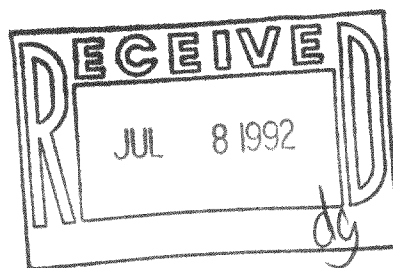

I have surveyed the above-described property, and the map hereon is a true representation thereof and shows the size and location of the property, its exterior boundaries, the location and dimensions of all visible structures thereon, fences, apparent easements and roadway and visible encroachments, if any

This survey is made for the exclusive use of the present owners of the property, and also those who purchase, mortgage, or guarantee the title thereto, within one year from date hereof.

Witnessed at Burlington, this 27th day,
of MAY, 1992

John F. Degen, Land Surveyor S 242
589 N. Pine St. Burlington, WI 53105

MRNG - 18
MRNG - 19
MRNG - 19A
MRNG - 20

118-1067