
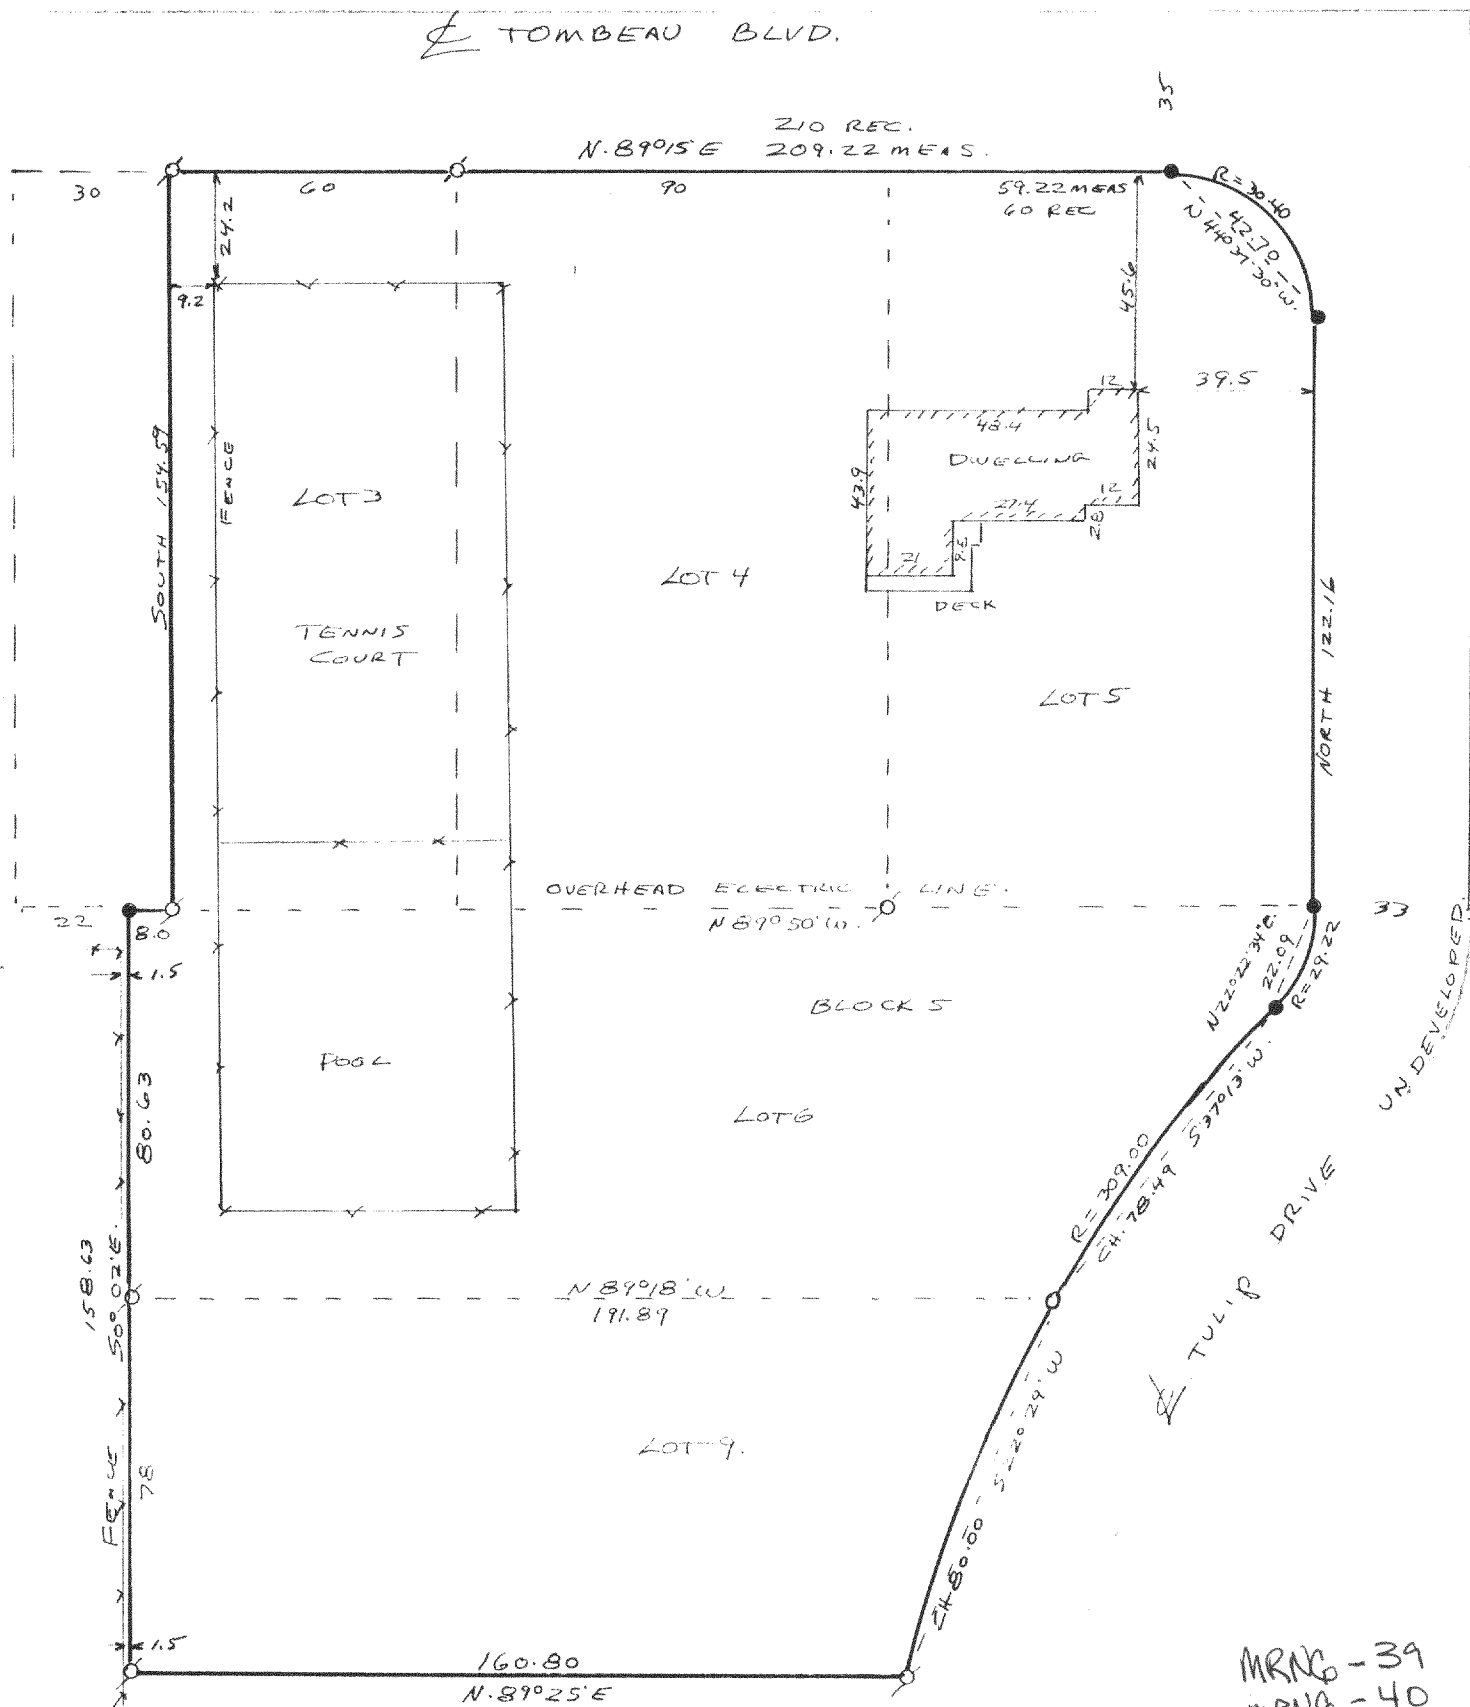


LOT 3 EXCEPT WEST 30 FEET, ALL OF LOTS 4, 5, 6 & 9, IN BLOCK 5 OF ROSE NIPPERSINK GARDENS, LOCATED IN THE SOUTHEAST 1/4 OF SECTION 24, T. 1 N., R. 18 E. OF THE 4TH P.M., TOWNSHIP OF BLOOMFIELD, COUNTY OF WALWORTH, STATE OF WISCONSIN.

This survey is made for the exclusive use of the present owners of the property, and also those who purchase, mortgage, or guarantee the title thereto, within one year from date hereof.

~~X~~---X---X DENOTES FENCE.

John F. Degen
John F. Degen, Land Surveyor S 242
589 N. Pine St. Burlington, WI 53105

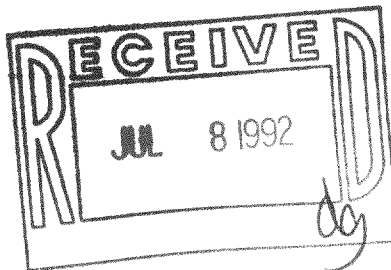

MRNG - 39
MRNG - 40
MRNG - 41
MRNG - 44

118-1068