
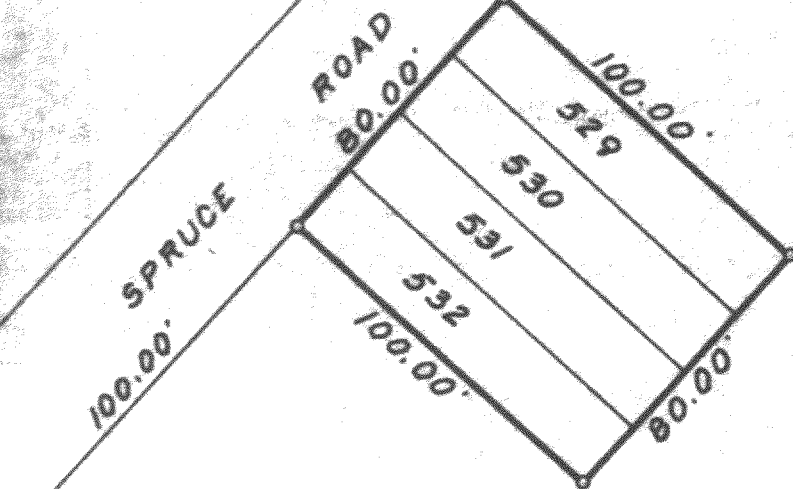


HAROLD H. KOLB
REGISTERED PROFESSIONAL LAND SURVEYOR
LAKE GENEVA, WISCONSIN

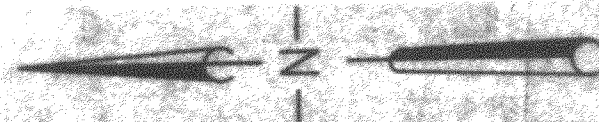

B L O C K 10

WEST POST ROAD

WALNUT ROAD

PLAT OF SURVEY OF
Lots 529-532, Block 10, Pell
Lake Subdivision, Walworth
County, Wisconsin.

Harold H. Kolb
Harold H. Kolb
Wisconsin Surveyor, S-187

Scale 1" = 50'

◊ - Iron Pipe Found
○ - Iron Pipe Placed

Sept. 1962

118-107