

HAROLD H. KOLB
REGISTERED PROFESSIONAL LAND SURVEYOR
LAKE GENEVA, WISCONSIN

WEST POST ROAD



PINE
140.00'

ROAD

BLOCK 15

180.00'
SPRUCE

ROAD

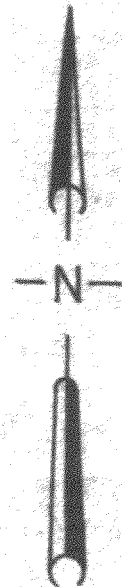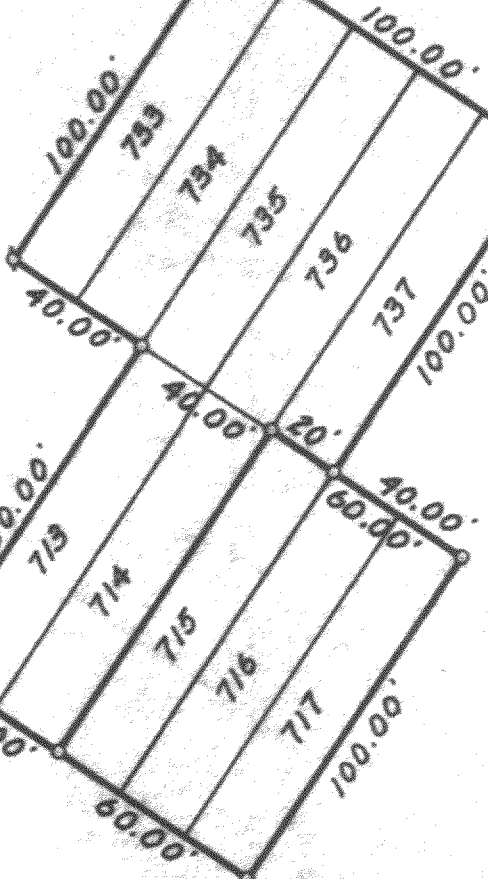

Scale 1"=50'

PLAT OF SURVEY OF
Lots 713-714, 715-717, 733-737,
Block 15, Pell Lake Subdivision,
Walworth County, Wisconsin.

Harold H. Kolb

Harold H. Kolb
Wisconsin Surveyor, S-187

◊ - Iron Pipe Found
○ - Iron Pipe Placed

9-10-62

118-108

1-18-30