
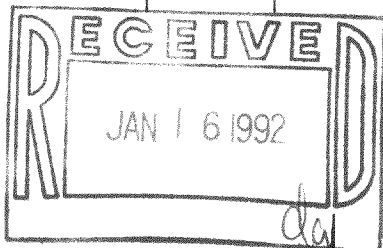


WALWORTH COUNTY SURVEYING & MAPPING

727 HENRY STREET
LAKE GENEVA, WISCONSIN
414-248-0505

MULBERRY DRIVE

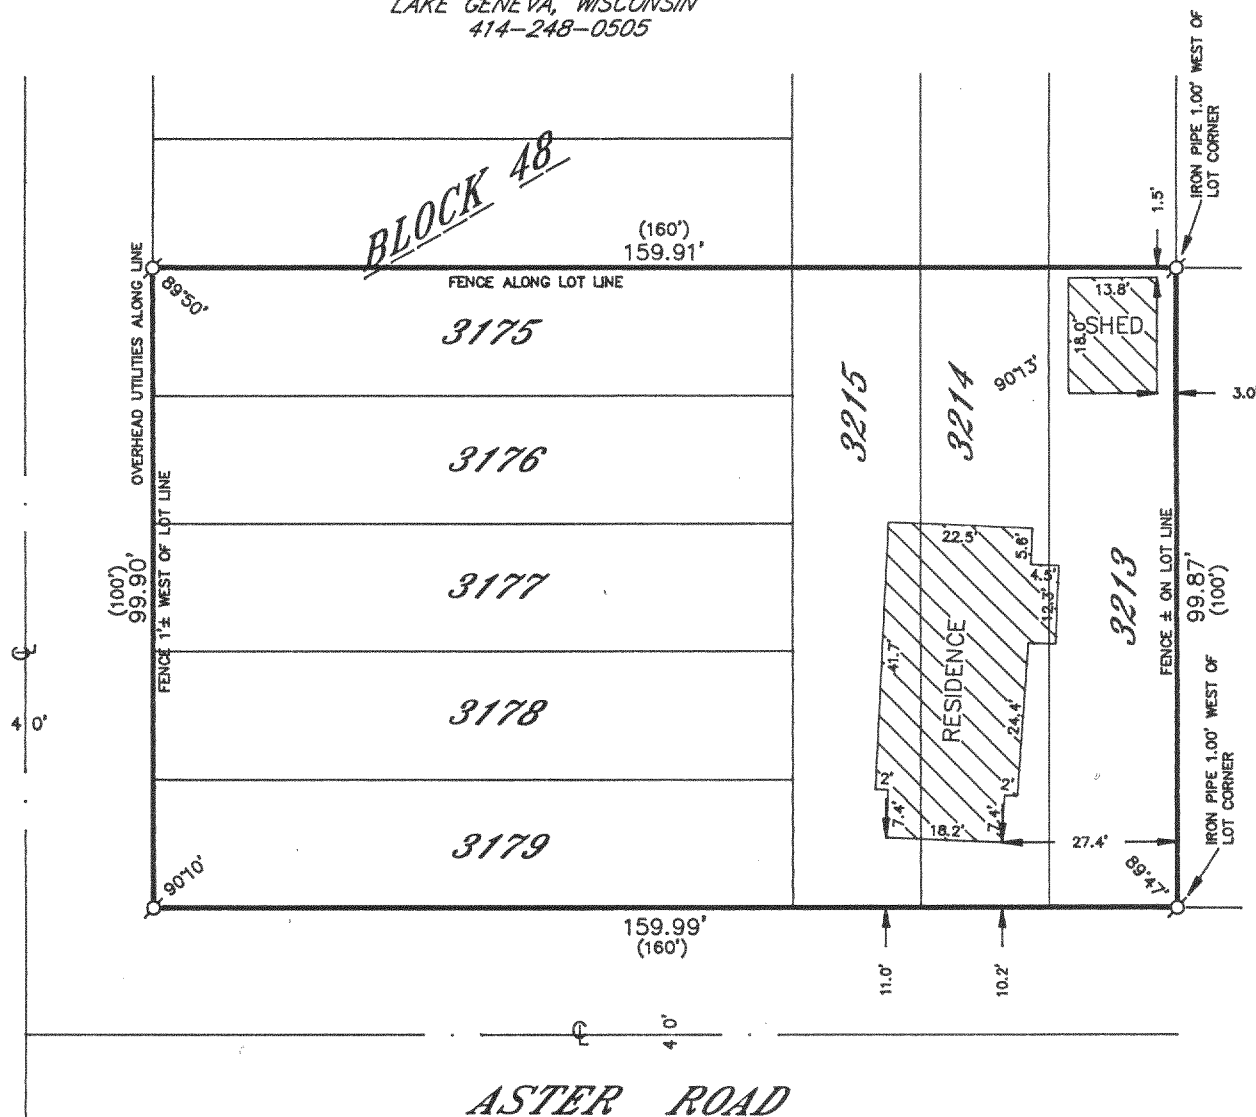

PLAT OF SURVEY OF

LOTS 3175-3179 AND LOTS 3213-3215, AS DESIGNATED AND
DELINEATED ON THE MAP ENTITLED "MAP OF SECTION TWO"
OF PELL LAKE, WALWORTH COUNTY, WISCONSIN, AND RECORDED
IN THE OFFICE OF THE REGISTER OF DEEDS IN AND FOR THE
COUNTY OF WALWORTH AND STATE OF WISCONSIN ON THE 16TH
DAY OF JULY, 1924.

ORDERED BY: REALTY WORLD-KEITH JOHNSON
P. O. BOX 727
TWIN LAKES, WISCONSIN
53181


I HEREBY CERTIFY THAT I HAVE SURVEYED THE ABOVE DESCRIBED
PROPERTY AND THAT THE ABOVE MAP IS A TRUE REPRESENTATION
THEREOF AND SHOWS THE SIZE AND LOCATION OF THE PROPERTY,
ITS EXTERIOR BOUNDARIES, THE LOCATION OF ALL VISIBLE STRUCTURES
AND DIMENSIONS OF ALL PRINCIPAL BUILDINGS THEREON, BOUNDARY
FENCES, APPARENT EASEMENTS, ROADWAYS AND VISIBLE ENCROACH-
MENTS, IF ANY, TO THE BEST OF MY KNOWLEDGE AND BELIEF.

THIS SURVEY IS MADE FOR THE USE OF THE PRESENT OWNERS OF
THE PROPERTY AND ALSO THOSE WHO PURCHASE, MORTGAGE OR
GUARANTEE THE TITLE THERETO WITHIN ONE (1) YEAR FROM DATE
HEREOF.

Robert M. Baerenwald
ROBERT M. BAERENWALD
WISCONSIN REGISTERED LAND SURVEYOR, S-1508

DATE *Oct. 13, 1990* JOB NO. 2718

NOTE: THIS IS NOT A CERTIFIED COPY UNLESS SEALED.

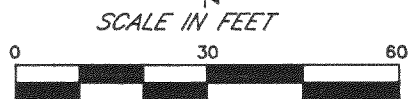

LEGEND
○-IRON PIPE FOUND
□-IRON ROD FOUND
■-CONCRETE MONUMENT FOUND
○-IRON PIPE PLACED
()-RECORDED AS

118-1103

MPL-662