


KOLB LAND CONSULTING, INC.
LAND SURVEYING • SUBDIVIDING • LAND PLANNING

929 WILLIAMS STREET


LAKE GENEVA, WISCONSIN 53147

414-248-3697

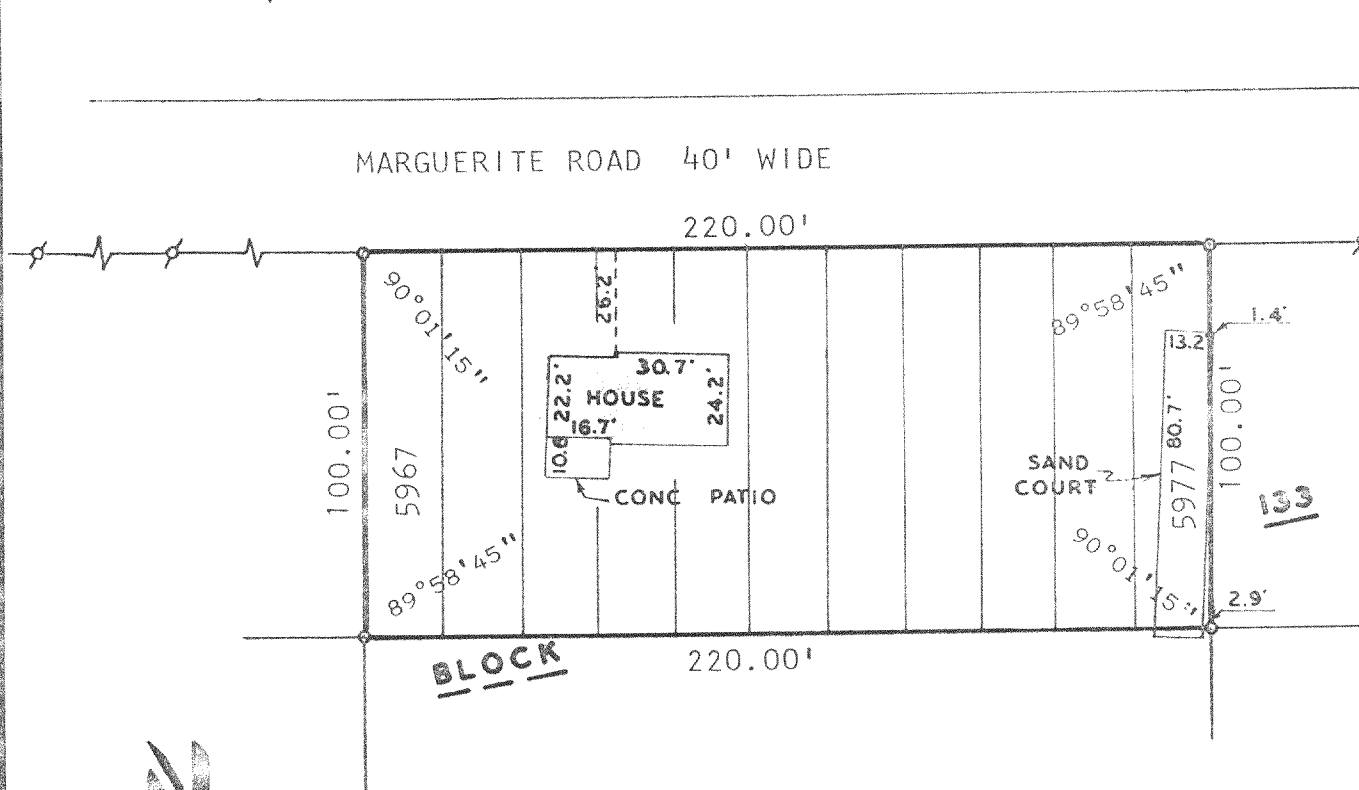

PLAT OF SURVEY OF

LOTS 5967-5977, BLOCK 133 OF PELL LAKE
SUBDIVISION, TOWN OF BLOOMFIELD, WALWORTH
COUNTY, WISCONSIN.

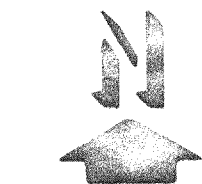


SCALE: 1"= 50'

LEGEND

- ♂ - IRON PIPE FOUND
- - IRON PIPE SET

ORDERED BY: EDWARD FRITZ
5630 SOUTH RUTHFORD
CHICAGO, IL. 60646

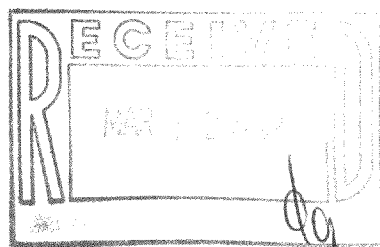

I, HAROLD H. KOLB, DO HEREBY CERTIFY
THAT I HAVE SURVEYED THE PROPERTY
HEREON DESCRIBED ACCORDING TO THE
OFFICIAL RECORDS AND THAT THE PLAT
HEREON IS A CORRECT REPRESENTATION
OF THE LOT LINES AND THE PRINCIPAL
LINES OF THE BUILDINGS, TO THE BEST
OF MY KNOWLEDGE AND BELIEF.
NOTE: SURVEY NOT VALID UNLESS SURVEYOR'S
SIGNATURE IS IN RED.

HAROLD H. KOLB

WISCONSIN REGISTERED LAND SURVEYOR, S- 187

DATE DECEMBER 4, 1990

REVISED

REVISED

118-1116

MPL-1296
MPL-1295
MPL-1297