
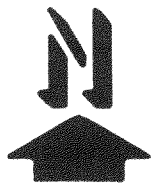


KOLB LAND CONSULTING, INC.
LAND SURVEYING - SUBDIVIDING - LAND PLANNING

929 WILLIAMS STREET LAKE GENEVA, WISCONSIN 53147 414 248 3697

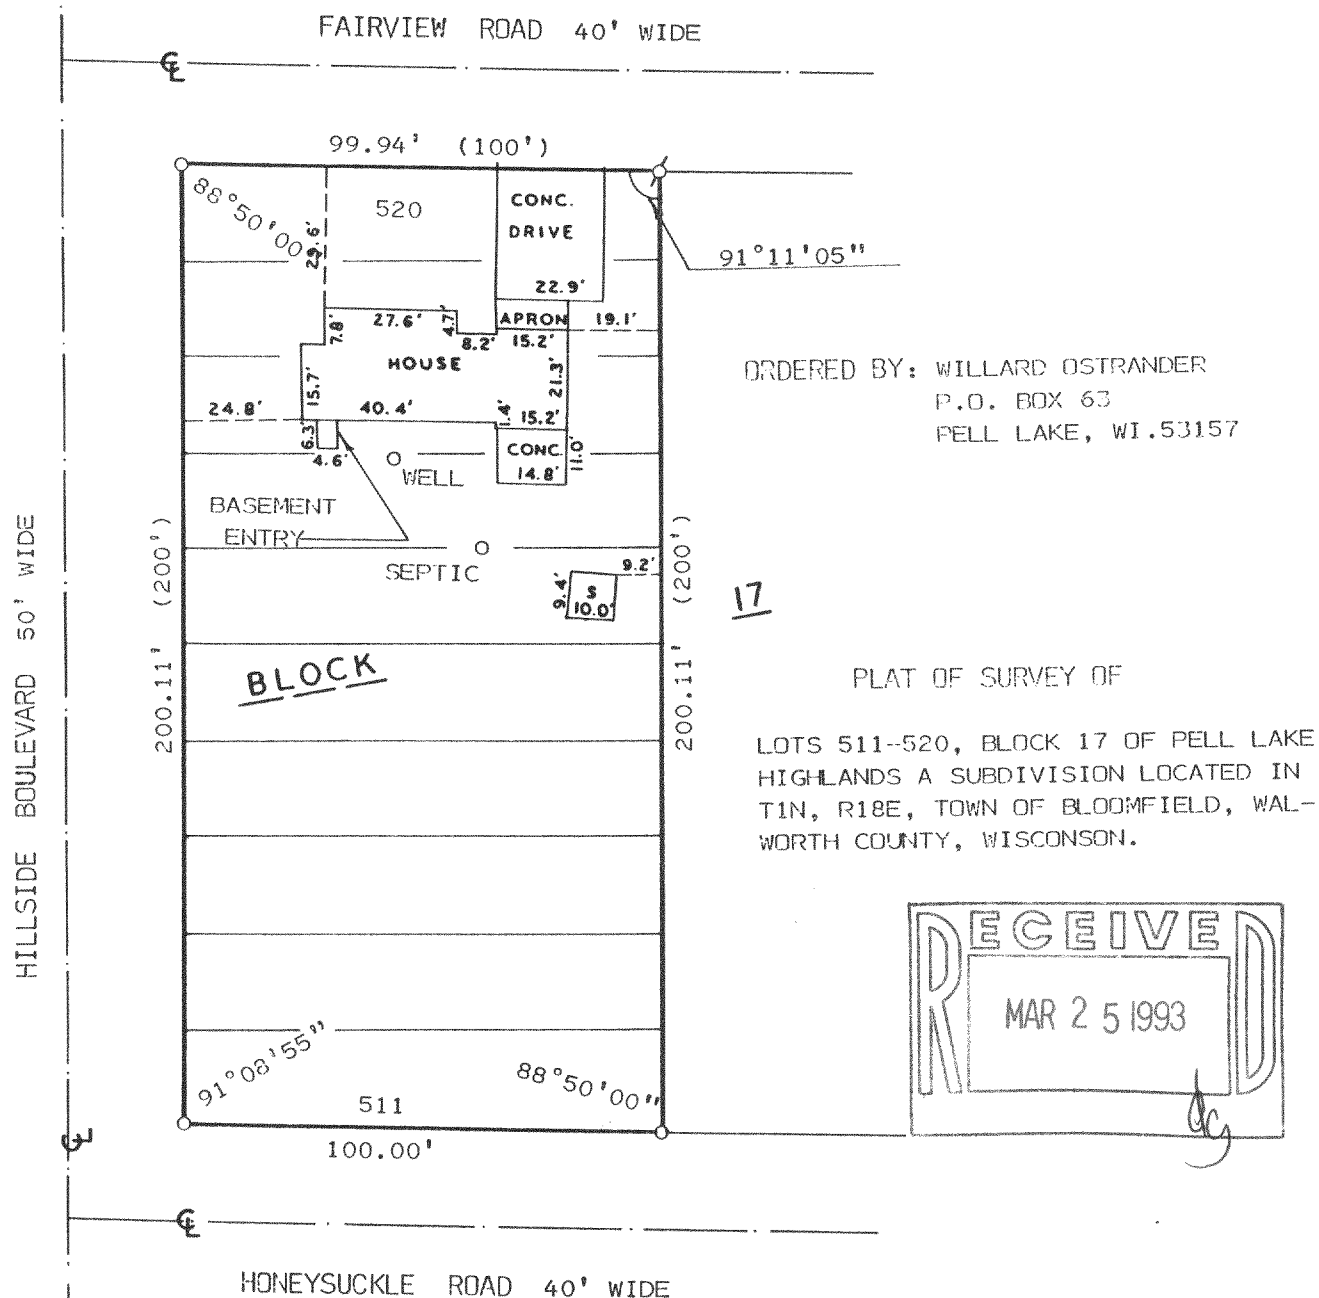

SCALE: 1" = 40'

LEGEND

- ⌀ -- IRON PIPE FOUND
- -- IRON PIPE SET
- () -- AS RECORDED
- S -- SHED

MPLH-113

I, HAROLD H. KOLB, DO HEREBY CERTIFY THAT I HAVE SURVEYED THE PROPERTY HEREON DESCRIBED ACCORDING TO THE OFFICIAL RECORDS AND THAT THE PLAT HEREON IS A CORRECT REPRESENTATION OF THE LOT LINES TO THE BEST OF MY KNOWLEDGE AND BELIEF.
SURVEY NOT VALID UNLESS SURVEYOR'S SIGNATURE IS IN RED.

HAROLD H. KOLB

WISCONSIN REGISTERED LAND SURVEYOR, S-187

DATE OCTOBER 2, 1992

REVISED

REVISED

118-1186