


HAROLD H. KOLB
REGISTERED PROFESSIONAL LAND SURVEYOR
LAKE GENEVA, WISCONSIN



Scale 1"=50'

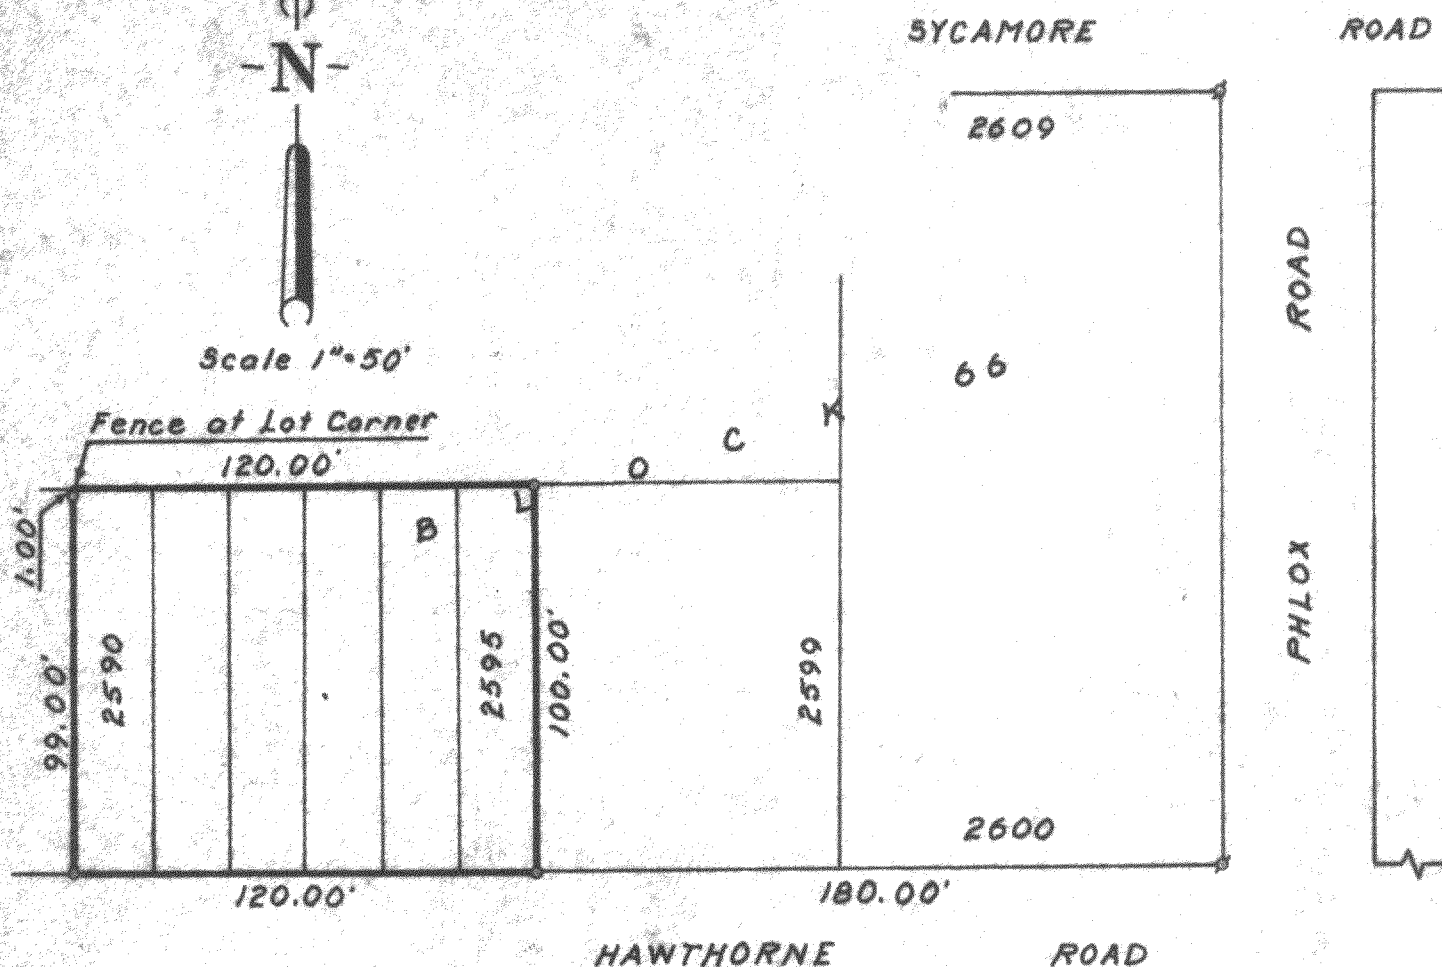

PLAT OF SURVEY OF

Lots 2590-2595, Block 66, Section 2 of
Pell Lake Subdivision, located in Section
22, T 1 N, R 18 E, Walworth County, Wis.

Harold H. Kolb

Harold H. Kolb, Wisconsin Surveyor, S-187
Date: June 5, 1963

g - Iron Pipe Found
o - Iron Pipe Placed

118-120