


DUMBAR DRIVE

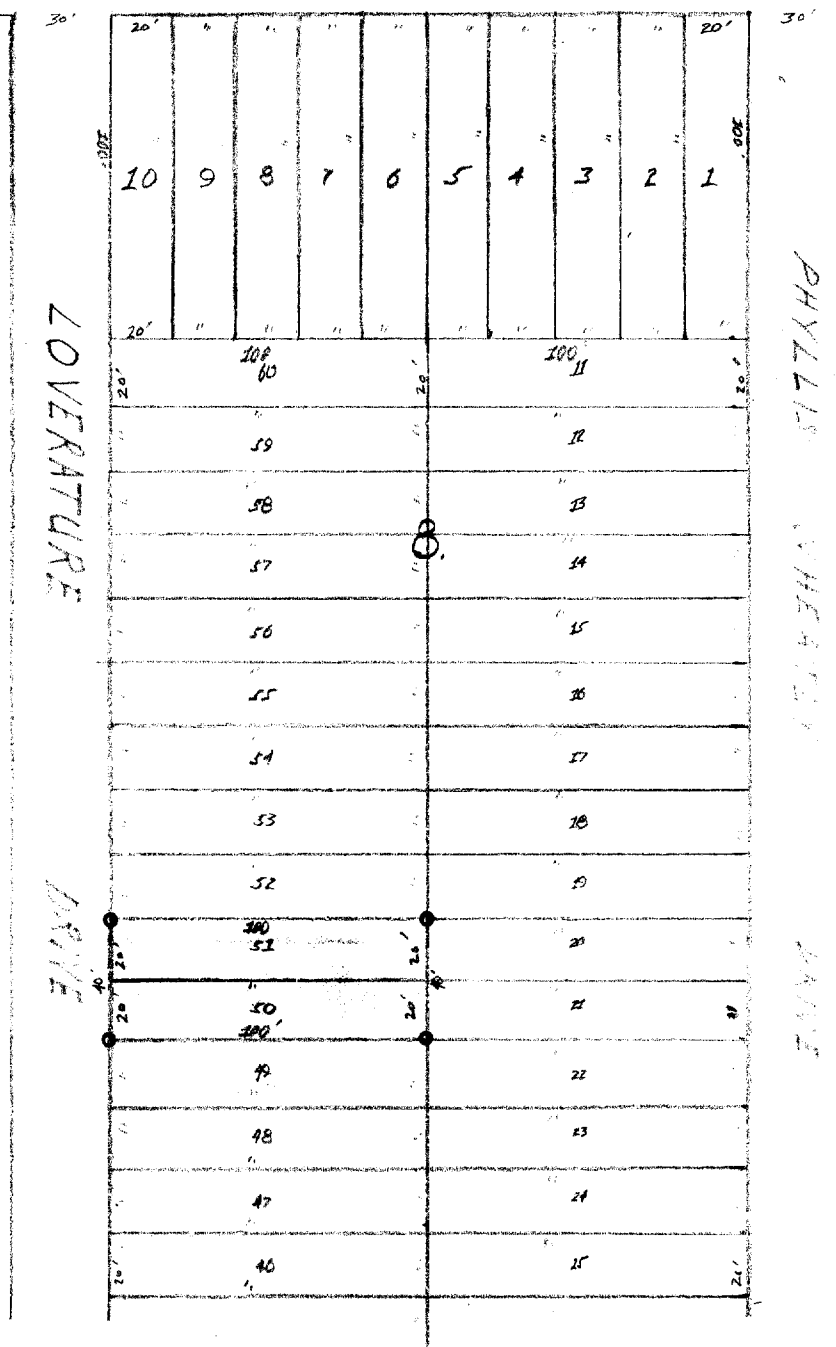

DESCRIPTION:

Lots 50 and 51, Block 8 Lake Ivanhoe Resort Subdivision of a portion of Section 34 Town 2 north Range 18 east of the 4th P.M., also parts of sections 2, and 3, Town 1 north, Range 18 east of the 4th P.M.

CERTIFICATE:

I, hereby certify that I have on this the 7th day of April, 1950 surveyed the above described property according to the official record on file in the office of the Recorder of Deeds in and for Walworth County Wisconsin, and find that the measurements and bearings of the boundary lines of said property as taken at the site on this day, substantially agree with those in said official record and that no encroachments exist

SIGNED AND SEALED ON THIS THE 8TH DAY OF APRIL 1950.

Joseph M. Biagi, Professional Engineer.
Elkhorn, Wisconsin.