


HAROLD H. KOLB
REGISTERED PROFESSIONAL LAND SURVEYOR
LAKE GENEVA, WISCONSIN

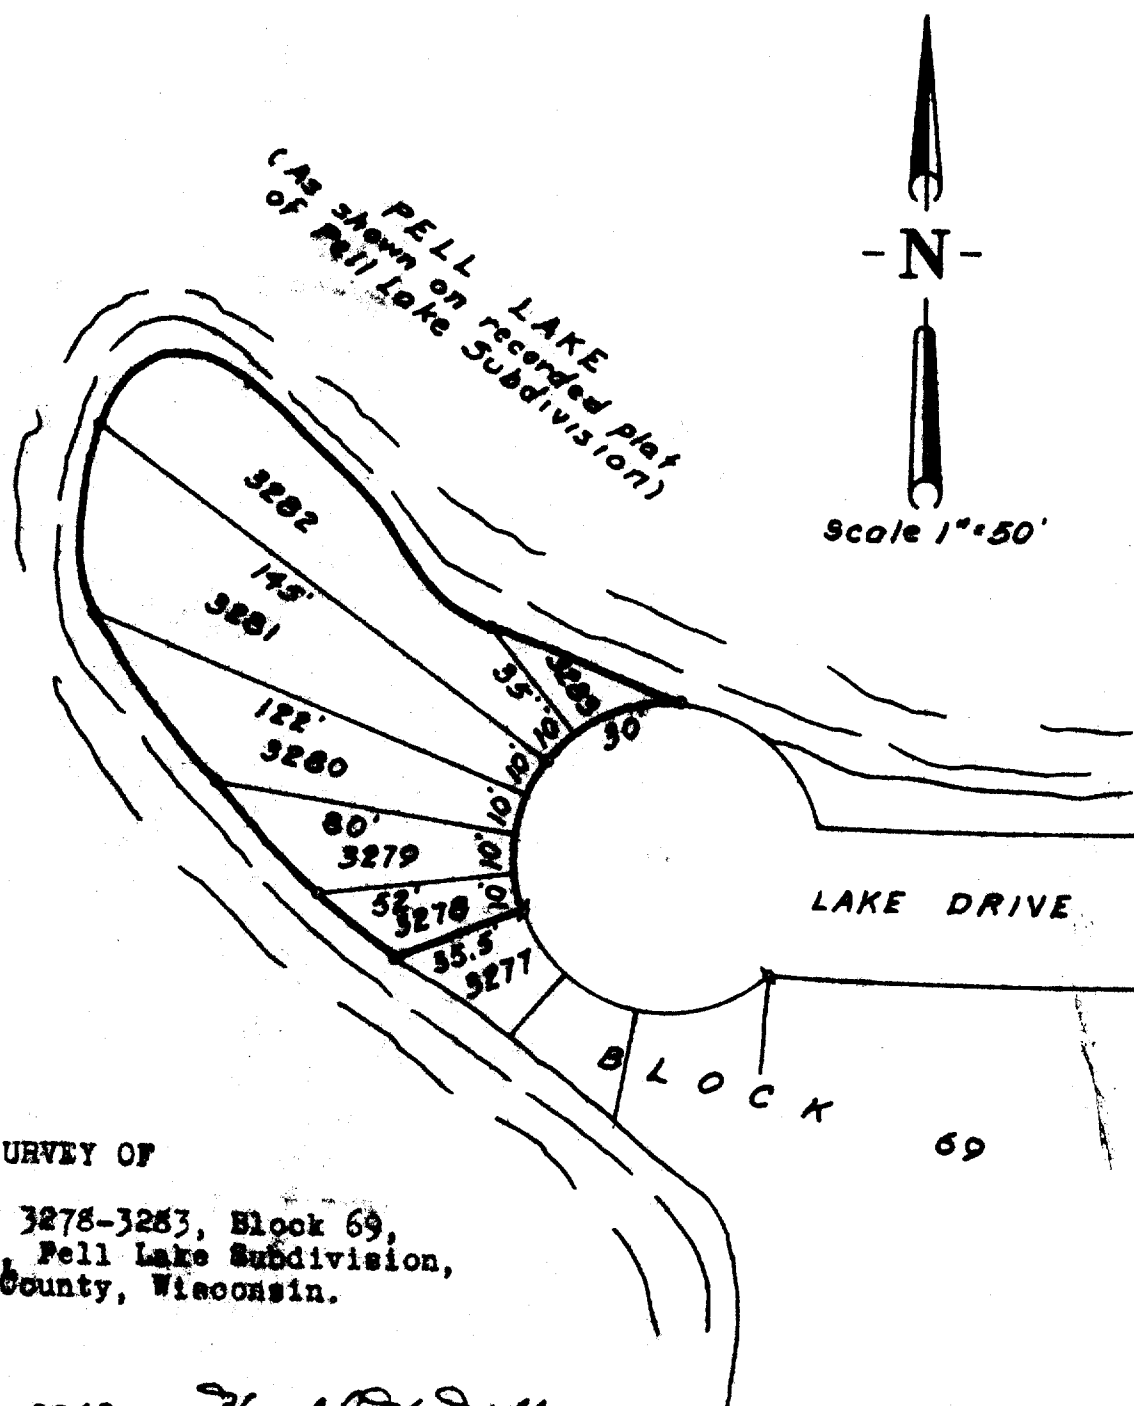

PLAT OF SURVEY OF

Lots 3278-3283, Block 69,
Section 2, Pell Lake Subdivision,
Walworth County, Wisconsin.

Date 6-24, 1963.

Harold H. Kolb

Harold H. Kolb, Wisconsin Surveyor, 8-187

* - Iron Pipe Found
• - Iron Pipe Placed

118-121

1-18 57-6