


KOLB LAND CONSULTING, INC.
LAND SURVEYING • SUBDIVIDING • LAND PLANNING

LAKE GENEVA, WISCONSIN 53147




414-248-3697

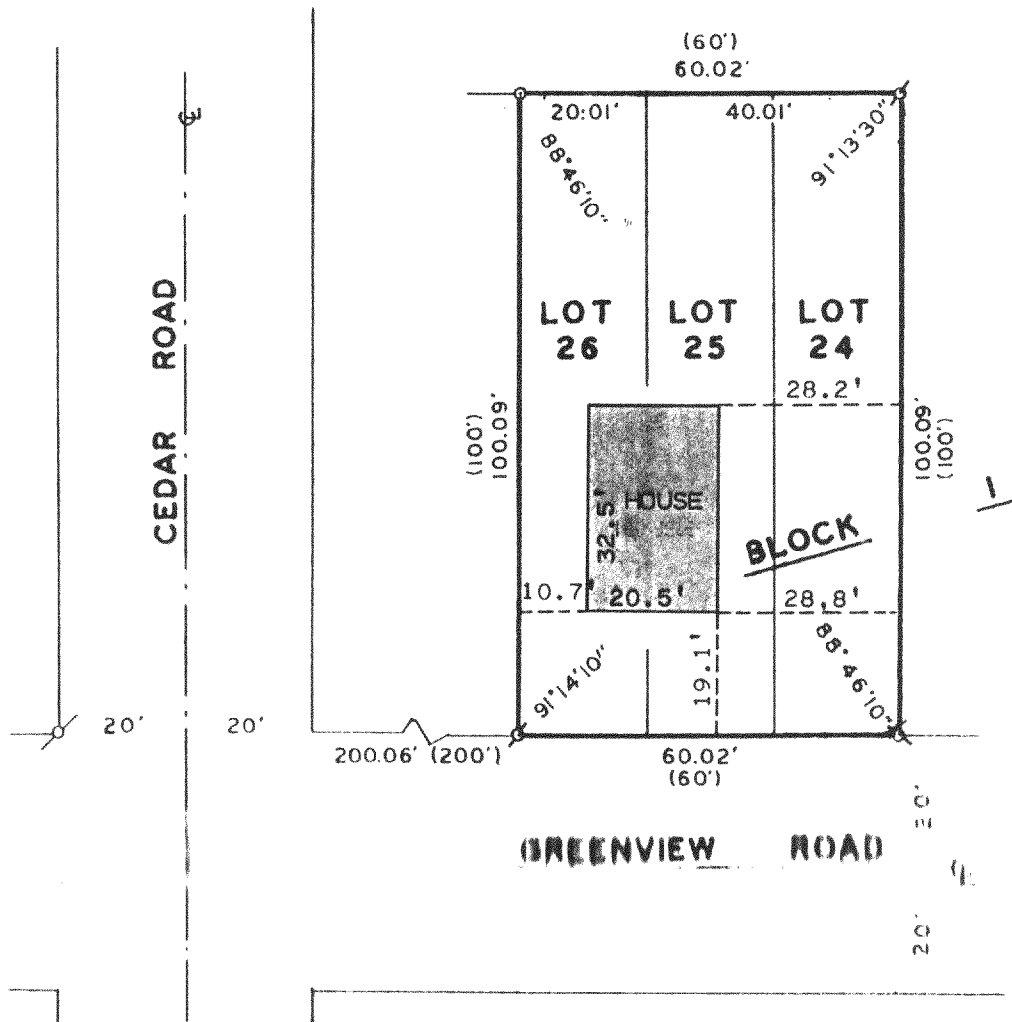

PLAT OF SURVEY OF

LOTS 24-26, BLOCK 1, PELL LAKE HIGHLANDS, T1N, R18E,
WALWORTH COUNTY, WISCONSIN.

ORDERED BY: TOWN OF WARD
FROM: HENRY CHARLES C.F.
PALATINE, IL. 60067

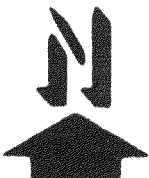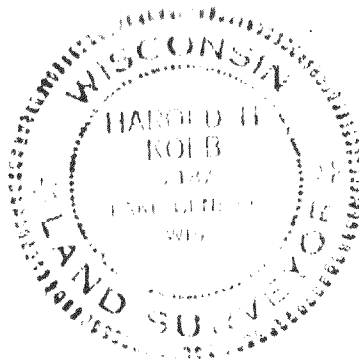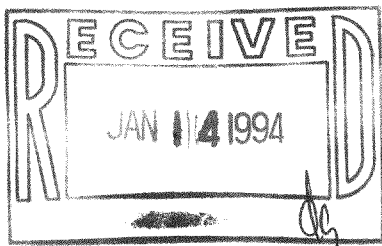

SCALE - 1"=30'

LEGEND
○ IRON PIPE FOUND
○ IRON PIPE SET
() RECORDED AS

I, HAROLD H. KOLB, DO HEREBY CERTIFY
THAT I HAVE SURVEYED THE PROPERTY
HEREON DESCRIBED ACCORDING TO THE
OFFICIAL RECORDS, AND THAT THE PLAT
HEREON IS A CORRECT REPRESENTATION
OF THE LOT LINES TO THE BEST OF MY
KNOWLEDGE AND BELIEF. SURVEY NOT VALID
UNLESS SURVEYOR'S SIGNATURE IS IN RED.

HAROLD H. KOLB
WISCONSIN REGISTERED LAND SURVEYOR, S- 187
DATE SEPTEMBER 10, 1993

MPLH-6

1-18 - MPLH 7, 11 & 12
118-1271