


HAWTHORNE ROAD

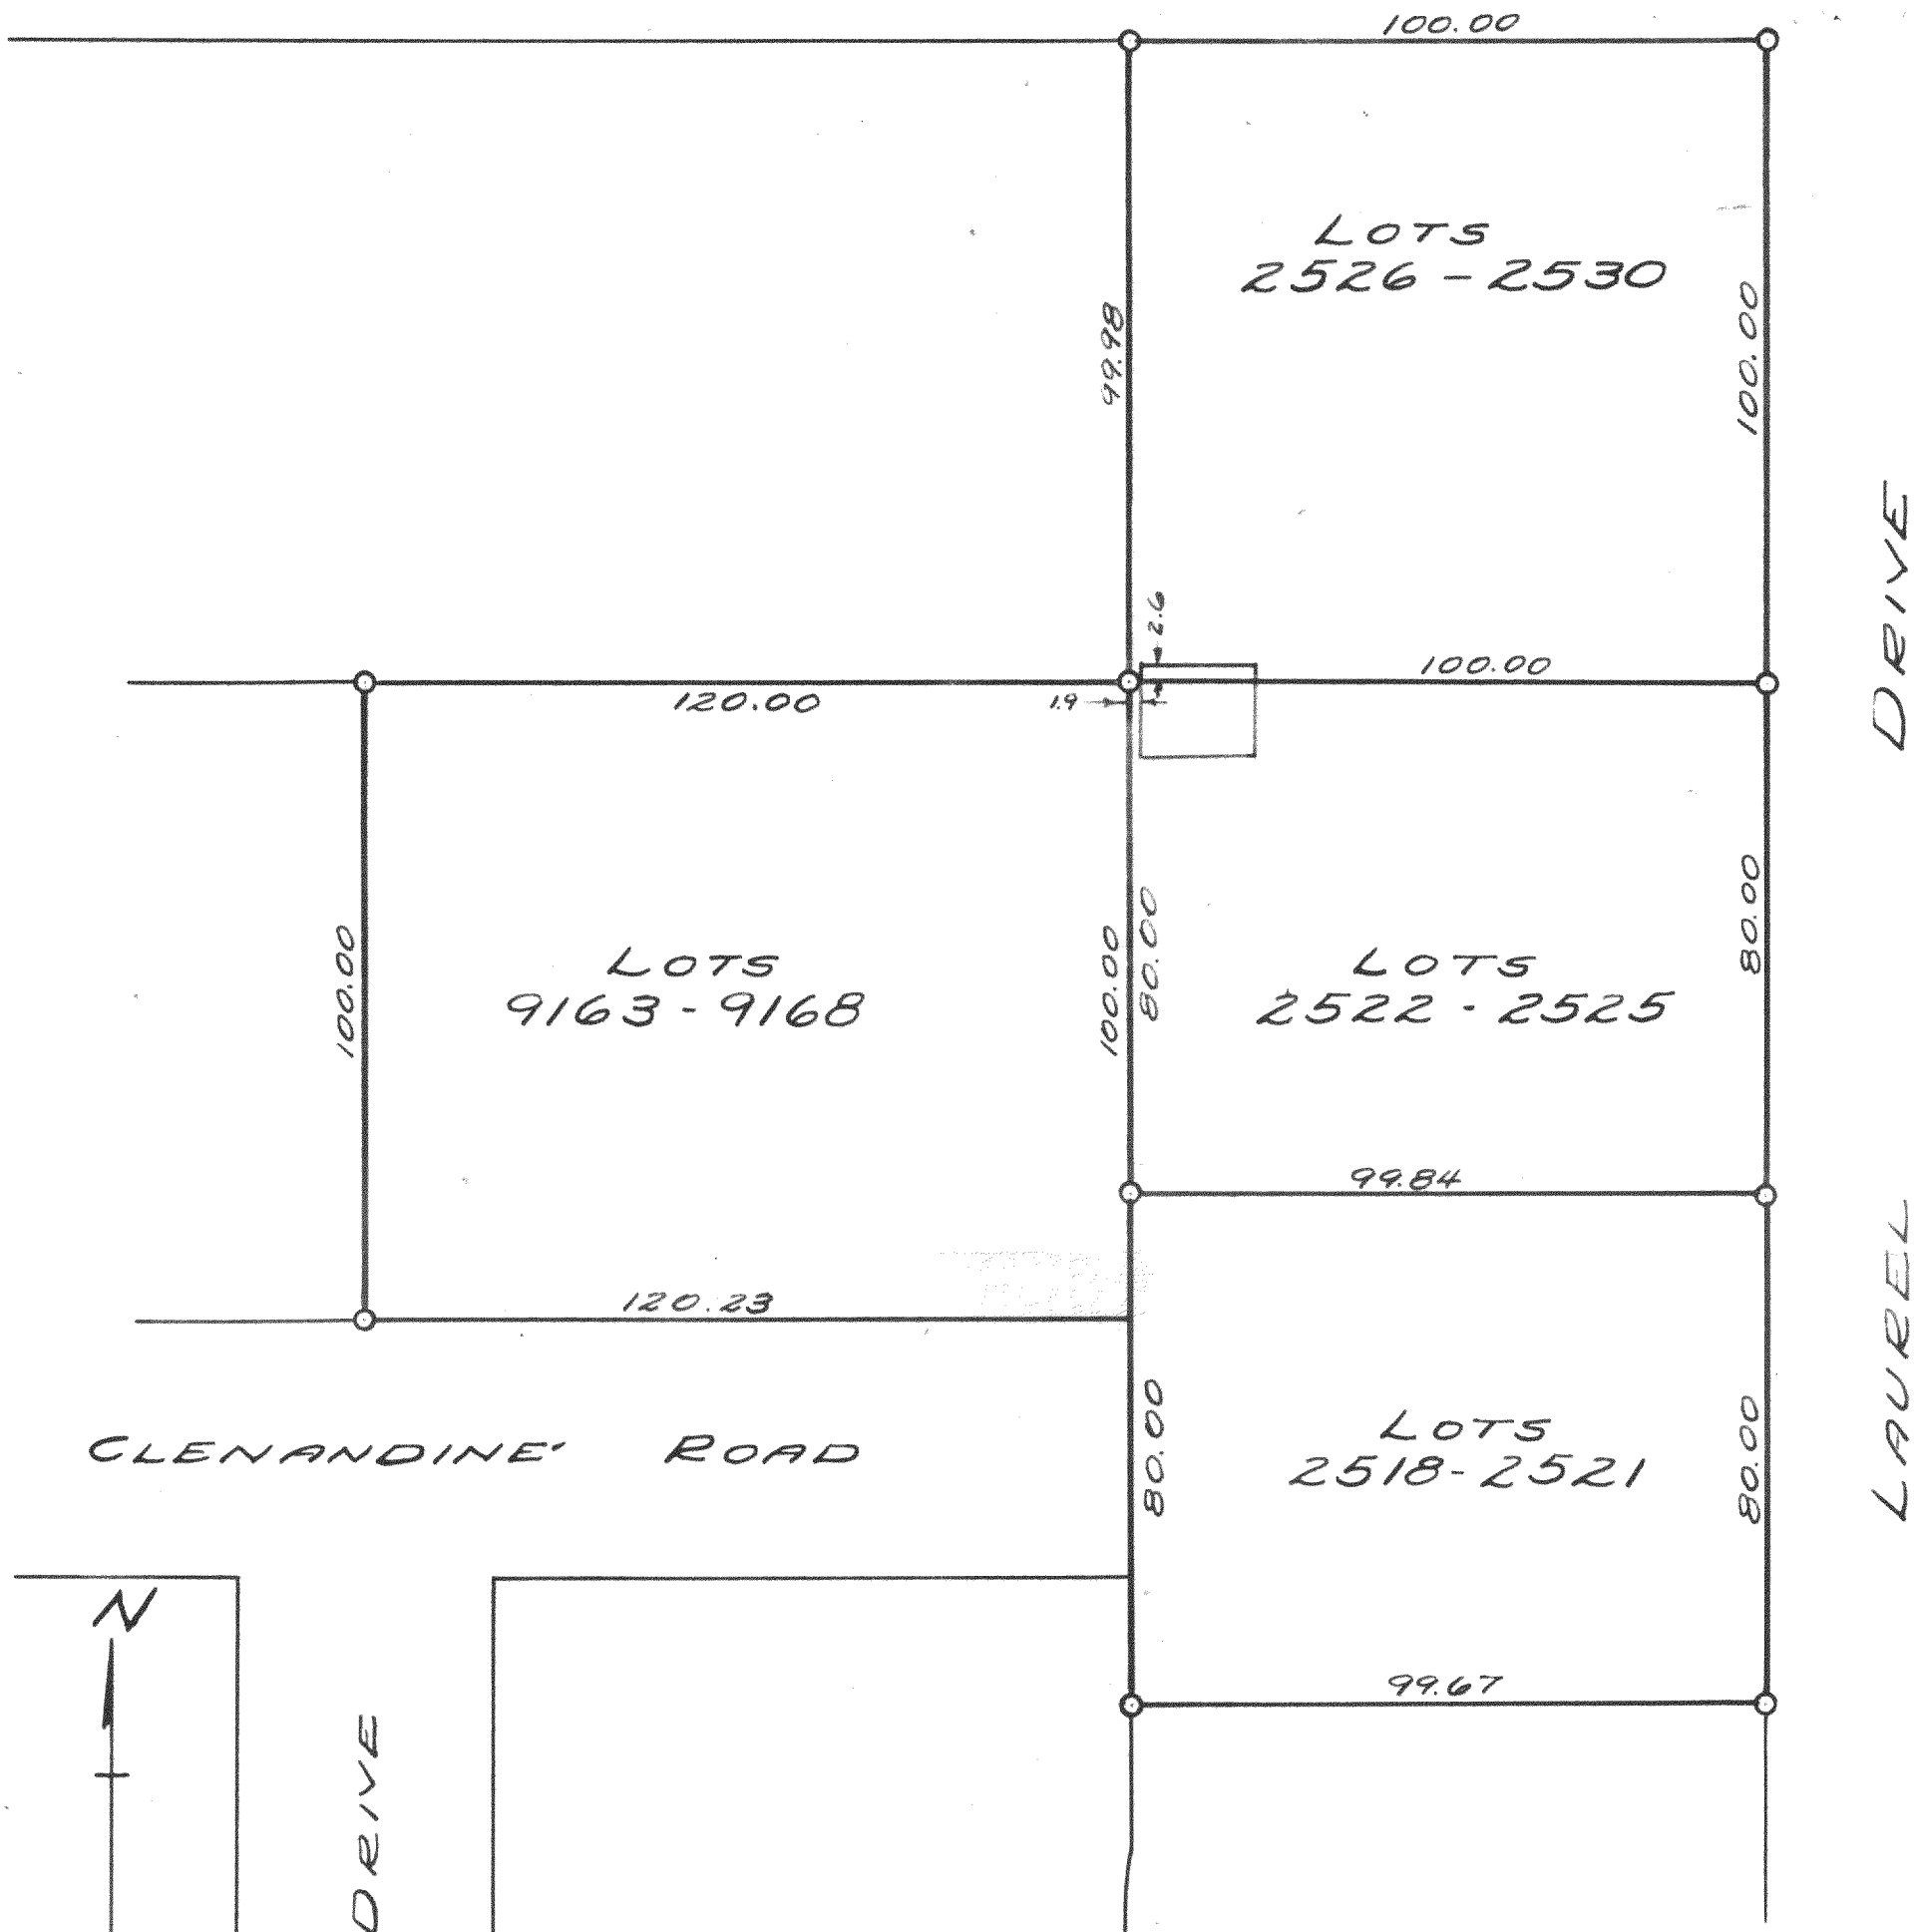

N

PHLOX DRIVE

LAUREL DRIVE

CLENANDINE ROAD

SCALE 1"=30'
O = IRON PIPE

PLAT OF SURVEY OF LOTS 2518-2530 OF SECTION 2 AND LOTS 9163-9168 OF SECTION 5 OF PELL LAKE SUBDIVISION, WALWORTH COUNTY, WISCONSIN.

OCTOBER, 1946

Lloyd L. Jensen
- COUNTY SURVEYOR - 118-13.1